


PETER SPEICHER

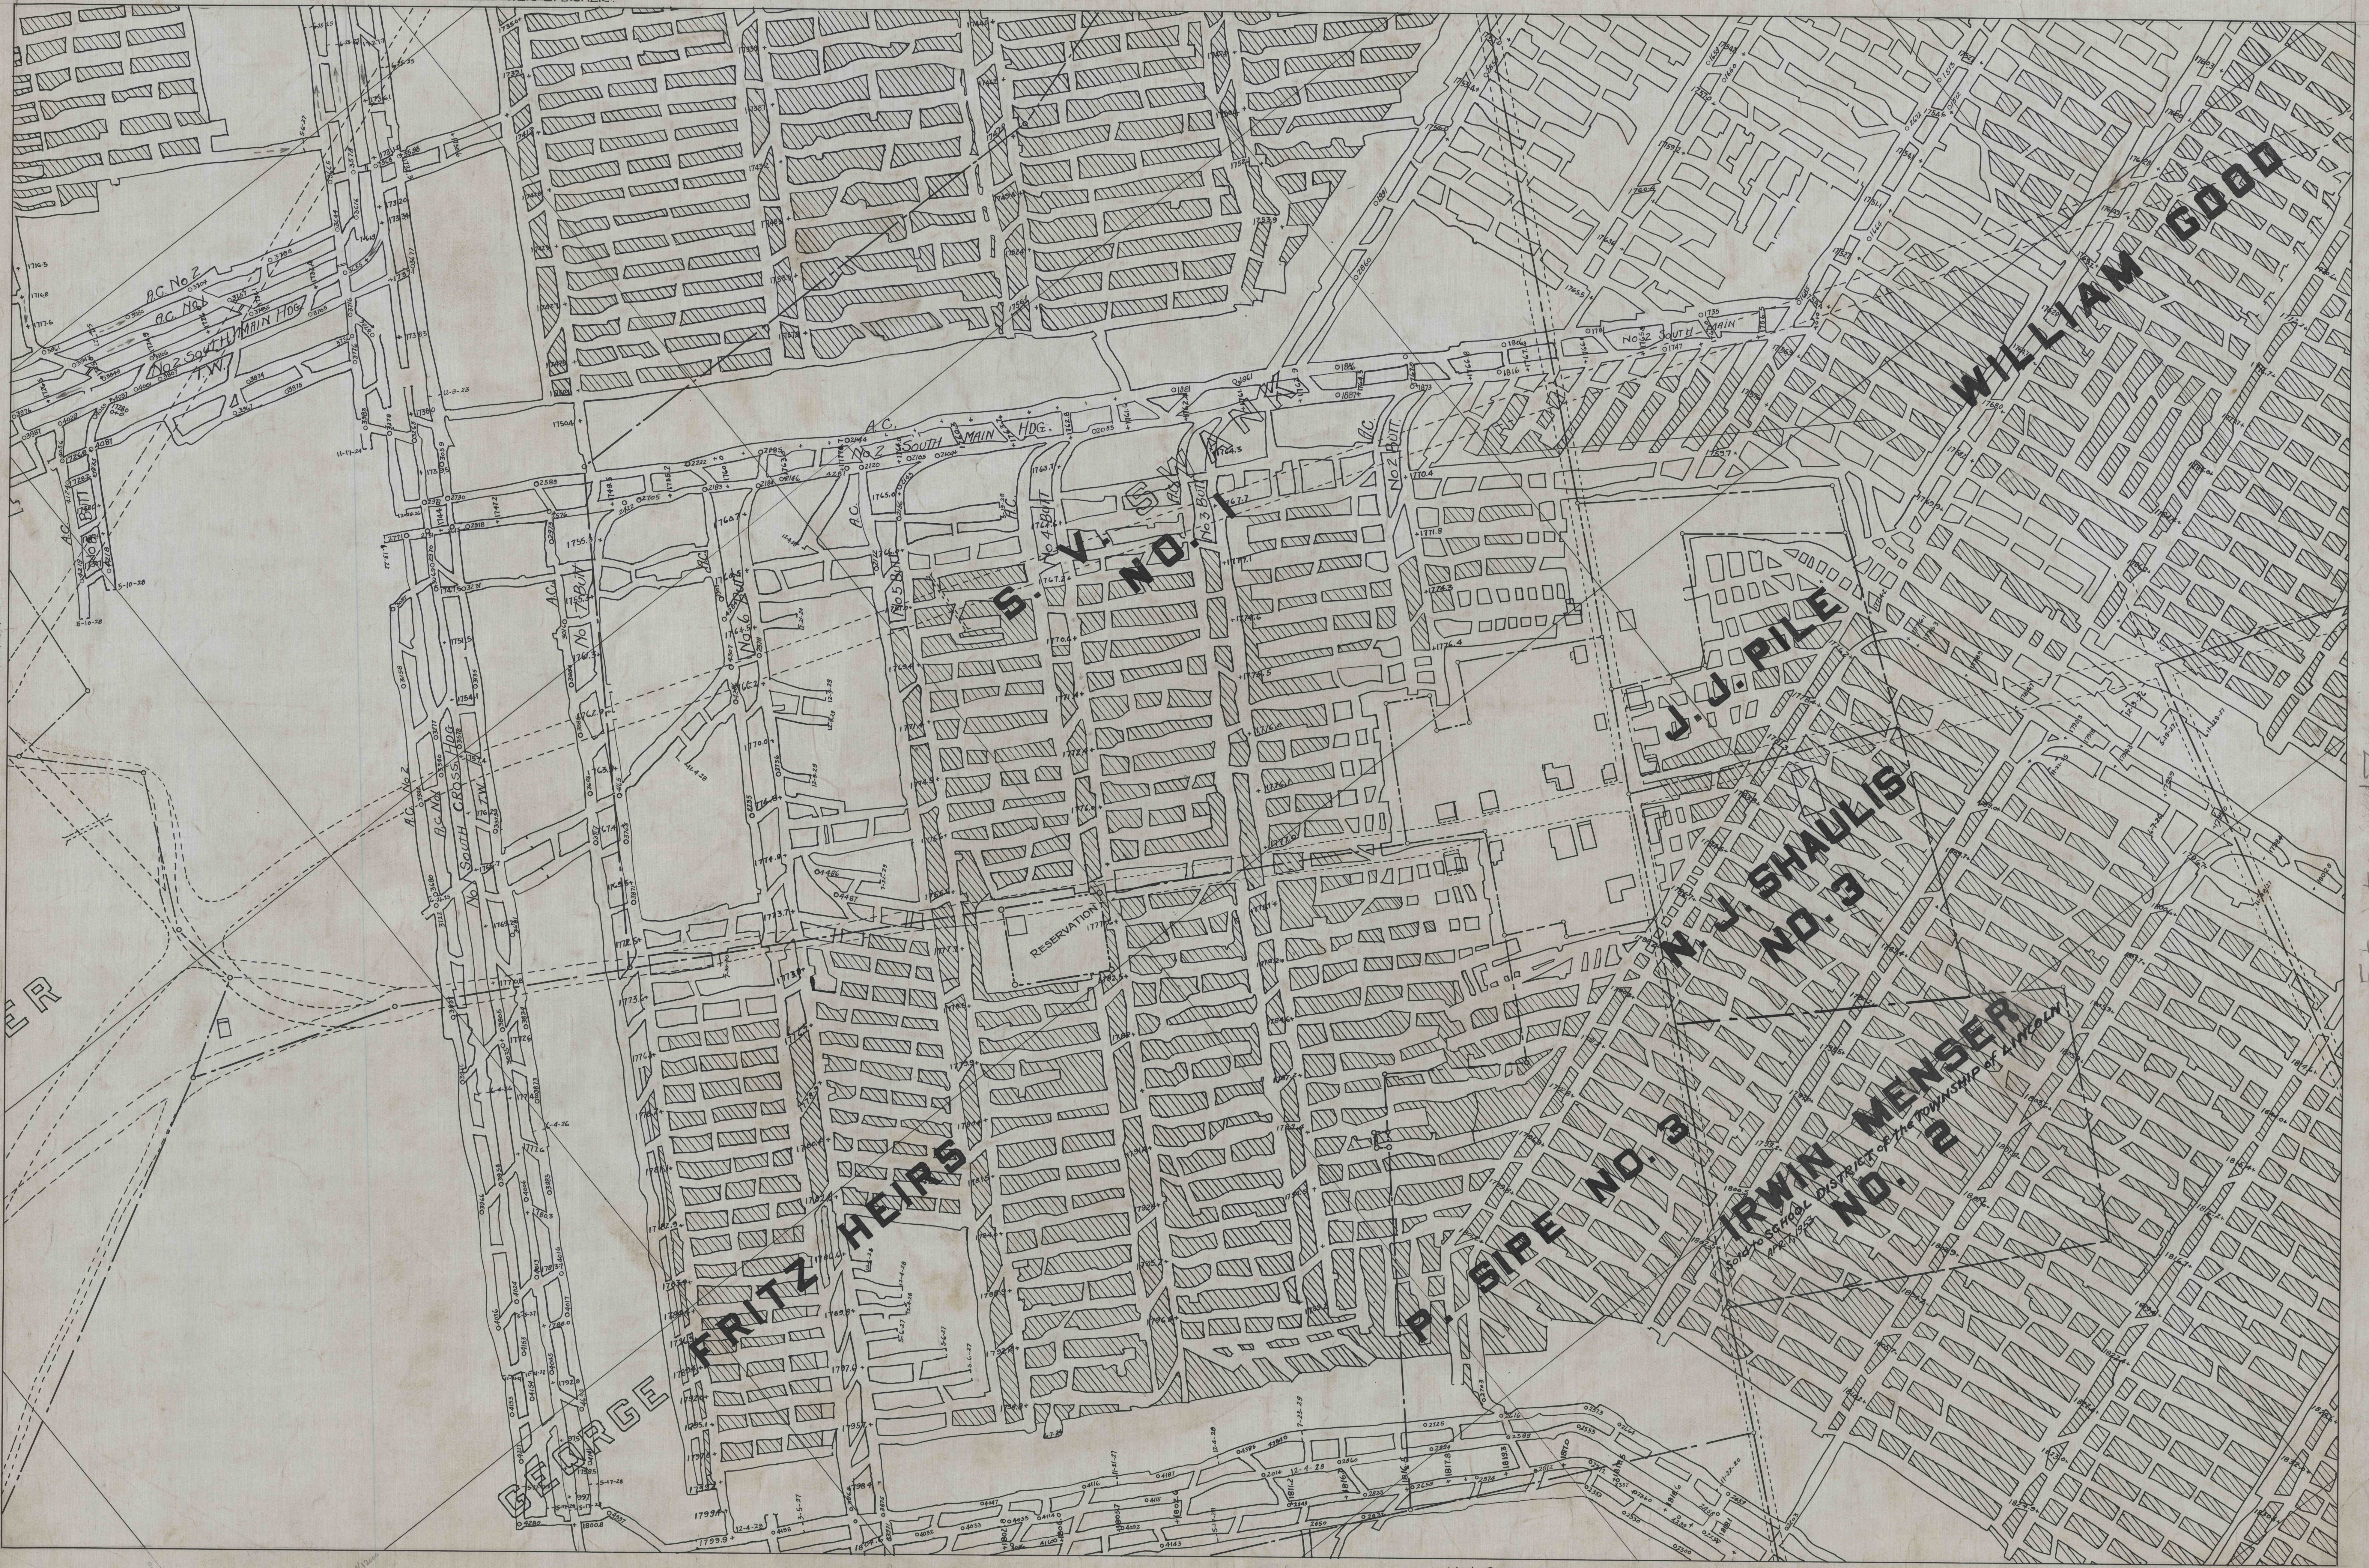

RESERVATION

S. C. BAKER

N. J. SHAULIS No 2

WILLIAM GOOD

MINE 120° C \* 16

No 2 South Main  
No 1 South Cross  
3 B. Panel.