


CROW COAL  
AND  
PRESENT WORKINGS  
OF  
VESTA N° IMINE

SCALE 1/2" = 100 FT. 1904

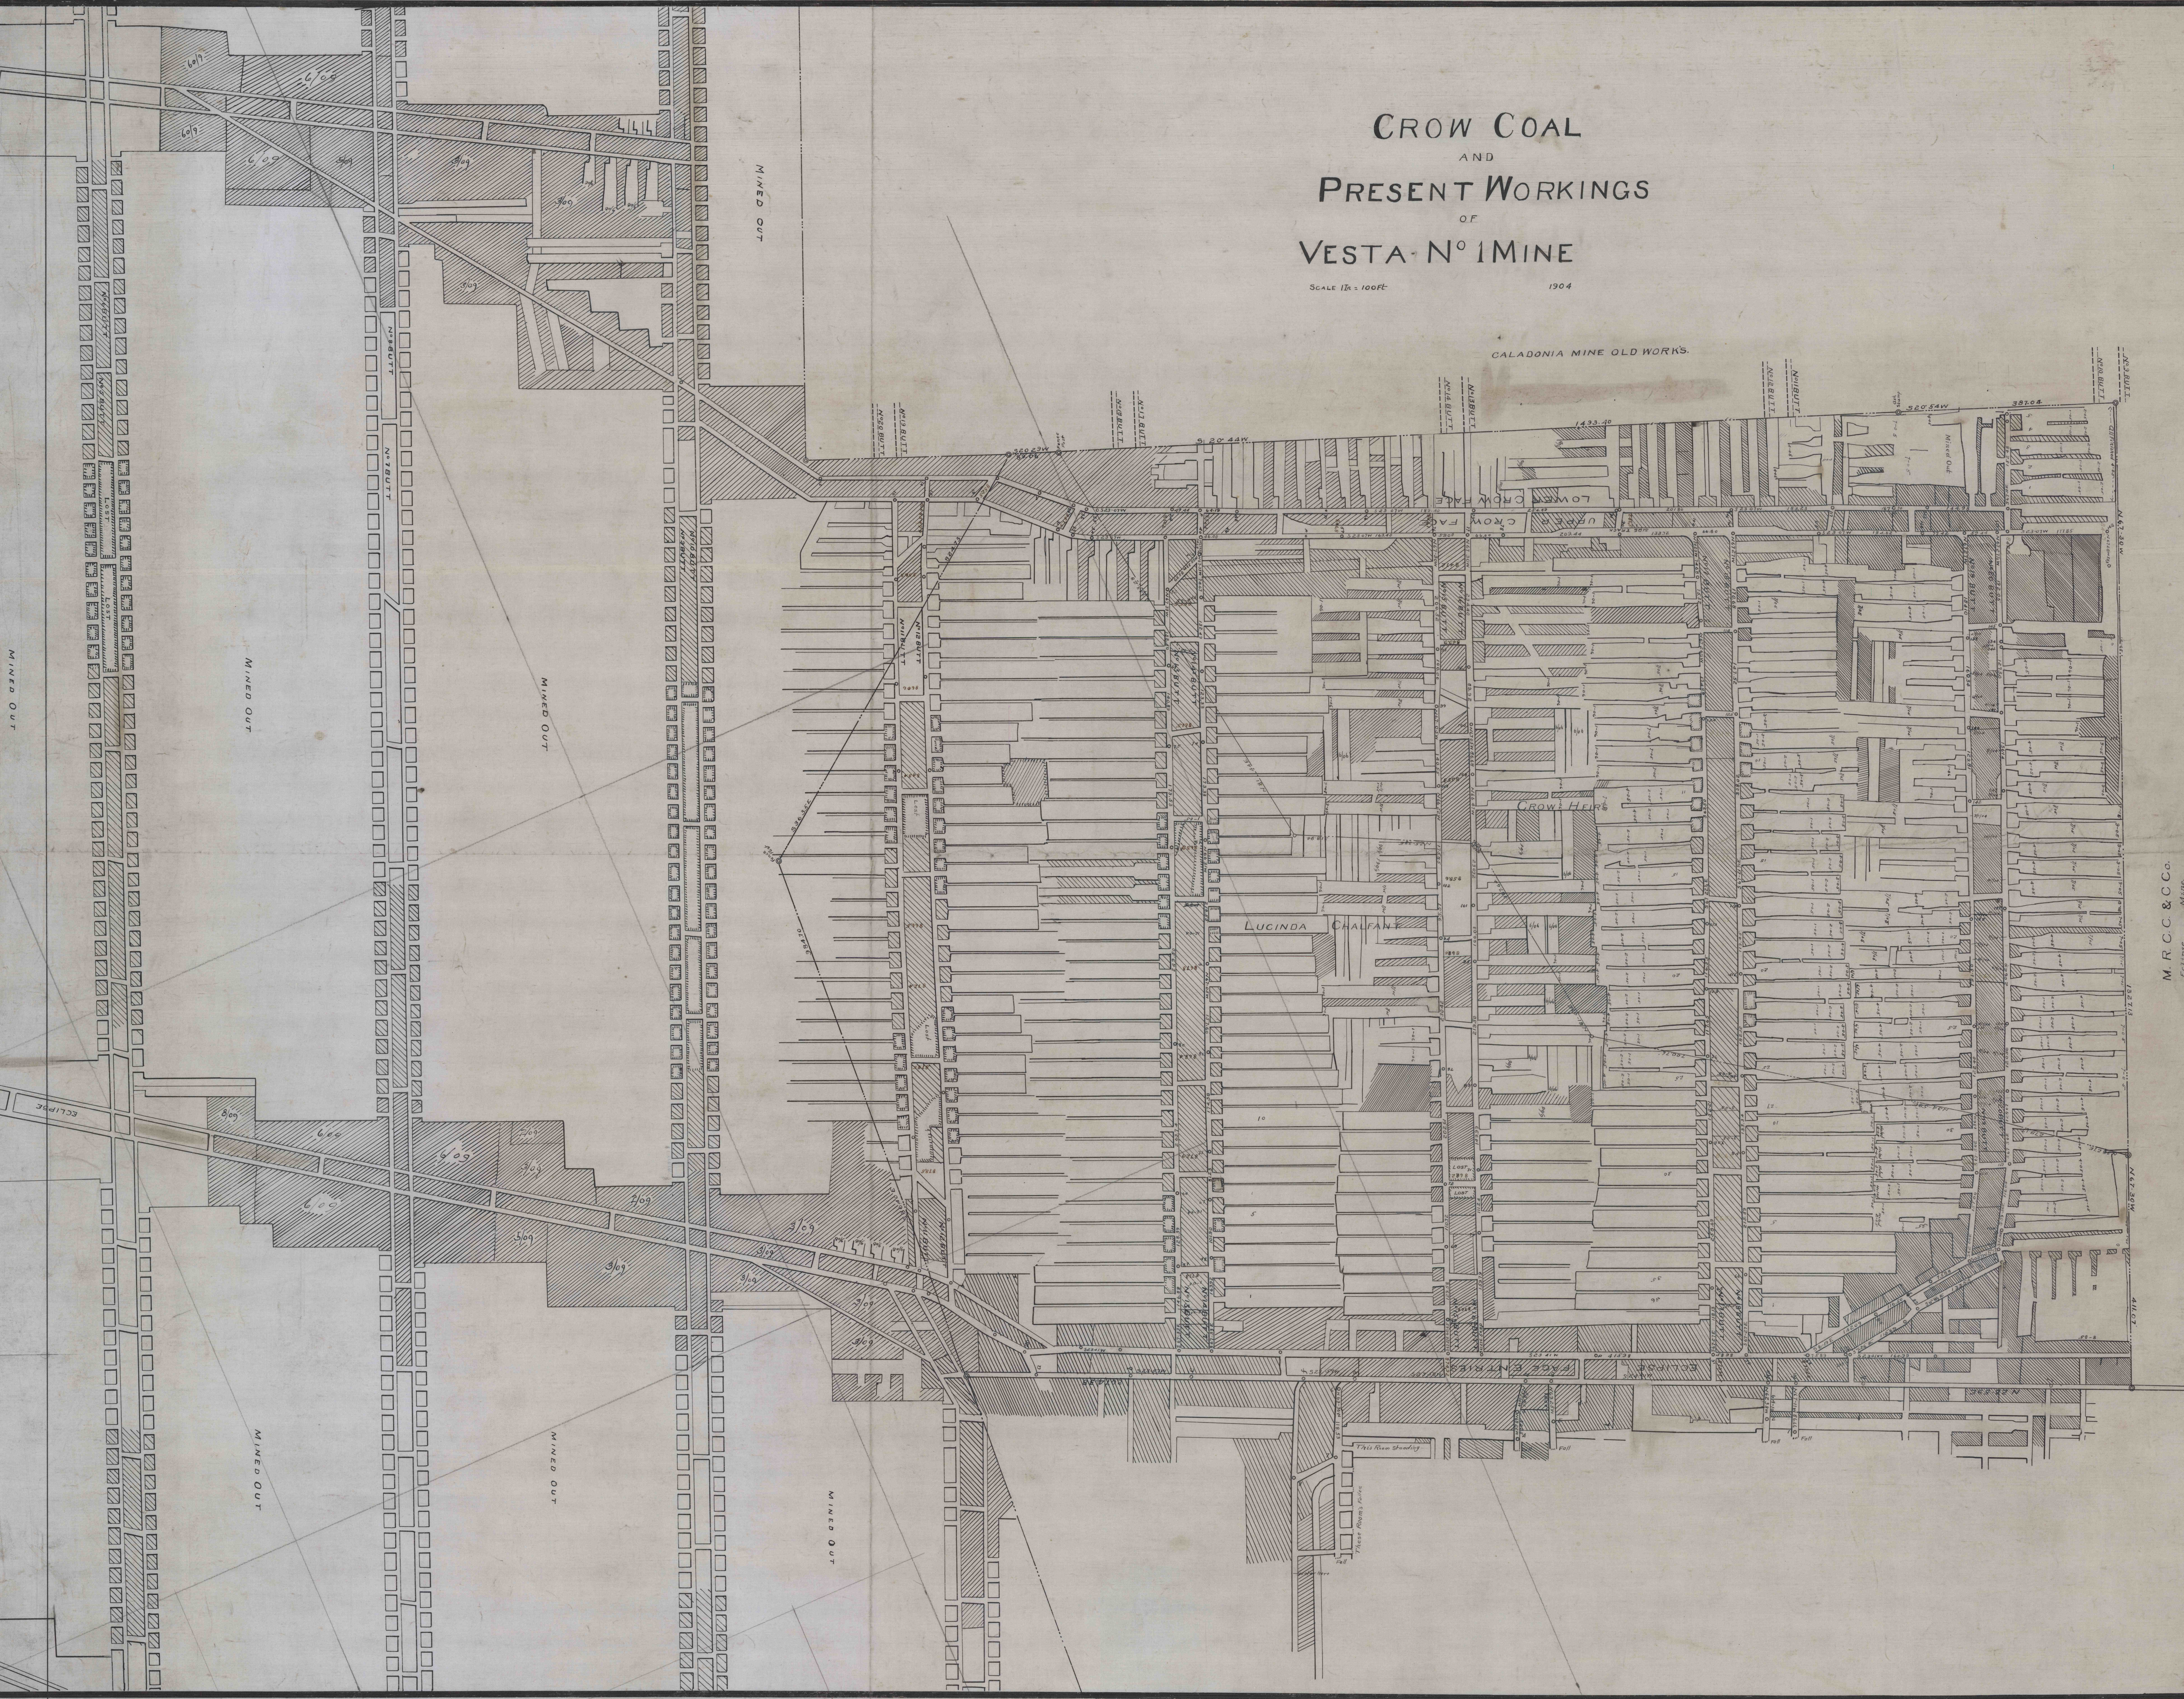

M. R. C. & C. Co.  
ENGINEERS  
