


Mined Out

S.T. Chester.

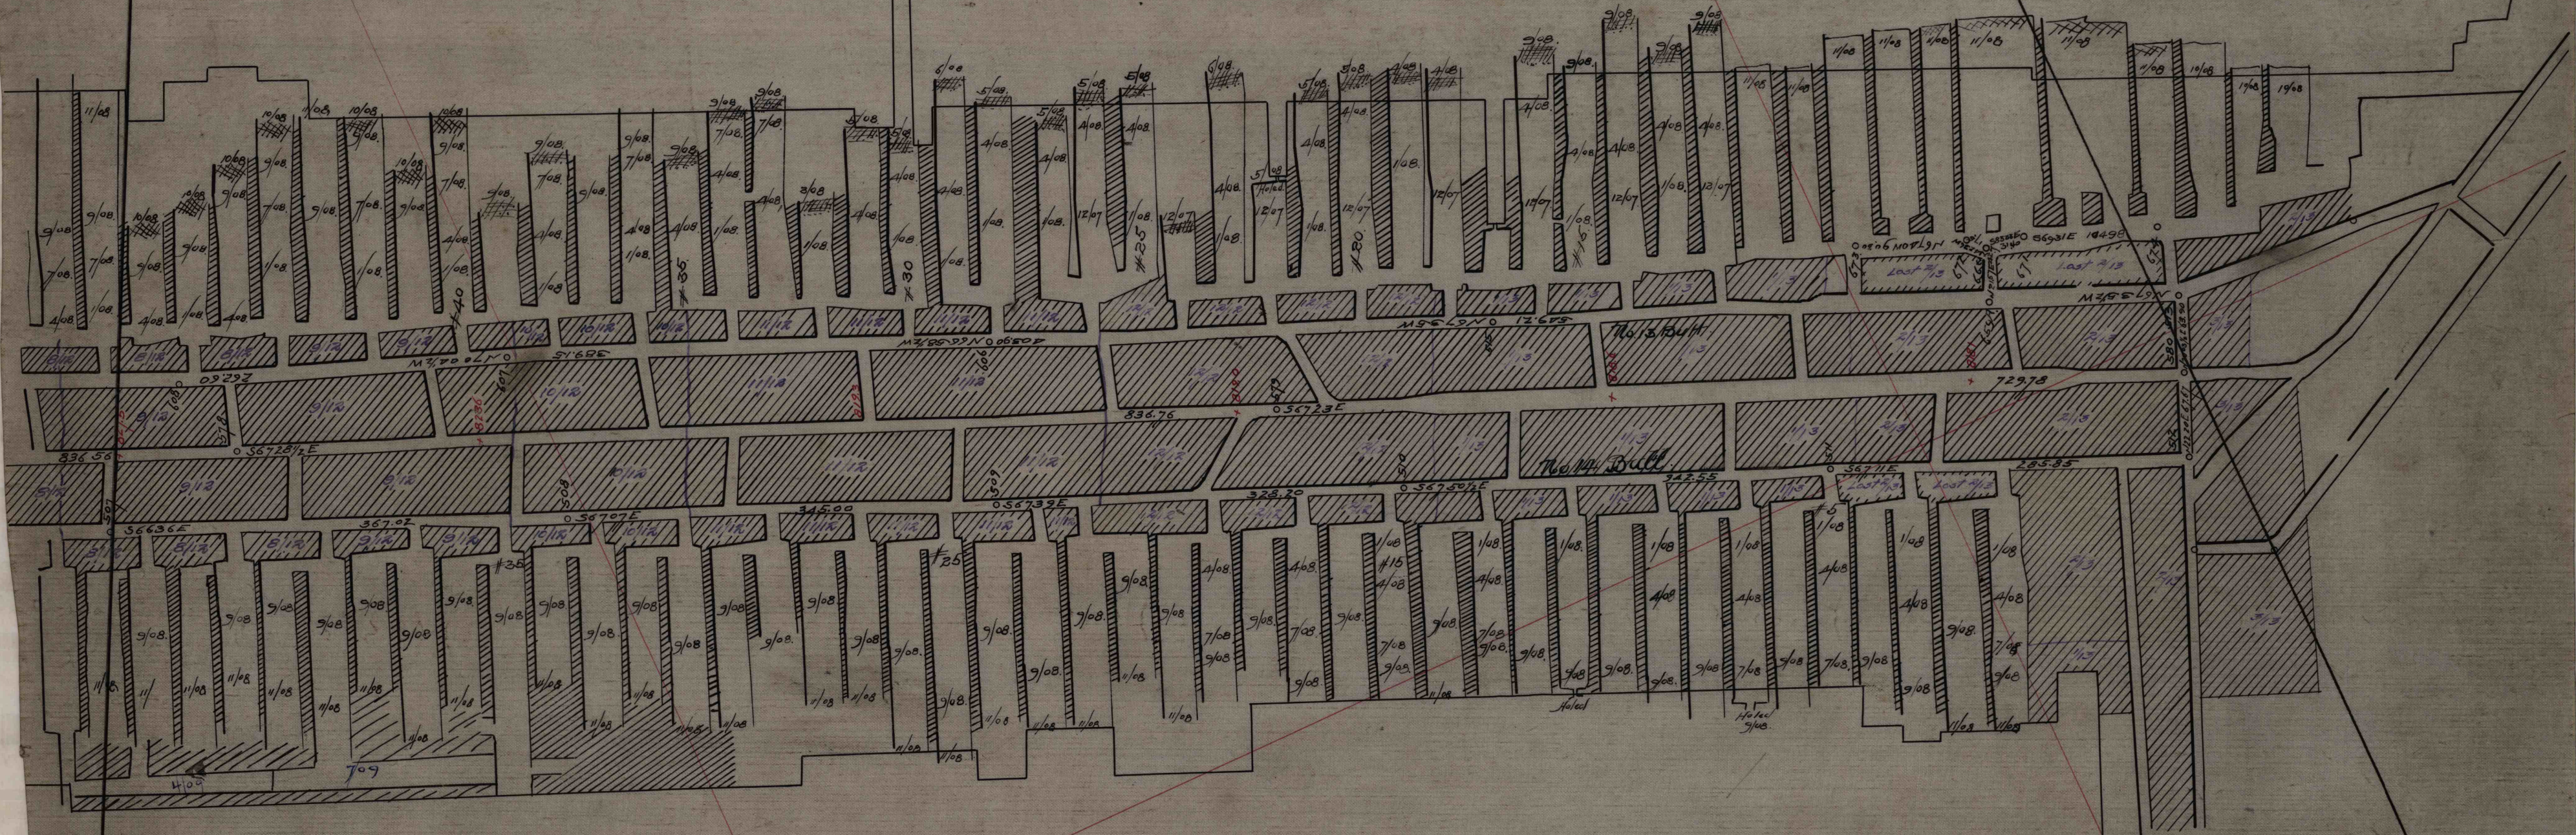

Mined Out