


1-3

1-3

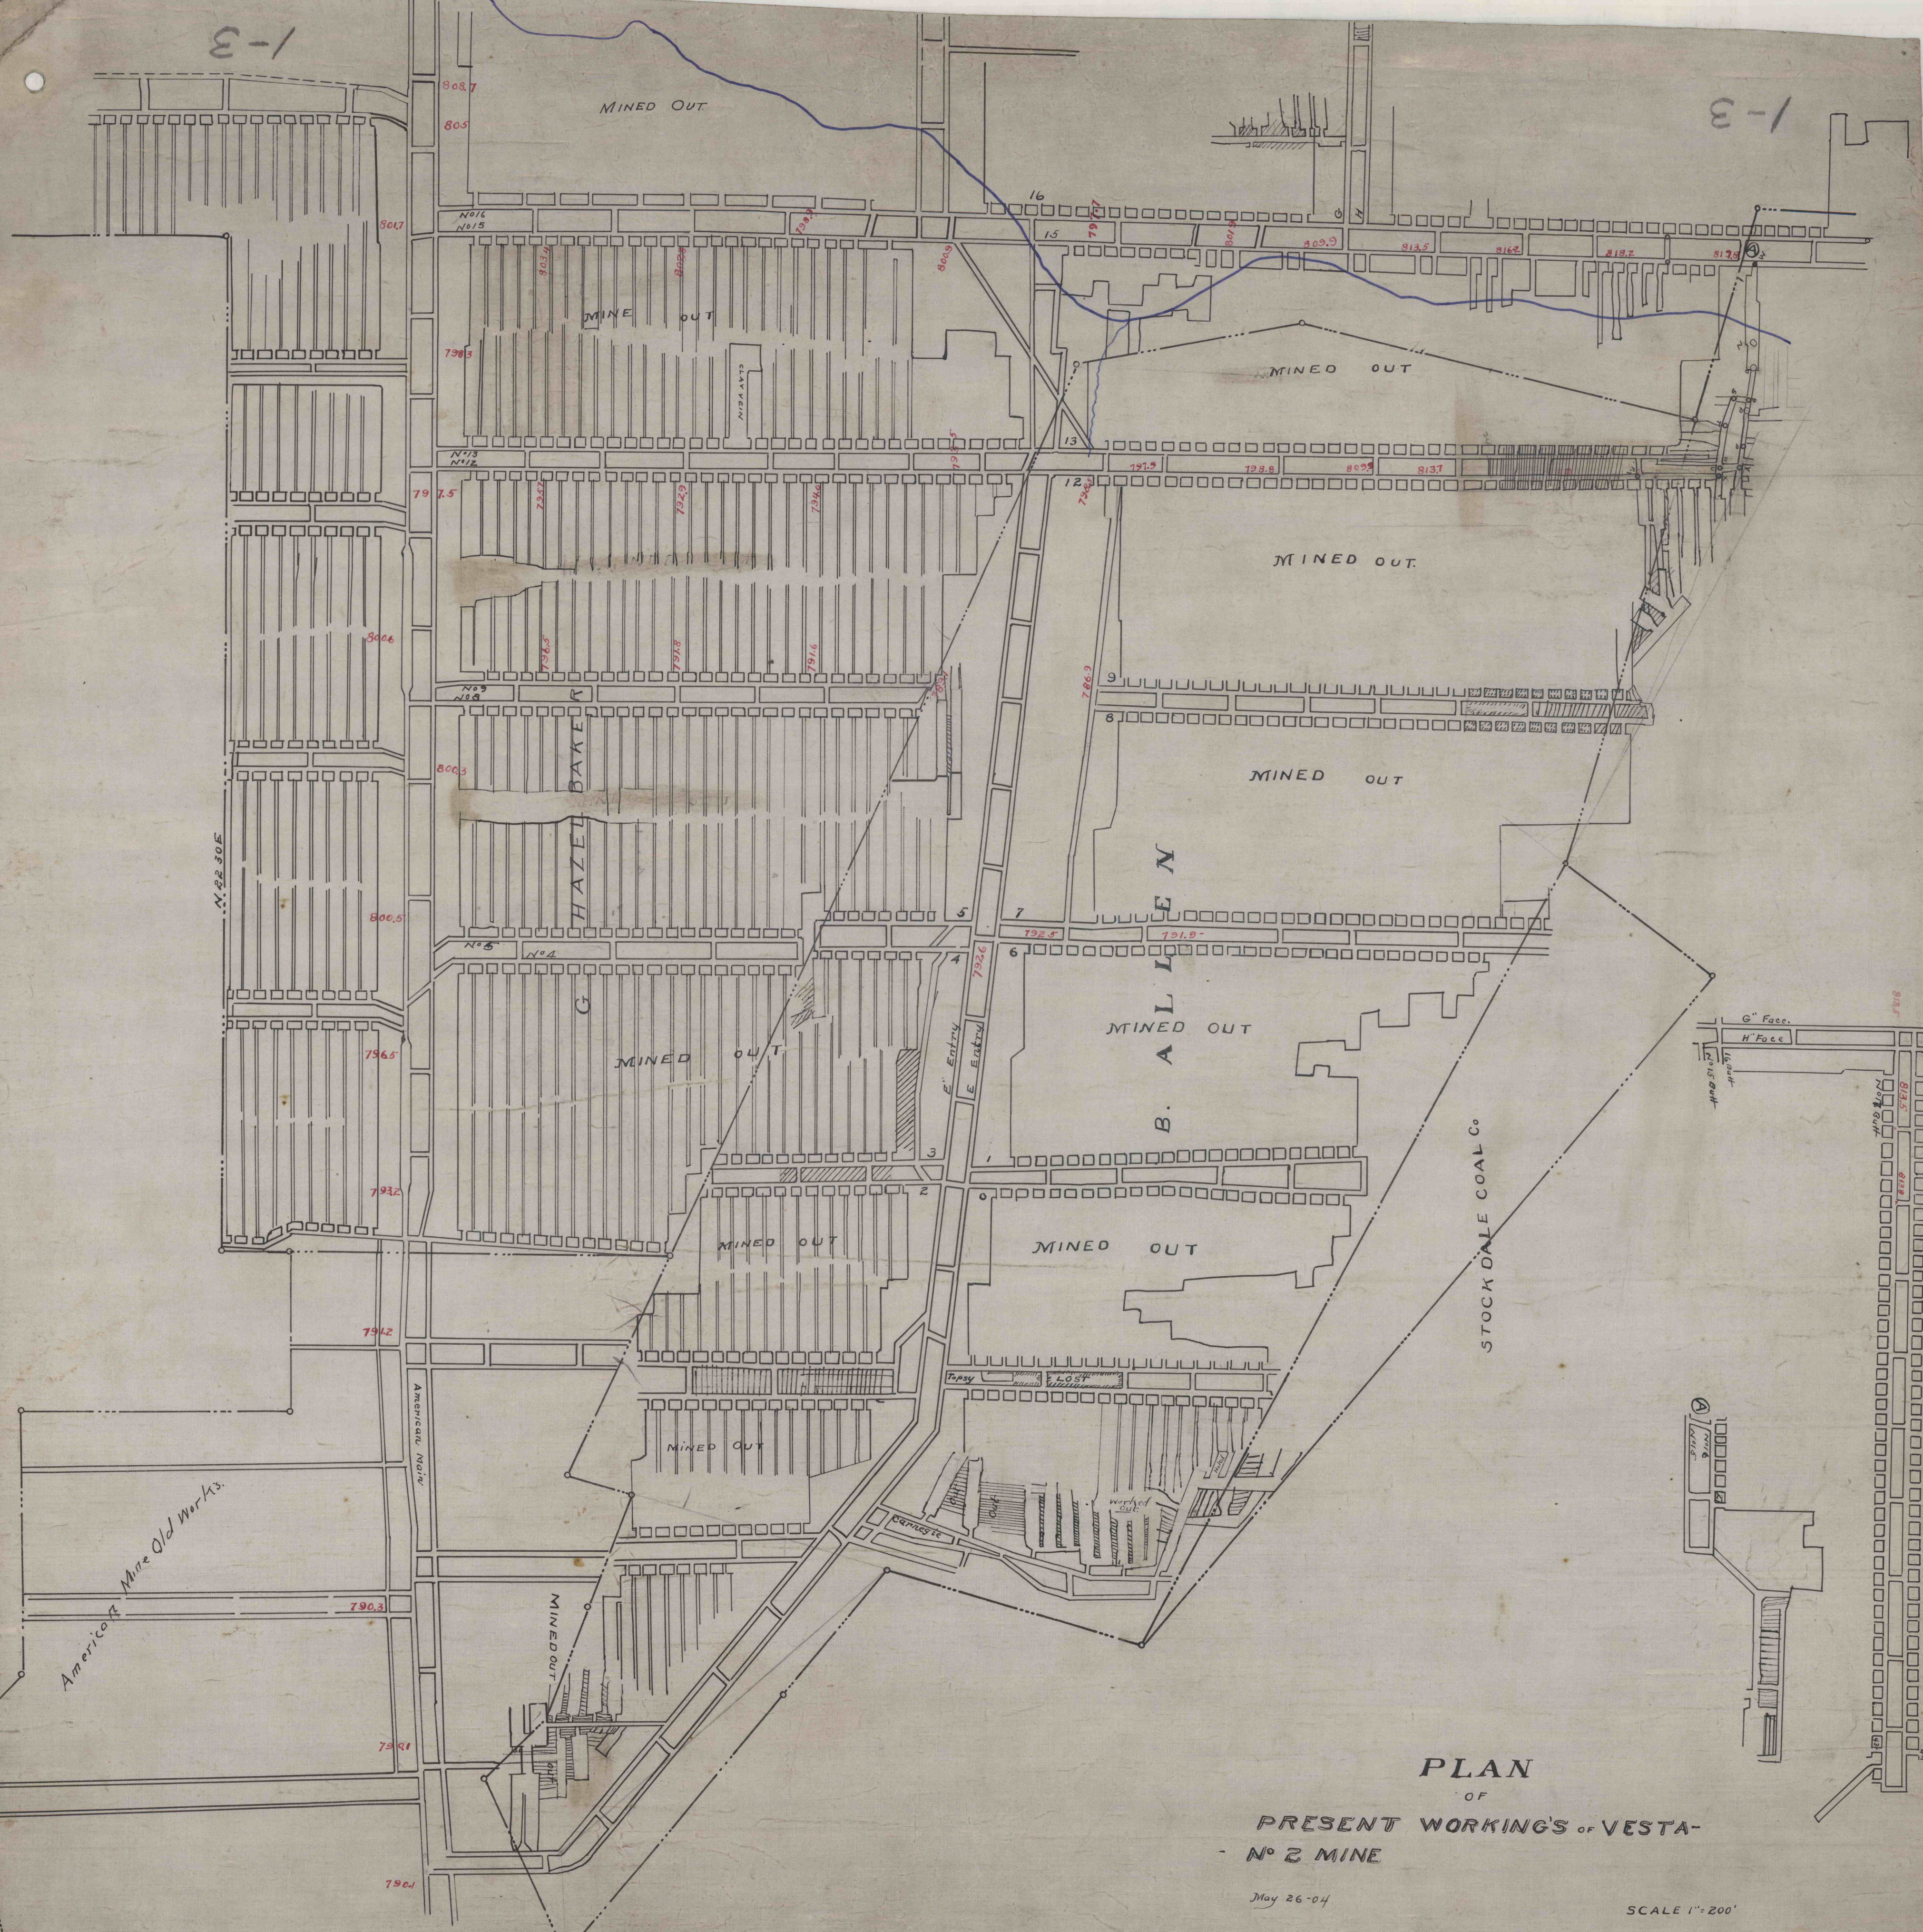

PLAN  
OF  
PRESENT WORKINGS OF VESTA-  
NO 2 MINE

May 26-04

SCALE 1"=200'

Note: Pillars Cross-hatched Parallel to Entry are worked out  
" " " " at Right angles to Entry last.

1-3

1-3