


5 BEALLS
(43)

#2 BEALLVILLE
43

BEALLVILLE

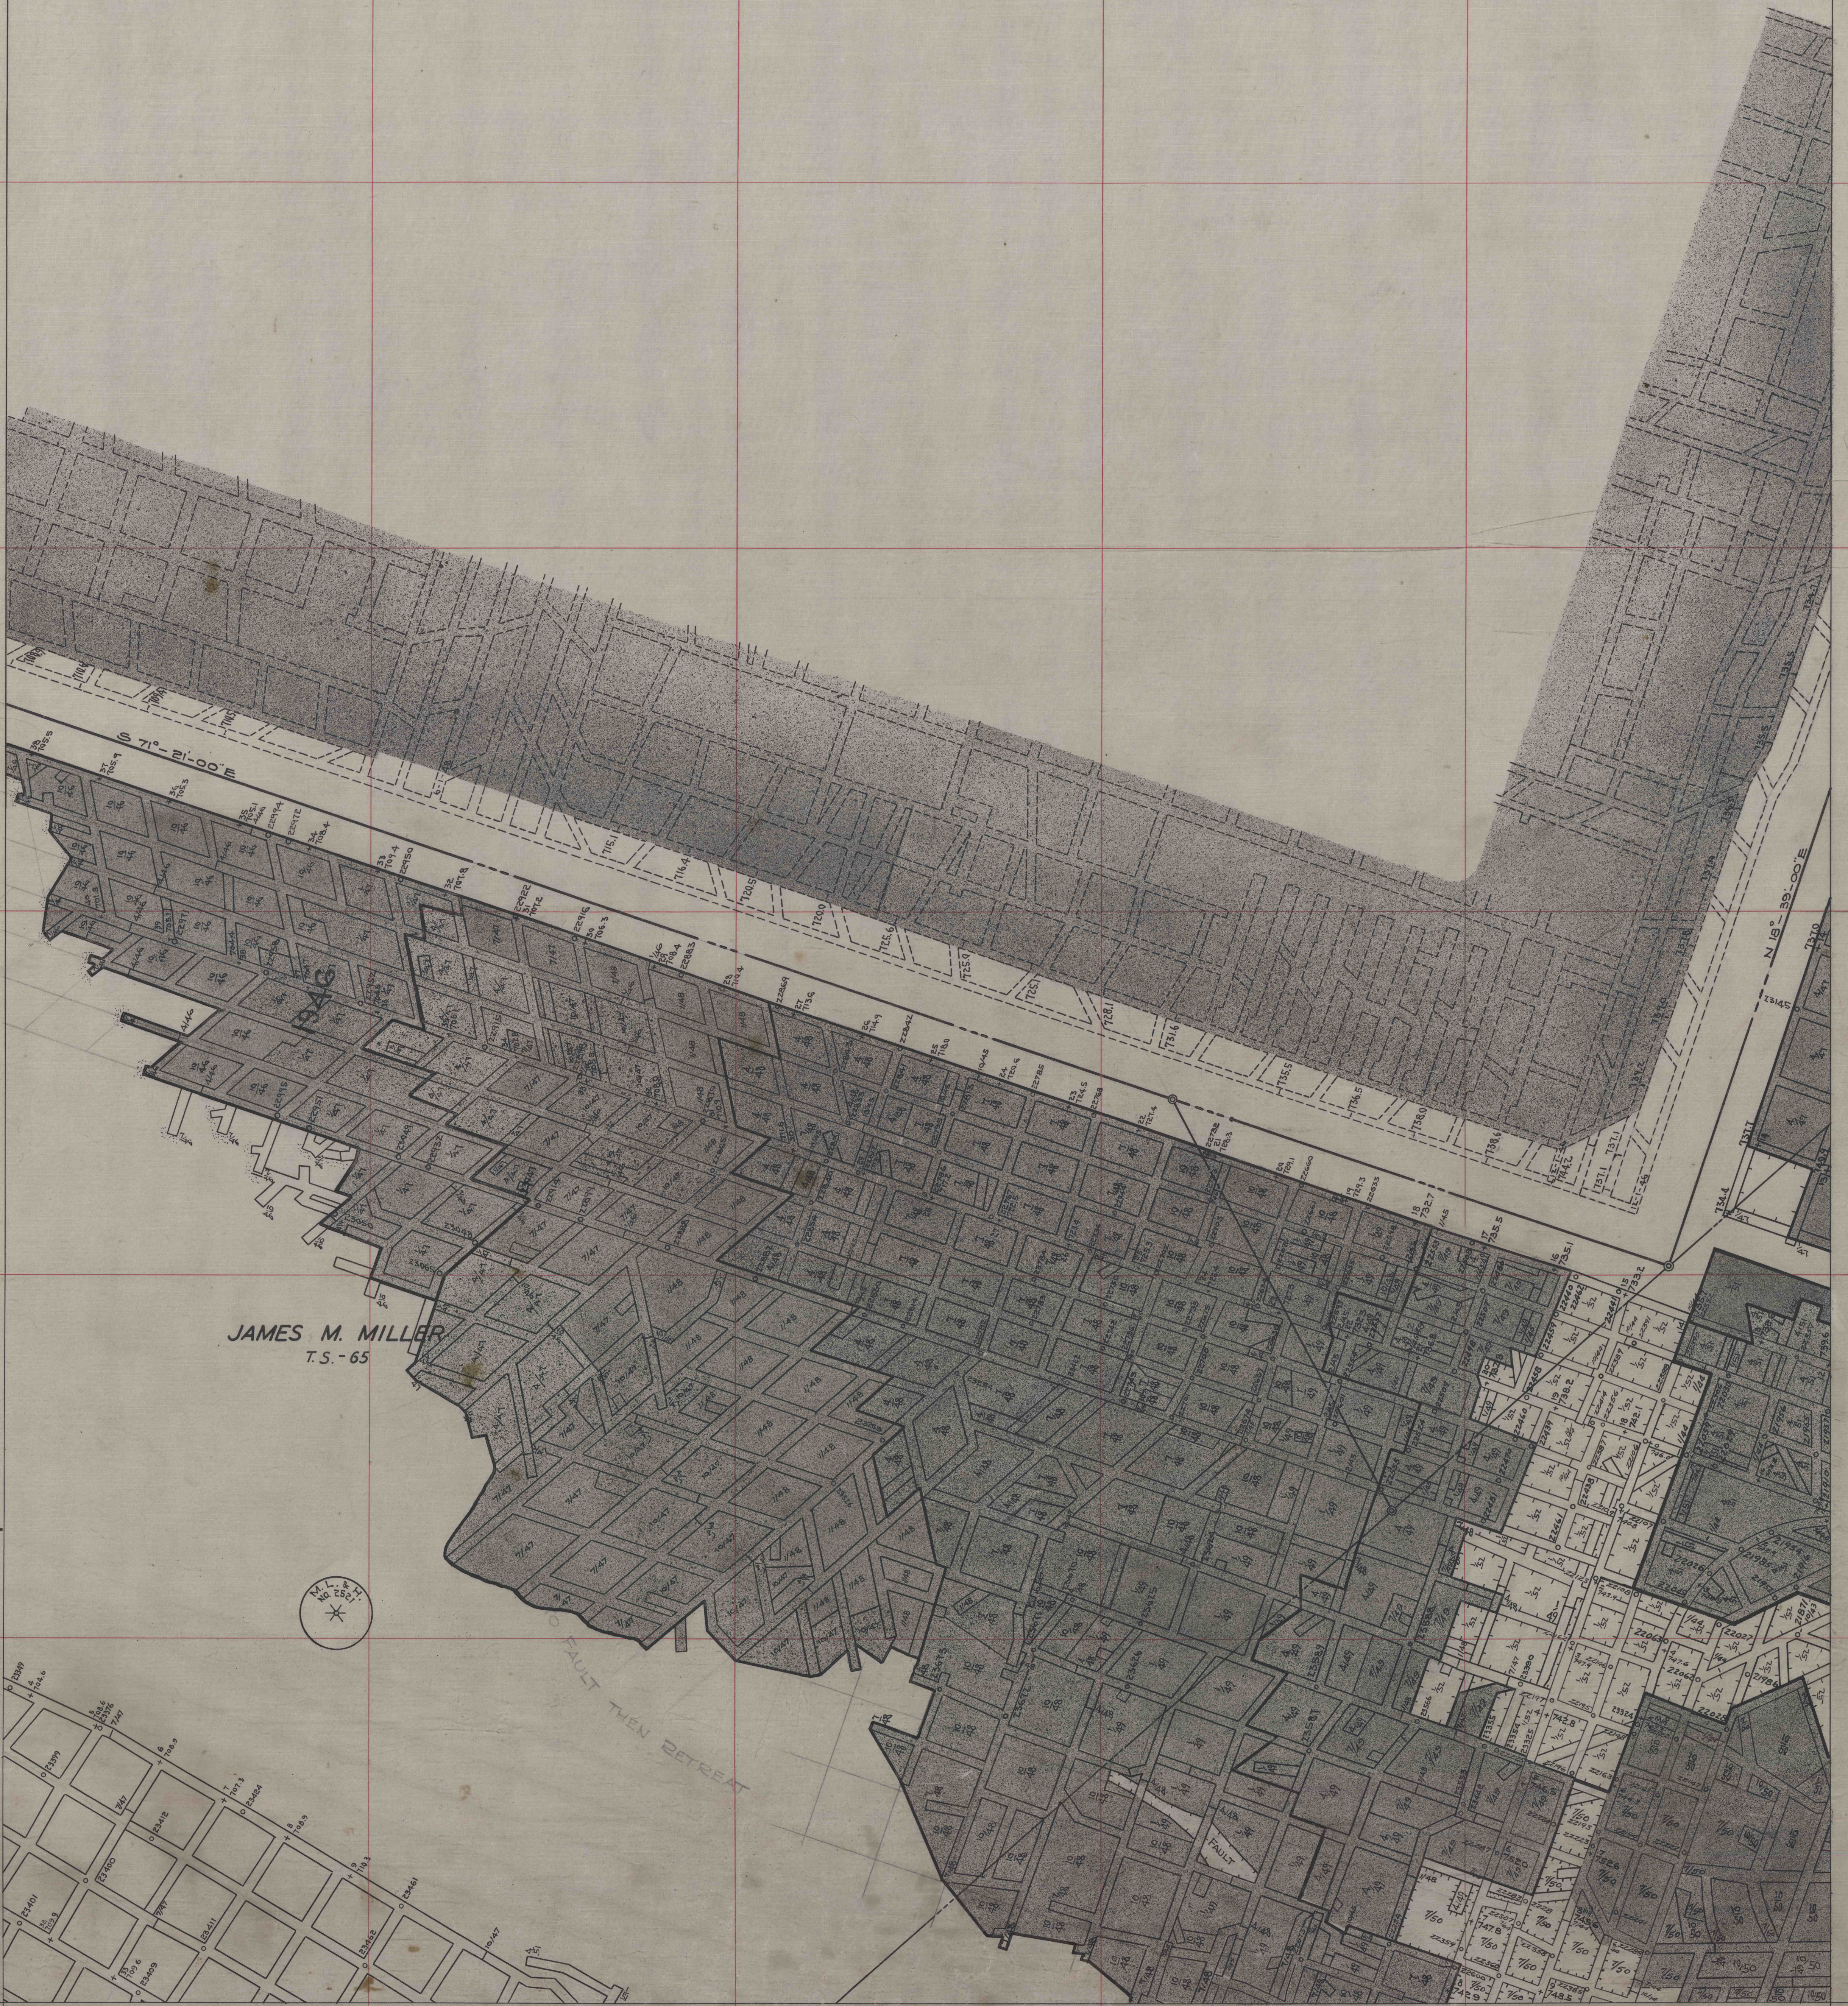

JAMES M. MILLER
T.S. - 65



5 BEALLS
(43)

#2 BEALLVILLE
43

BEALLVILLE