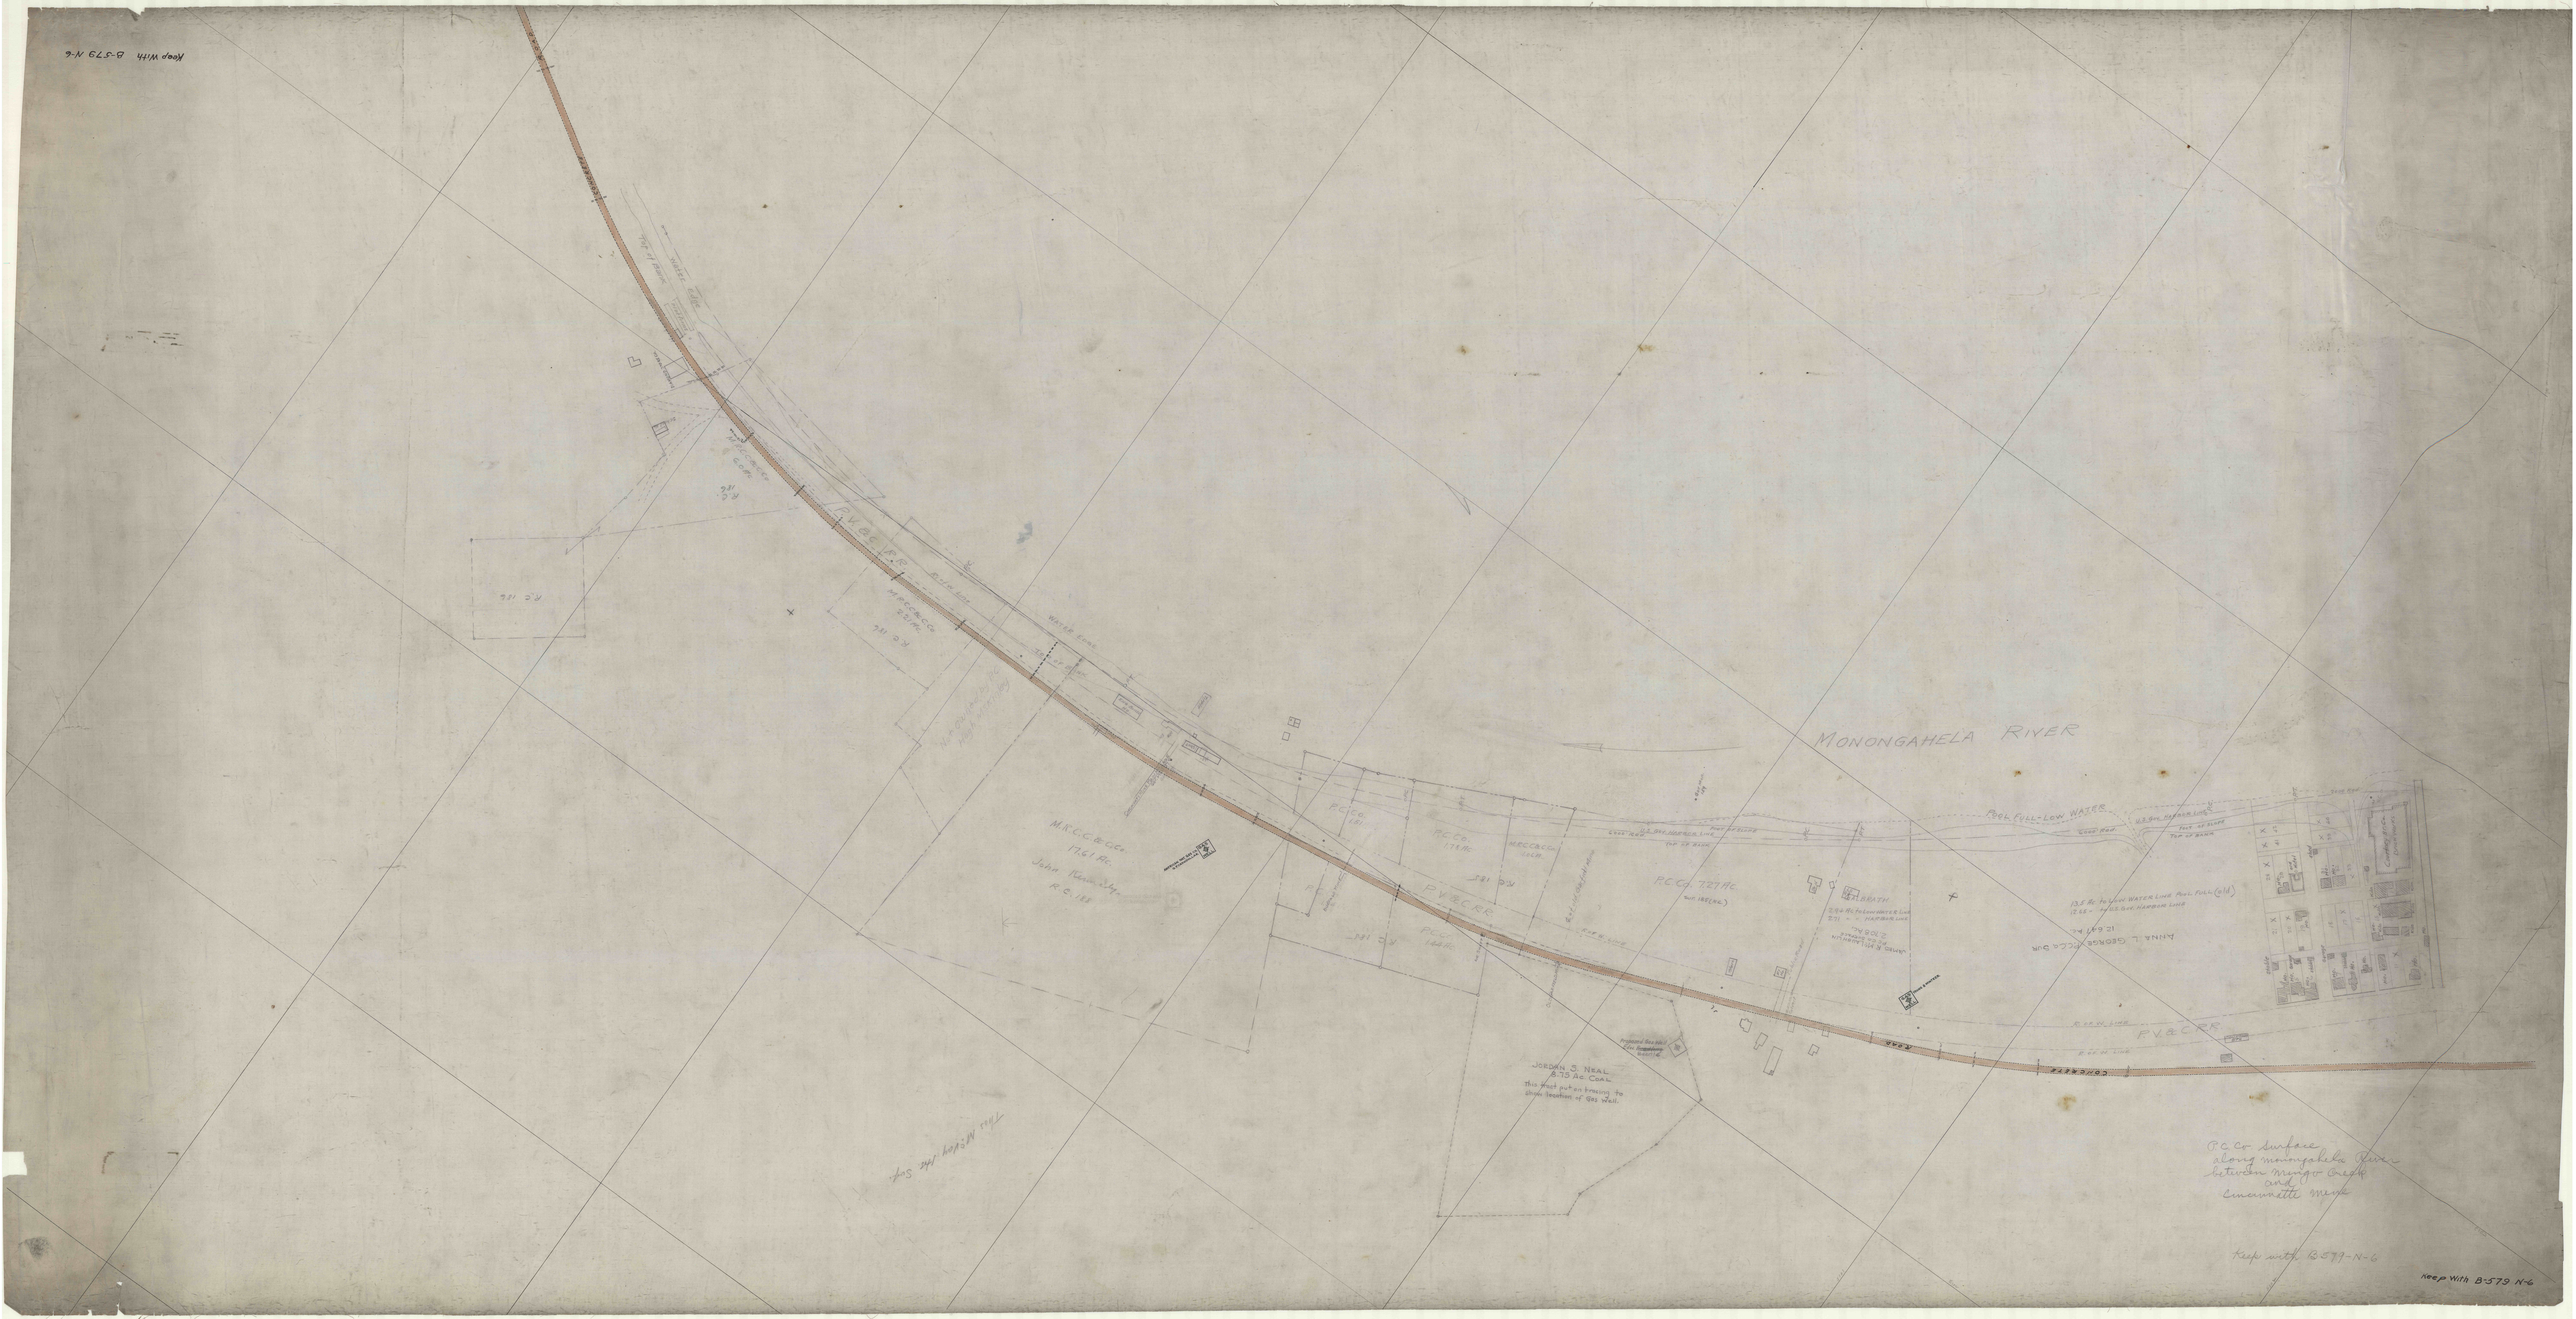
Keep With B-579 N-6
MONONGAHELA RIVER
POOL FULL-LOW WATER
P.V.&C.R.R.
M.R.C.C.&C.Co.
17.61 Ac.
John Kennedy
R.C. 188
P.C.Co. 7.27 Ac.
P.C.Co. 1.78 Ac.
P.C.Co. 1.44 Ac.
JORDAN S. NEAL
8.75 Ac. COAL
This tract put on tracing to show location of Gas Well.
ANNA L. GEORGE
P.C.Co. surface
along monongahela River
between Mingo Creek
and
Cincinnatti Mine
Keep with B-579-N-6
Keep With B-579 N-6