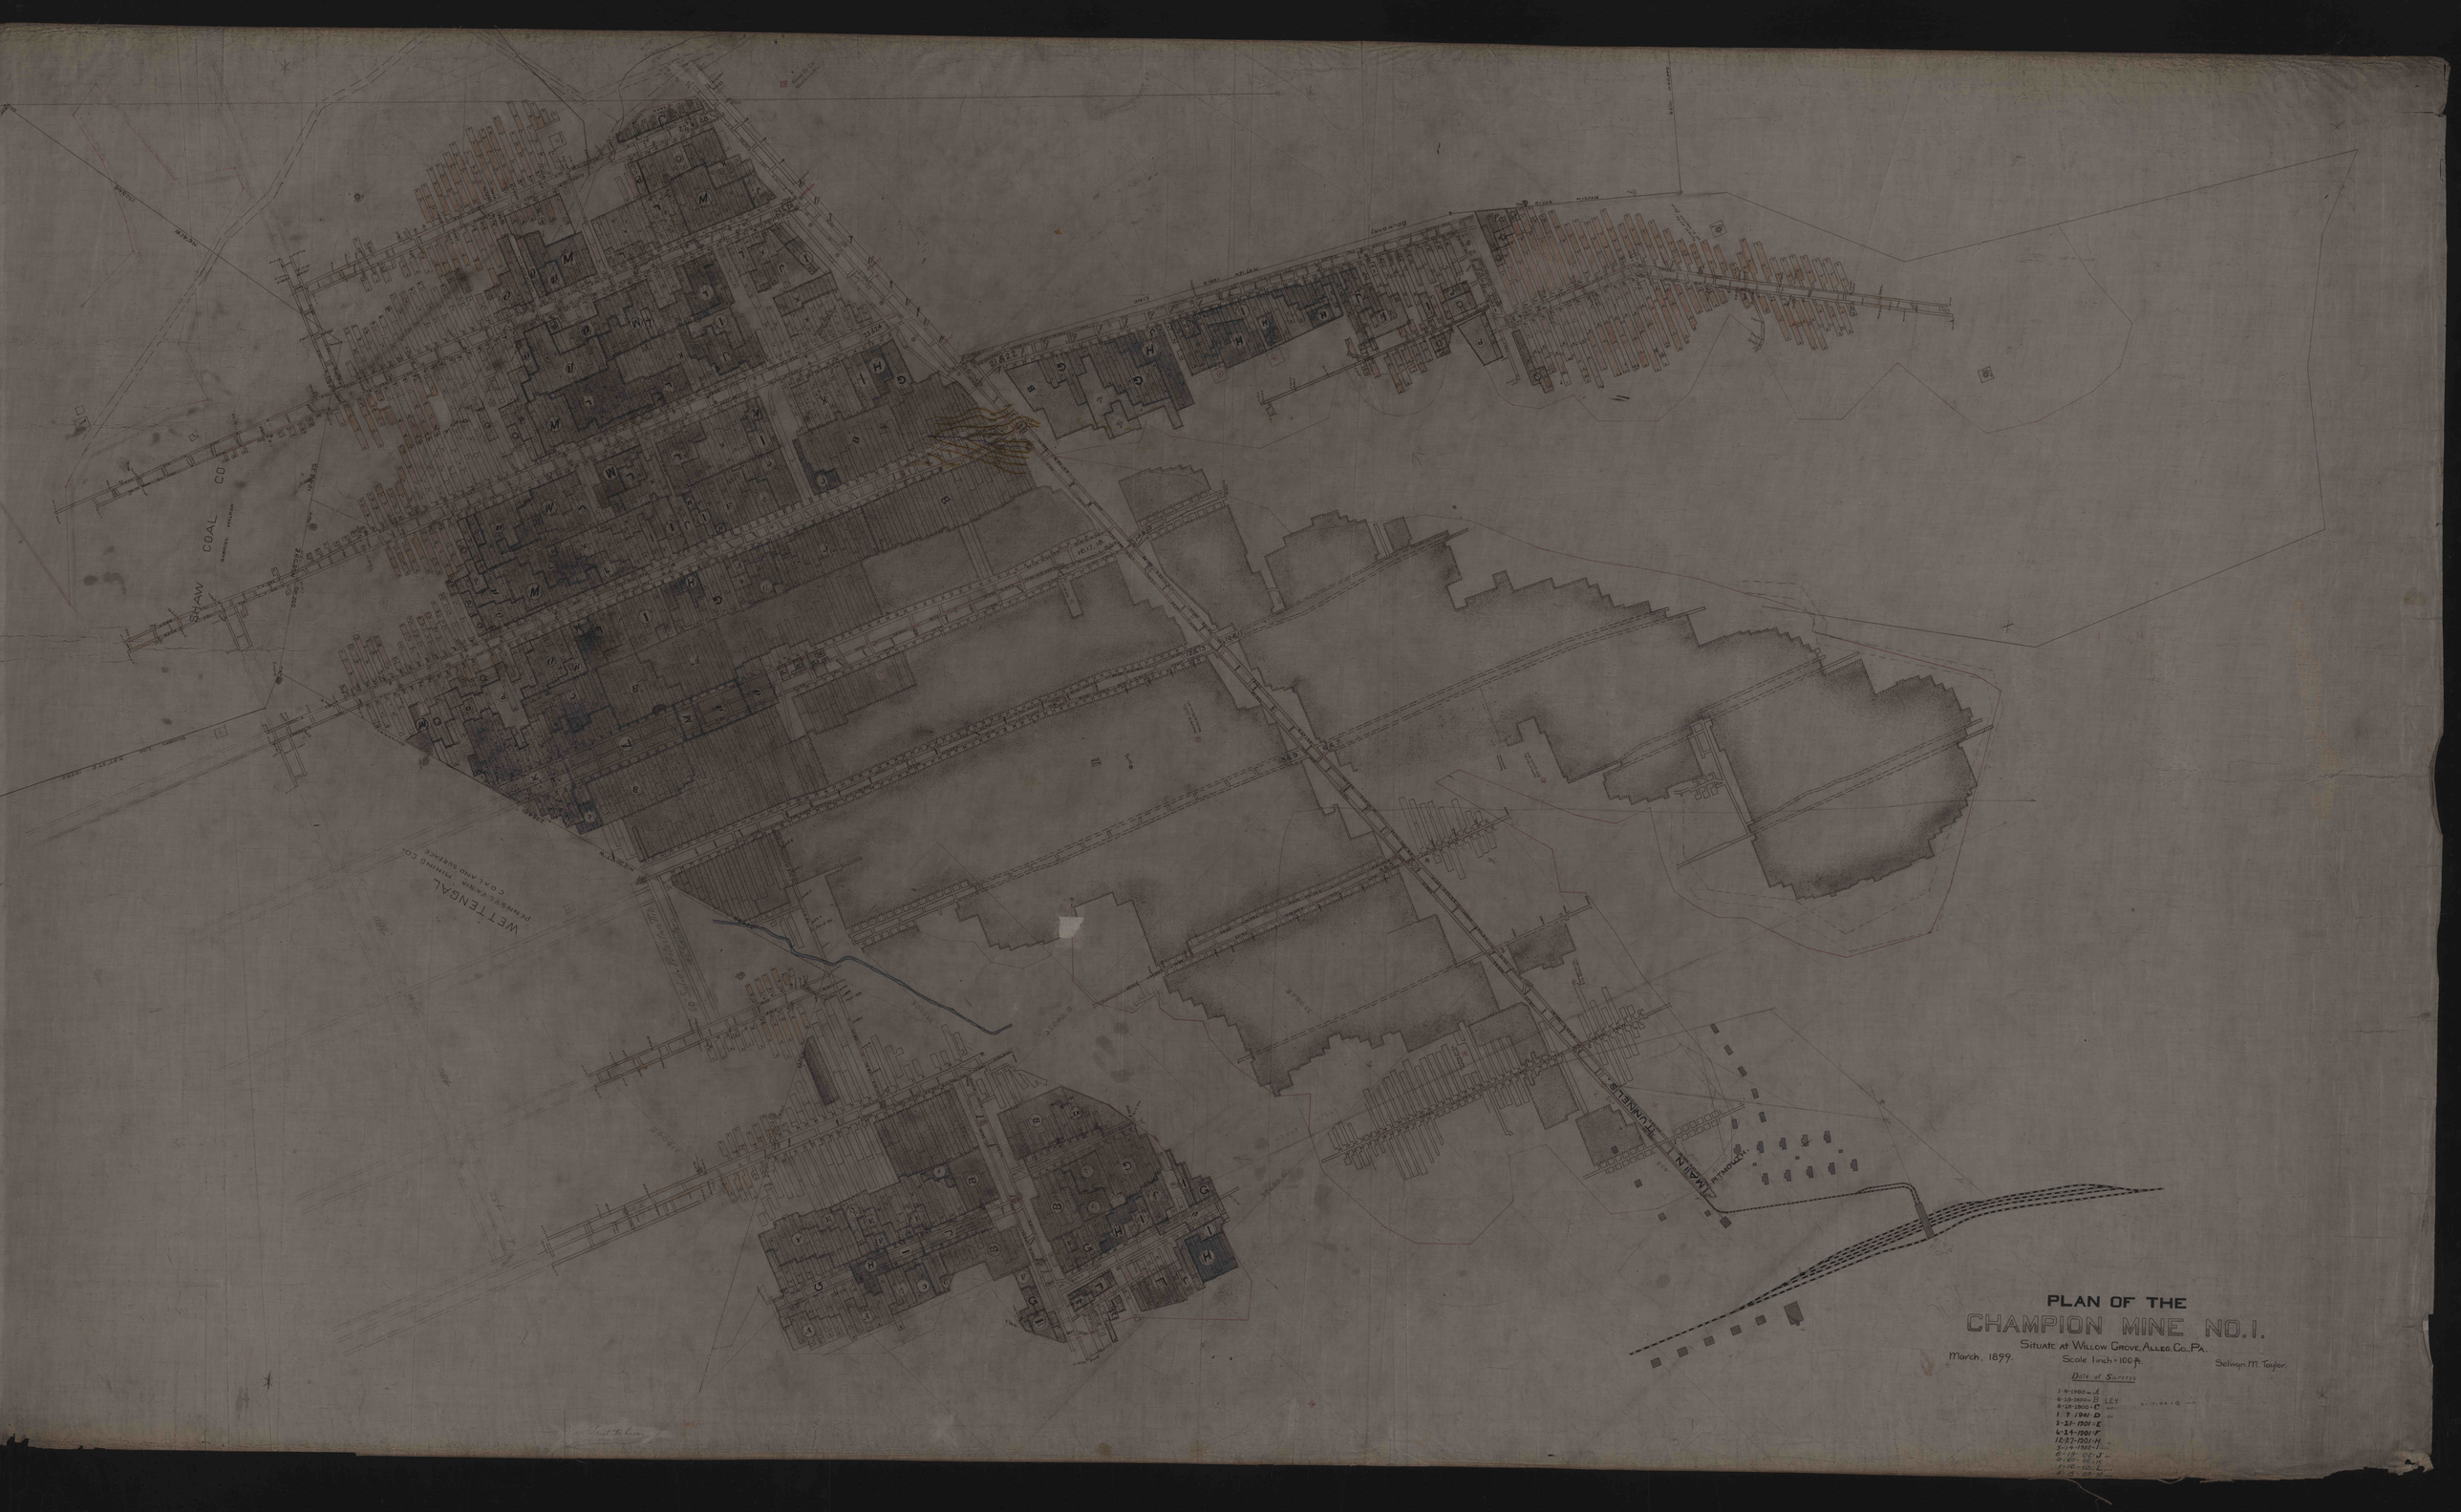


PLAN OF THE

CHAMPION MINE NO. 1.

Situate at Willow Grove, Alleg. Co., Pa.

March, 1899. Scale 1 inch = 100 ft. Selwyn M. Taylor.

Date of Surveys

1-8-1900 = A
6-15-1900 = B LEY
9-18-1900 = C
1-7-1901 = D
3-21-1901 = E
6-24-1901 = F
12-27-1901 = H
3-14-1902 = I
6-18-02 = J
10-20-02 = K
1-12-03 = L
4-15-03 = M