



EAST MARIANNA PLAN OF LOTS  
FORMERLY  
JAMES GAYMAN

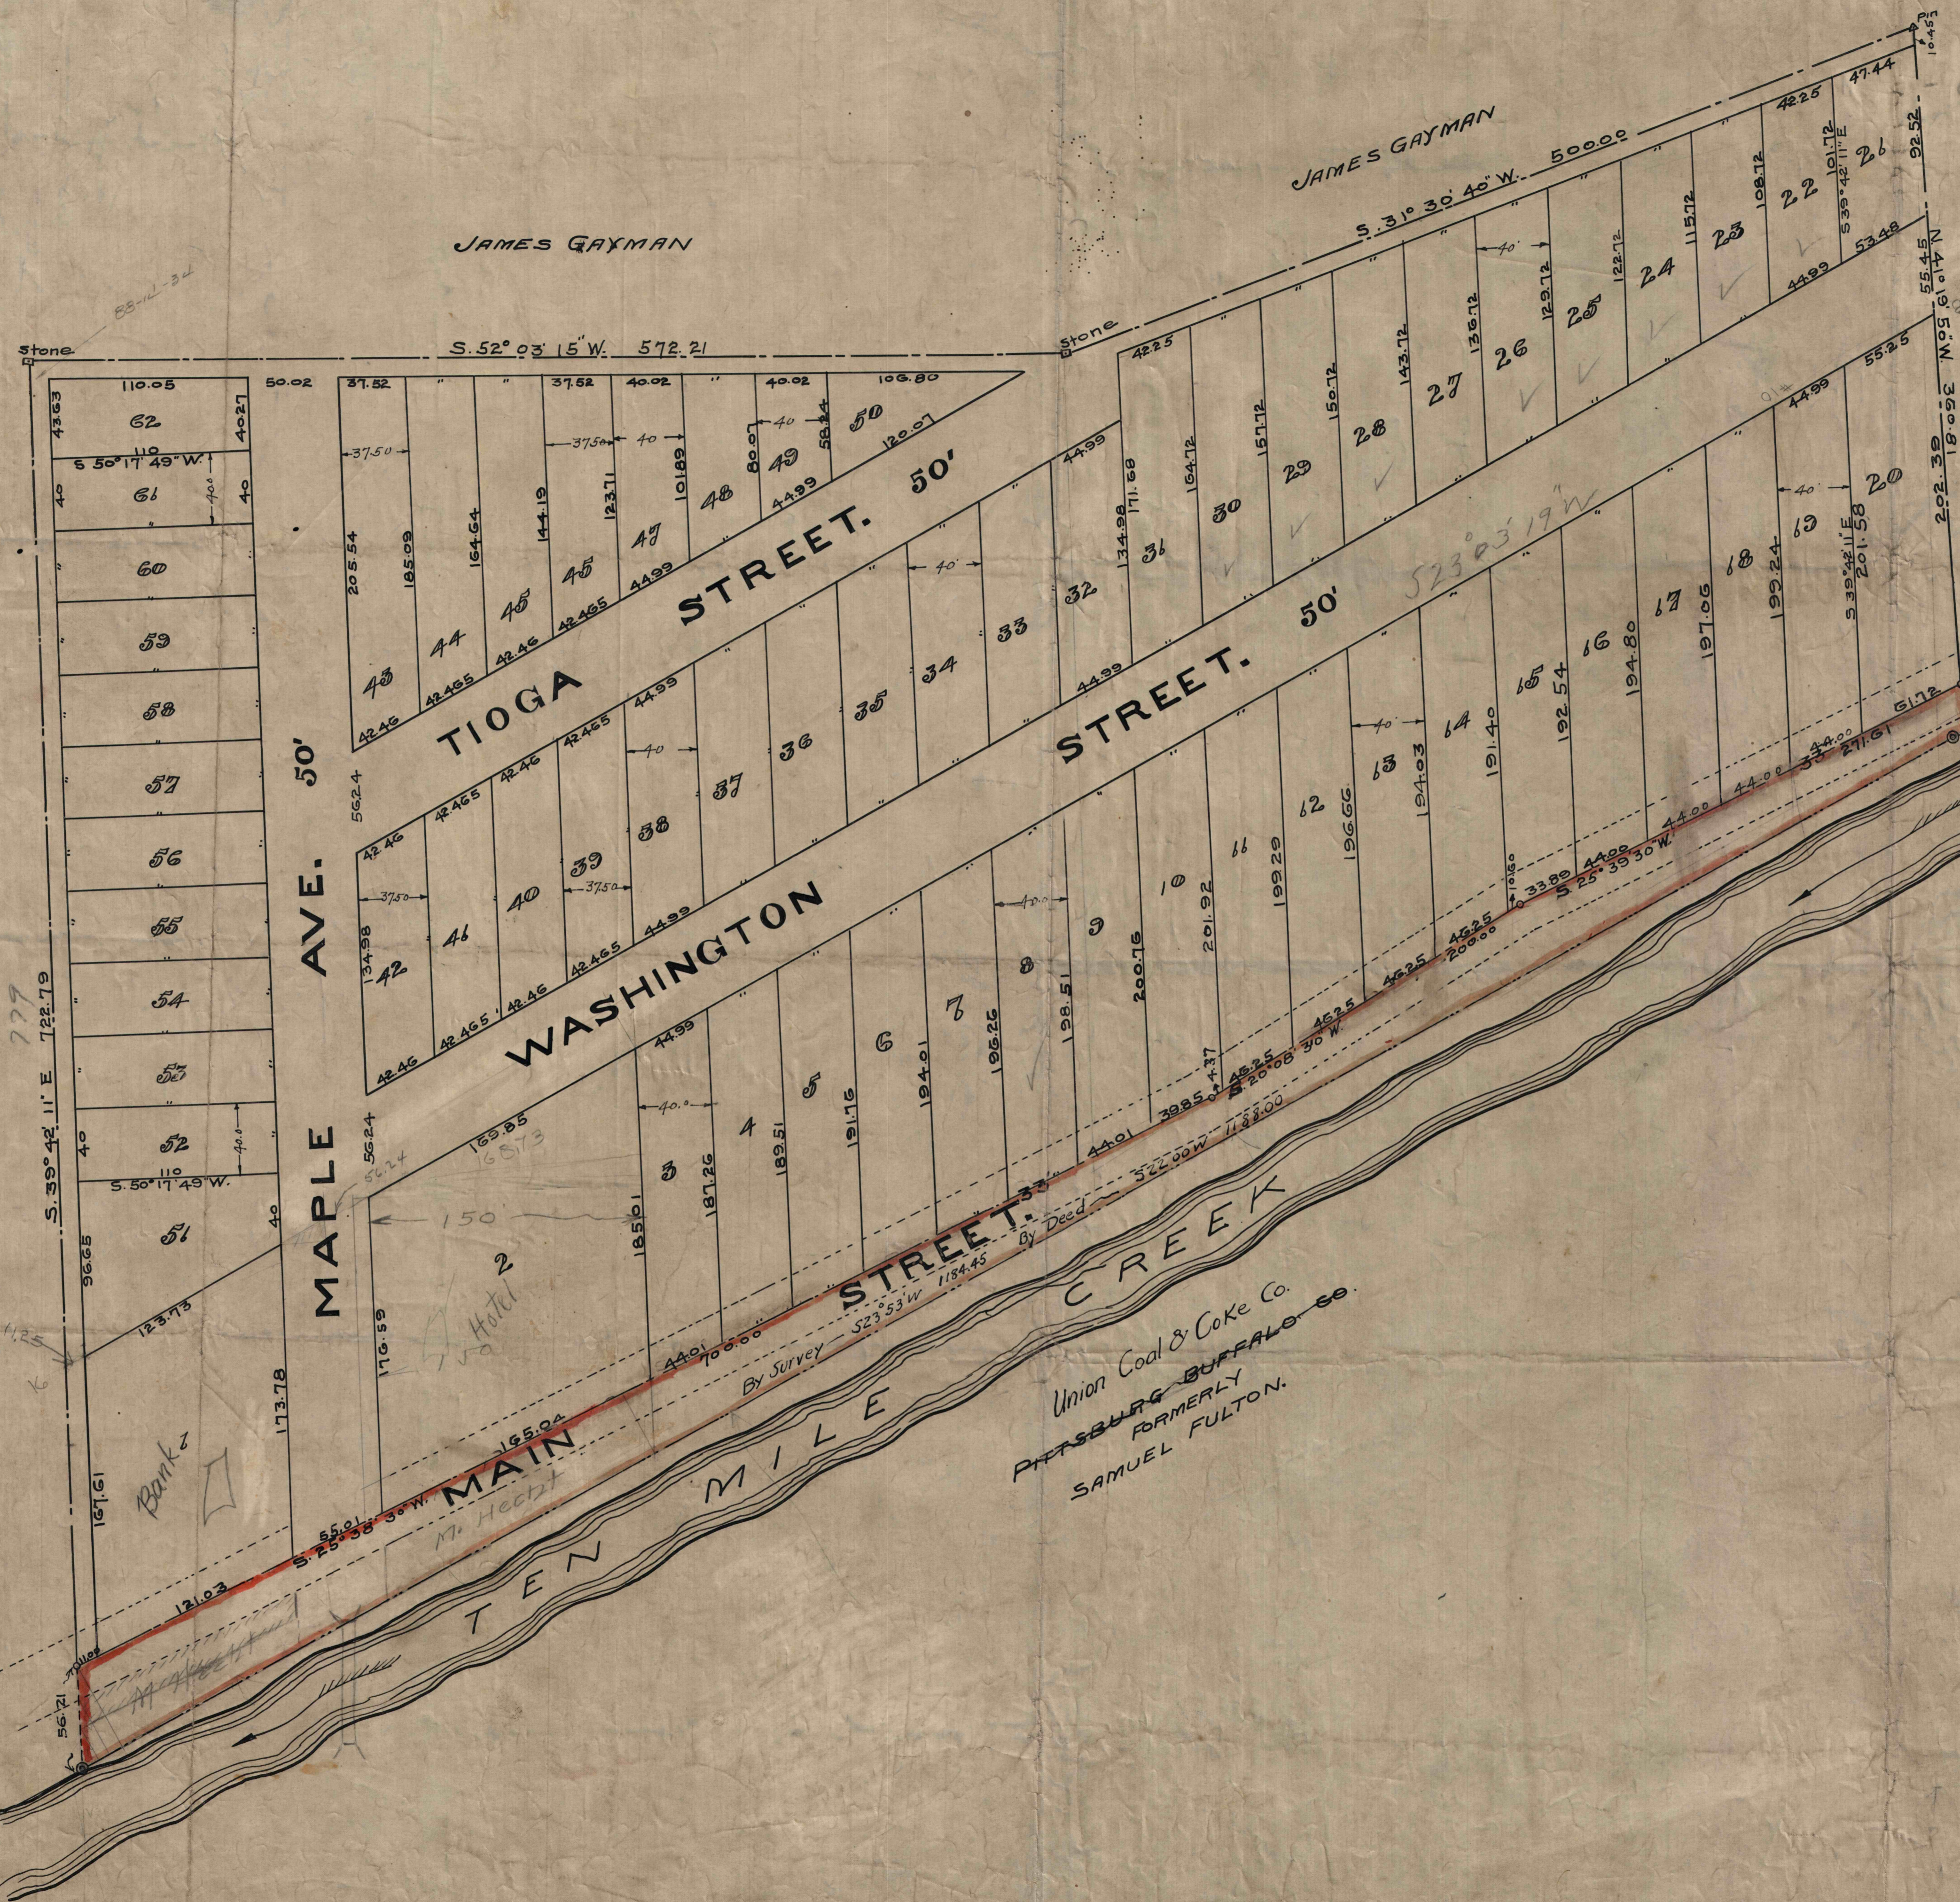

Union Coal & Coke Co  
JOHANNETTE COAL CO.  
FORMERLY  
ISSAC GAYMAN

We hereby adopt this plan of lots as ours  
The Washington Investment Company  
J. A. Ray President  
Wm. S. George Treasurer

State of Pennsylvania  
County of Allegheny } SS  
Before me, a Notary Public in and for said State and  
County, personally came J. A. Ray, President of the  
Washington Investment Company, who does hereby  
acknowledge the foregoing plan as the act and  
deed of said Company, and declares that the  
same may be recorded as such.  
Witness my hand and notarial seal this 12th  
day of October, 1908  
E. J. Peltzer  
Notary Public  

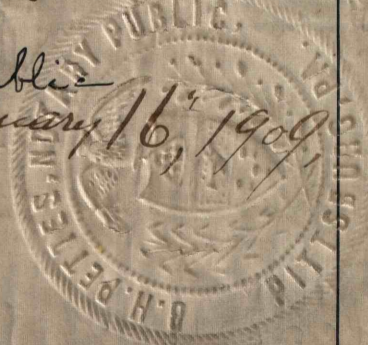

For the total acreage of this tract (J. Gayman)  
See Plan Book No. 2 7/1 (1877-8) March 30, 1914 R.L.P.

Recorded in the office for Recording Deeds, &c. in and  
for said county in Plan Book 3 page 134-135  
Given under my hand and seal of the said office this  
13th day of October A. D. 1908

John T. Hall Recorder

UNION COAL & COKE CO. MARIANNA PA.	
TITLE: WASHINGTON INVEST CO PLAN OF LOTS	
SCALE 50' = 1"	
DATE MADE	OCT. 8, 1908.
DATE REVISED	
NUMBER	1298-M-24
MADE BY	E. A. GRIFFITH
CHECKED BY	
REVISED BY	
APPROVED	J. A. Ray
O.K.	J. A. Ray
O.K.	J. A. Ray
GEN MGR	J. A. Ray
PRES.	J. A. Ray