


6-11

ESTIMATE - SHAFT No. 1.

GRADING	--- 3100 Cu Yds. Filling --- @ 40¢	\$1240.00
MASONRY	--- 50 " " --- " 8.00	400.00
TRACK	--- 2178 Lin Ft --- " 1.75	3811.50
CONNECTIONS	--- (3) Turnouts #8 --- " 450.00	1350.00
		6801.50
	Additional 10%	680.15
	Total	\$7481.65

ESTIMATE - SHAFT No. 2.

GRADING	--- 2600 Cu Yds Filling --- @ 40¢	\$1040.00
TRACK	--- 1180 Lin Ft --- " 1.75	2065.00
	Moving 1500 Ft --- " .20	300.00
CONNECTIONS	--- (4) Turnouts #8 Fit. " 300.00	1200.00
		4605.00
	Additional 10%	460.50
	Total	\$5065.50

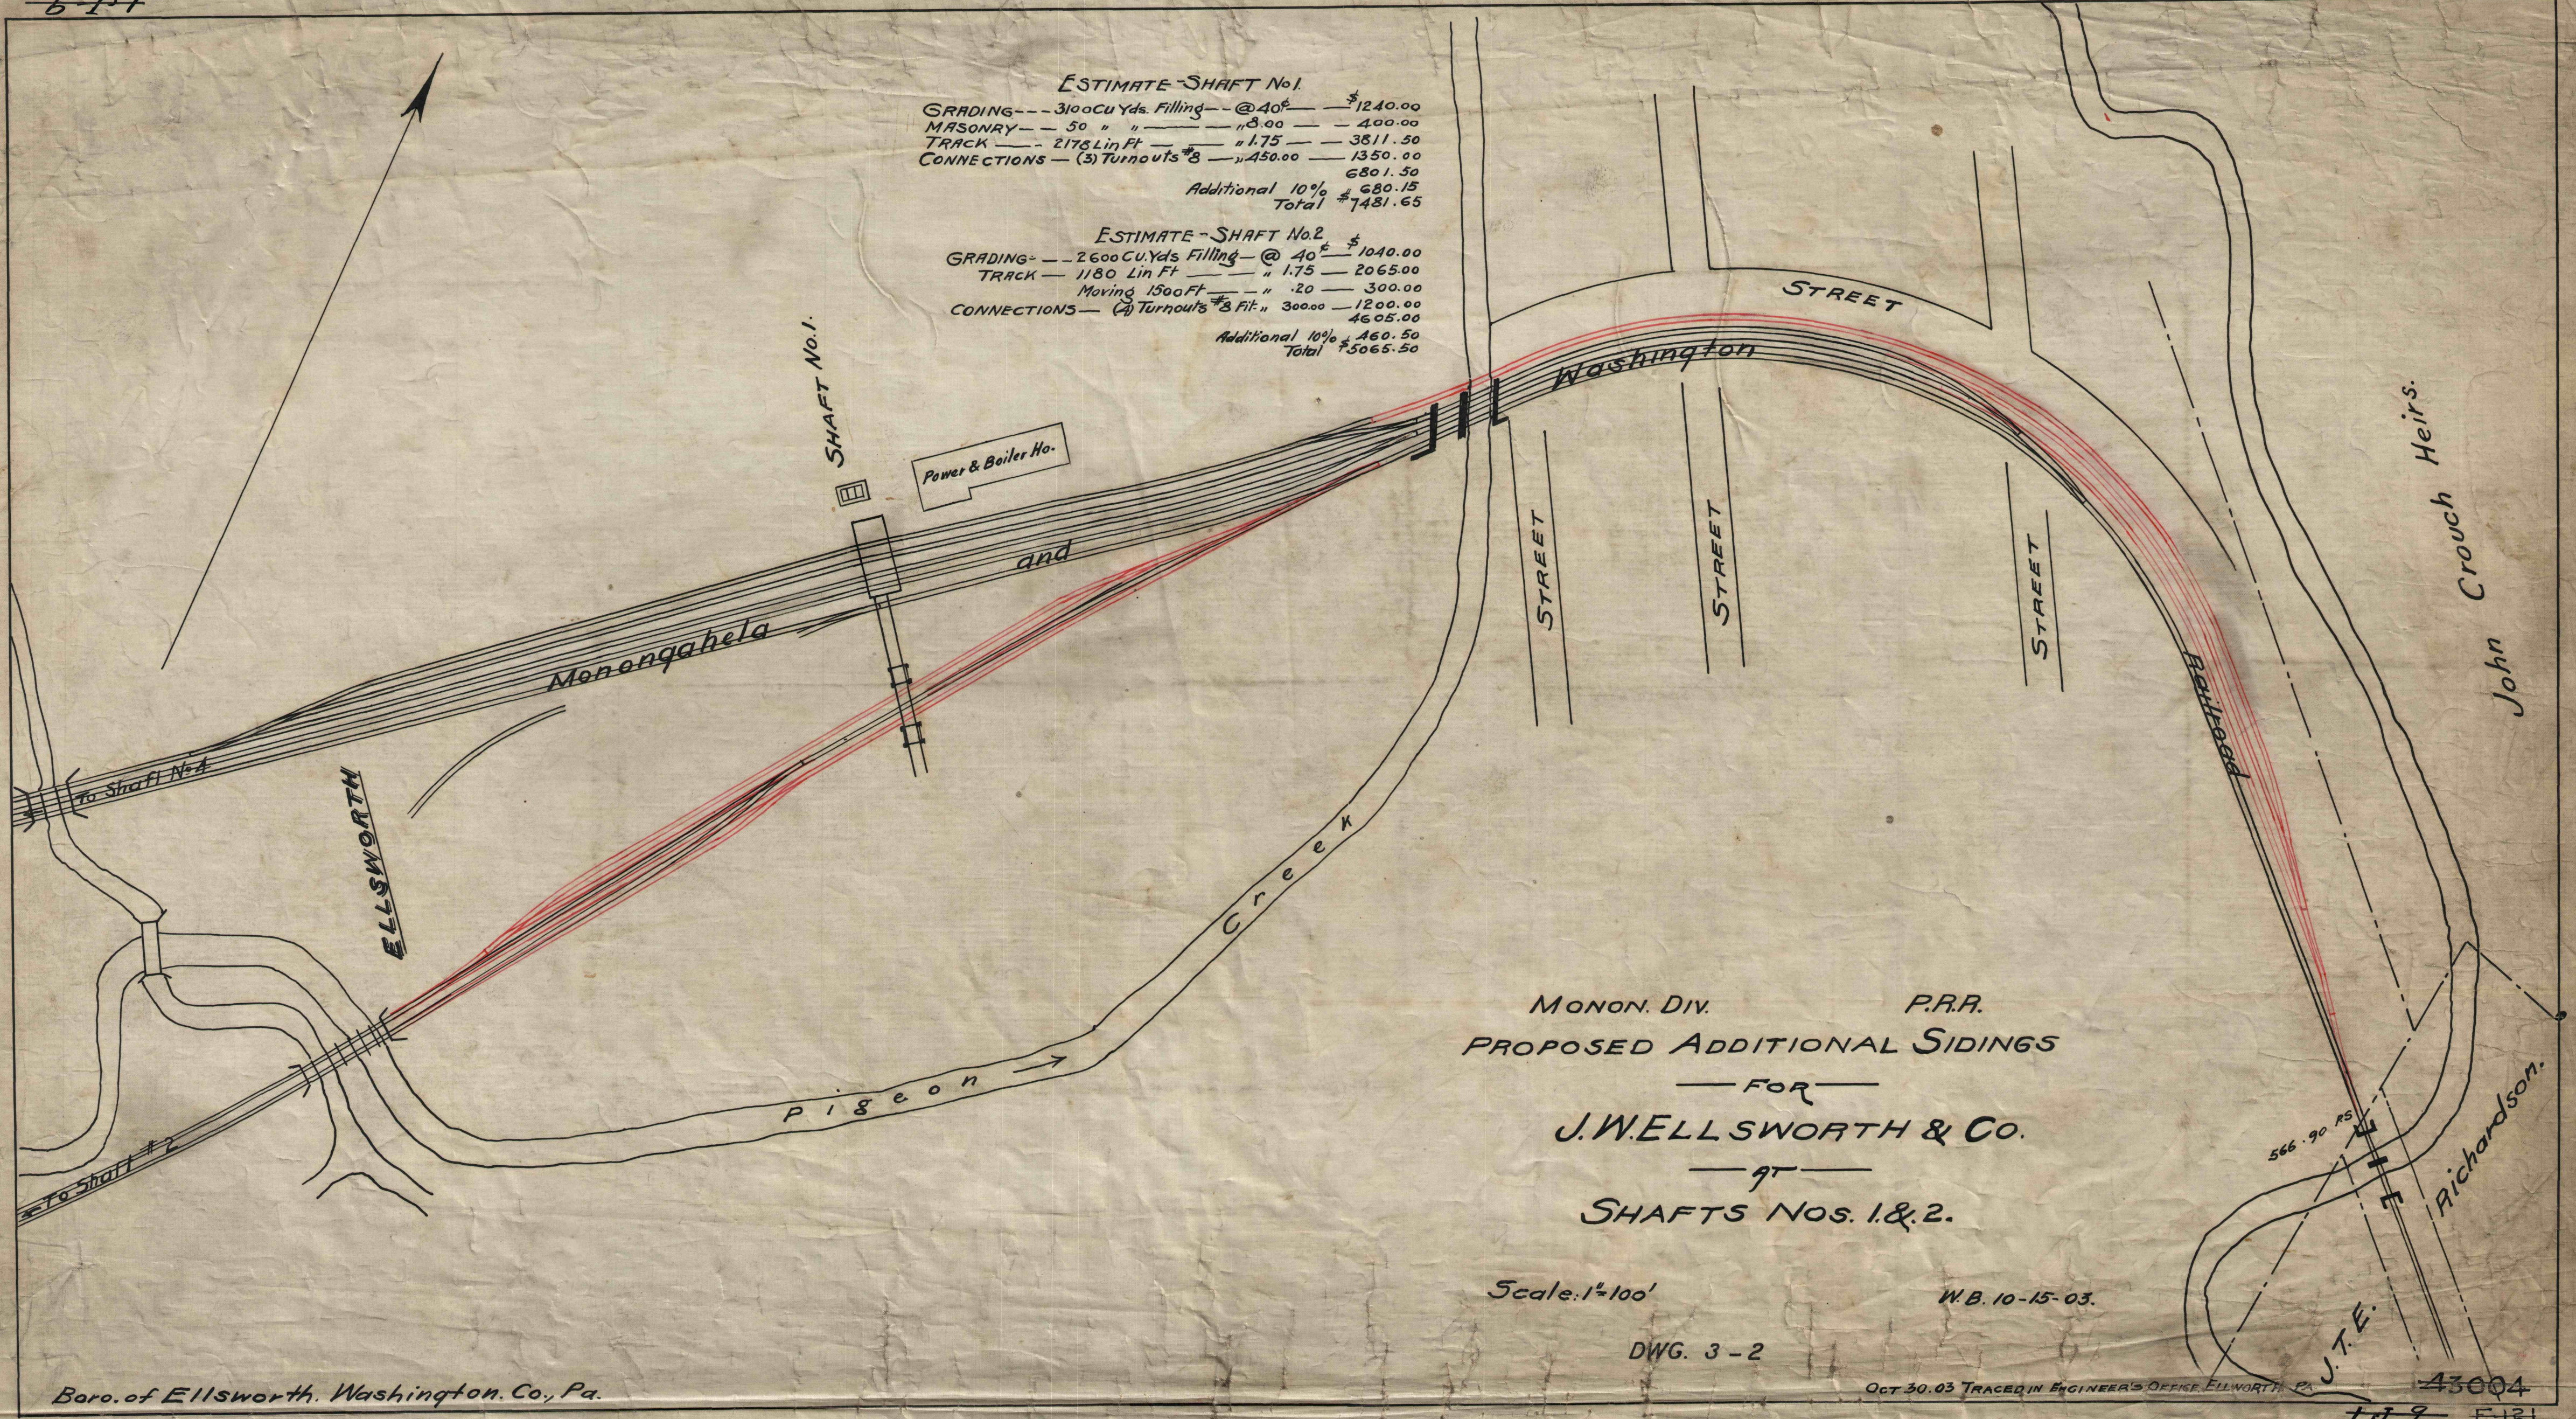

MONON. DIV. P.R.R.
 PROPOSED ADDITIONAL SIDINGS
 FOR
J.W. ELLSWORTH & CO.
 AT
 SHAFTS NOS. 1 & 2.

Scale: 1"=100'

W.B. 10-15-03.

DWG. 3-2

Boro. of Ellsworth, Washington, Co., Pa.

OCT 30.03 TRACED IN ENGINEER'S OFFICE, ELLSWORTH, PA.

43004

J.T.E. 109 E121