
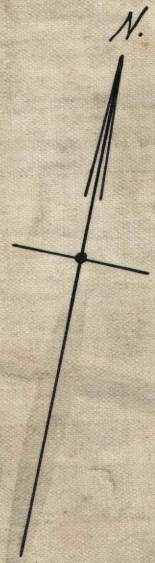


~~F 155~~

~~1-12~~

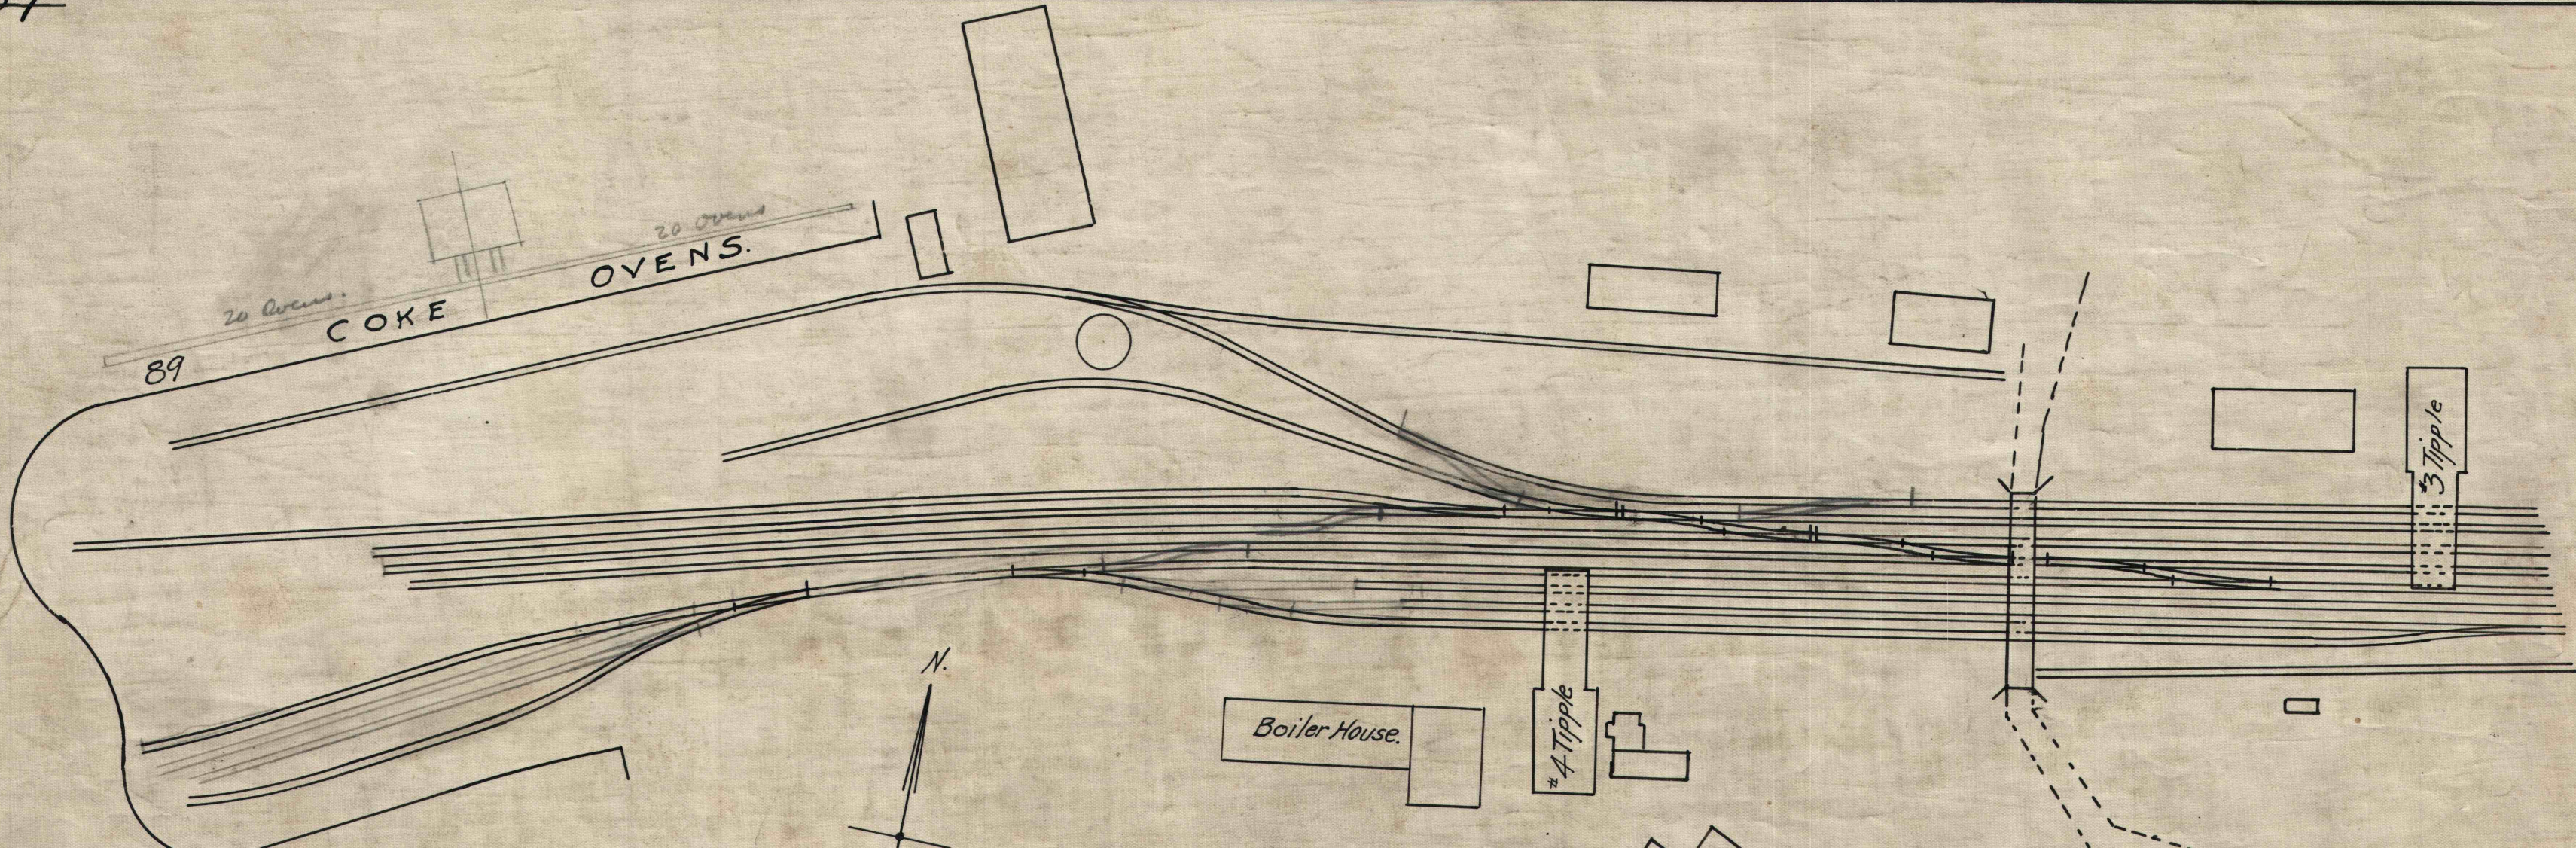

ELLSWORTH COLLIERIES CO.  
 Map showing No. 4 Tipple Tracks.  
 at  
 COKEBURG.  
 Scale 1" = 100' Ellsworth, Dec. 24, 1915.

DWG. 3-3

~~1-12~~  
~~F 155~~