


PLAN OF BOILER ROOM.

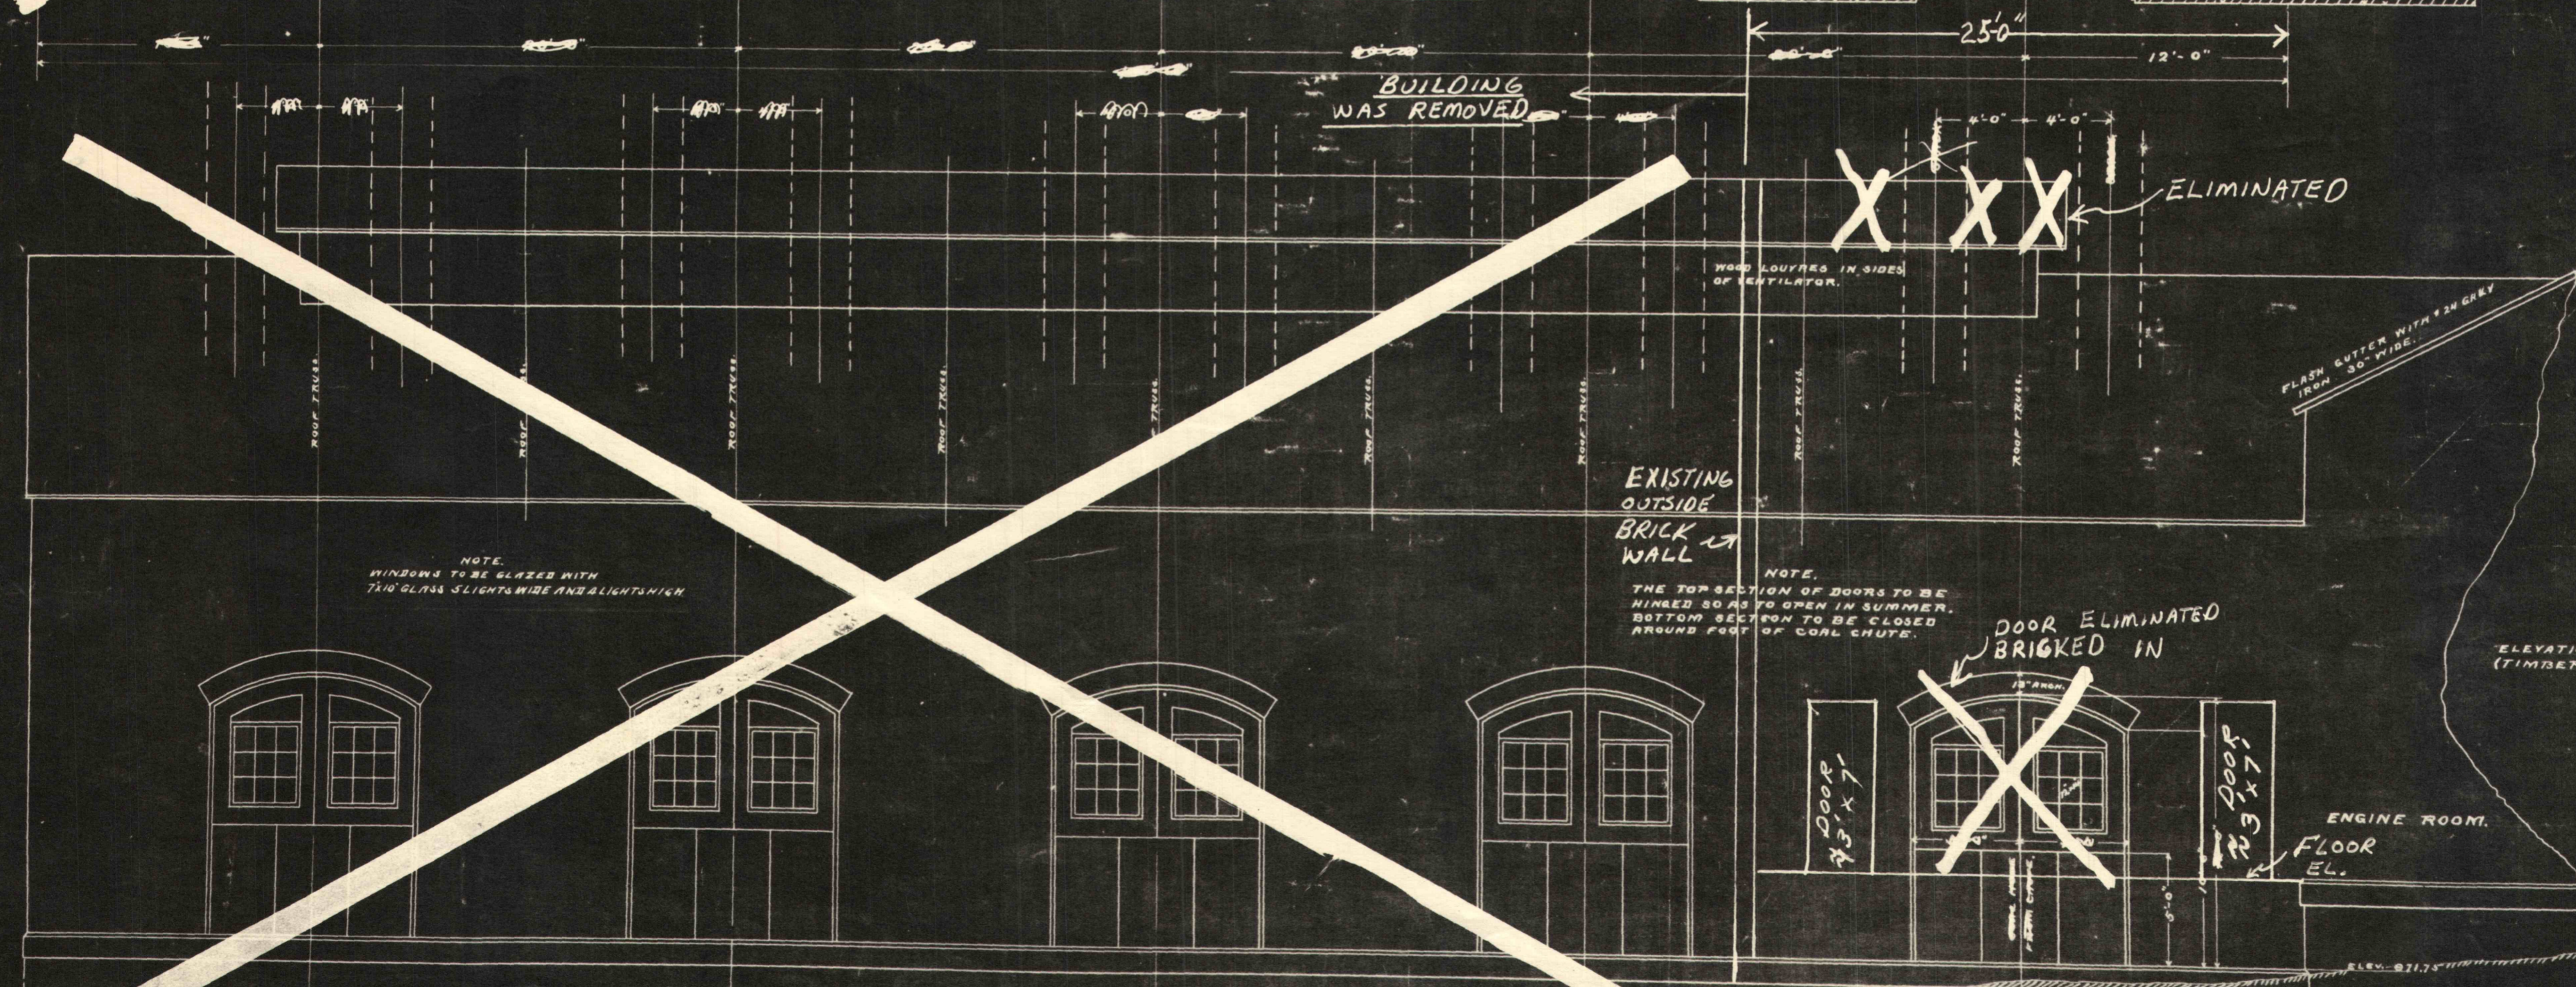

NOTE.
WINDOWS TO BE GLAZED WITH
7x10 GLASS SLIGHTLY WIDE AND ALIGHTS HIGH

EXISTING
OUTSIDE
BRICK
WALL

NOTE.
THE TOP SECTION OF DOORS TO BE
HINGED SO AS TO OPEN IN SUMMER.
BOTTOM SECTION TO BE CLOSED
AROUND FOOT OF COAL CHUTE.

DOOR ELIMINATED
BRICKED IN

ELEVATION OF TOP OF SHAFT.
(TIMBERS & COPING) 974.75

SIDE ELEVATION OF BOILER ROOM.

ENGINE & BOILER HOUSE.
SHAFT NO. 1.
JAMES W. ELLSWORTH & CO.

BMC DWG. # 51-HH-14