


See 2-A-15


CLINTON BLOCK COAL CO
COAL & SURFACE

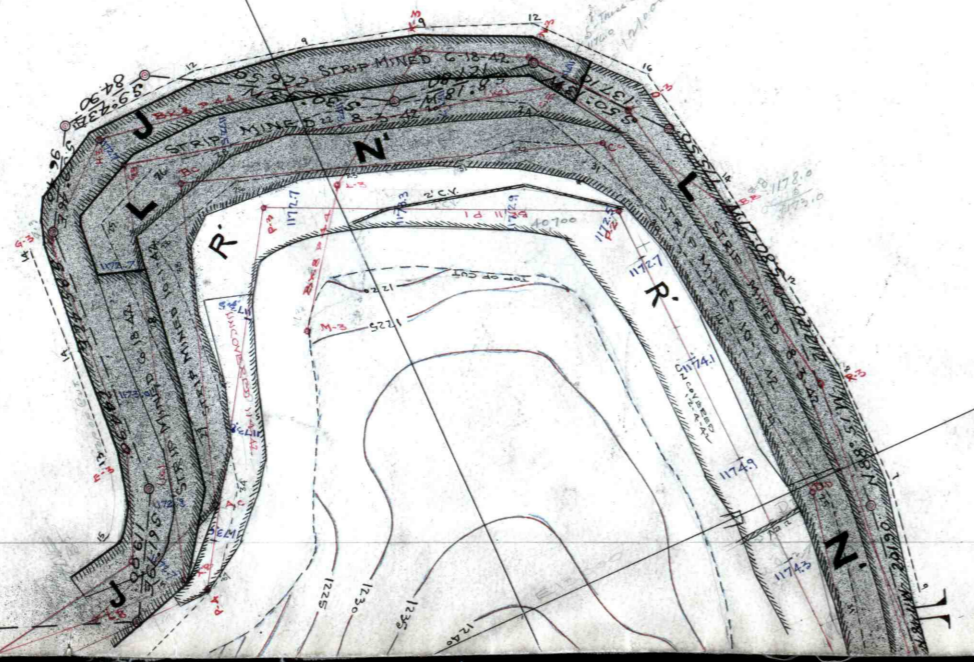

ALBERTA CULLOUGH

FOR SURVEY SEE CLINTON BLOCK BK*4 Pg 37

LEBANON BLOCK COAL CO
BOUNDARY LINE

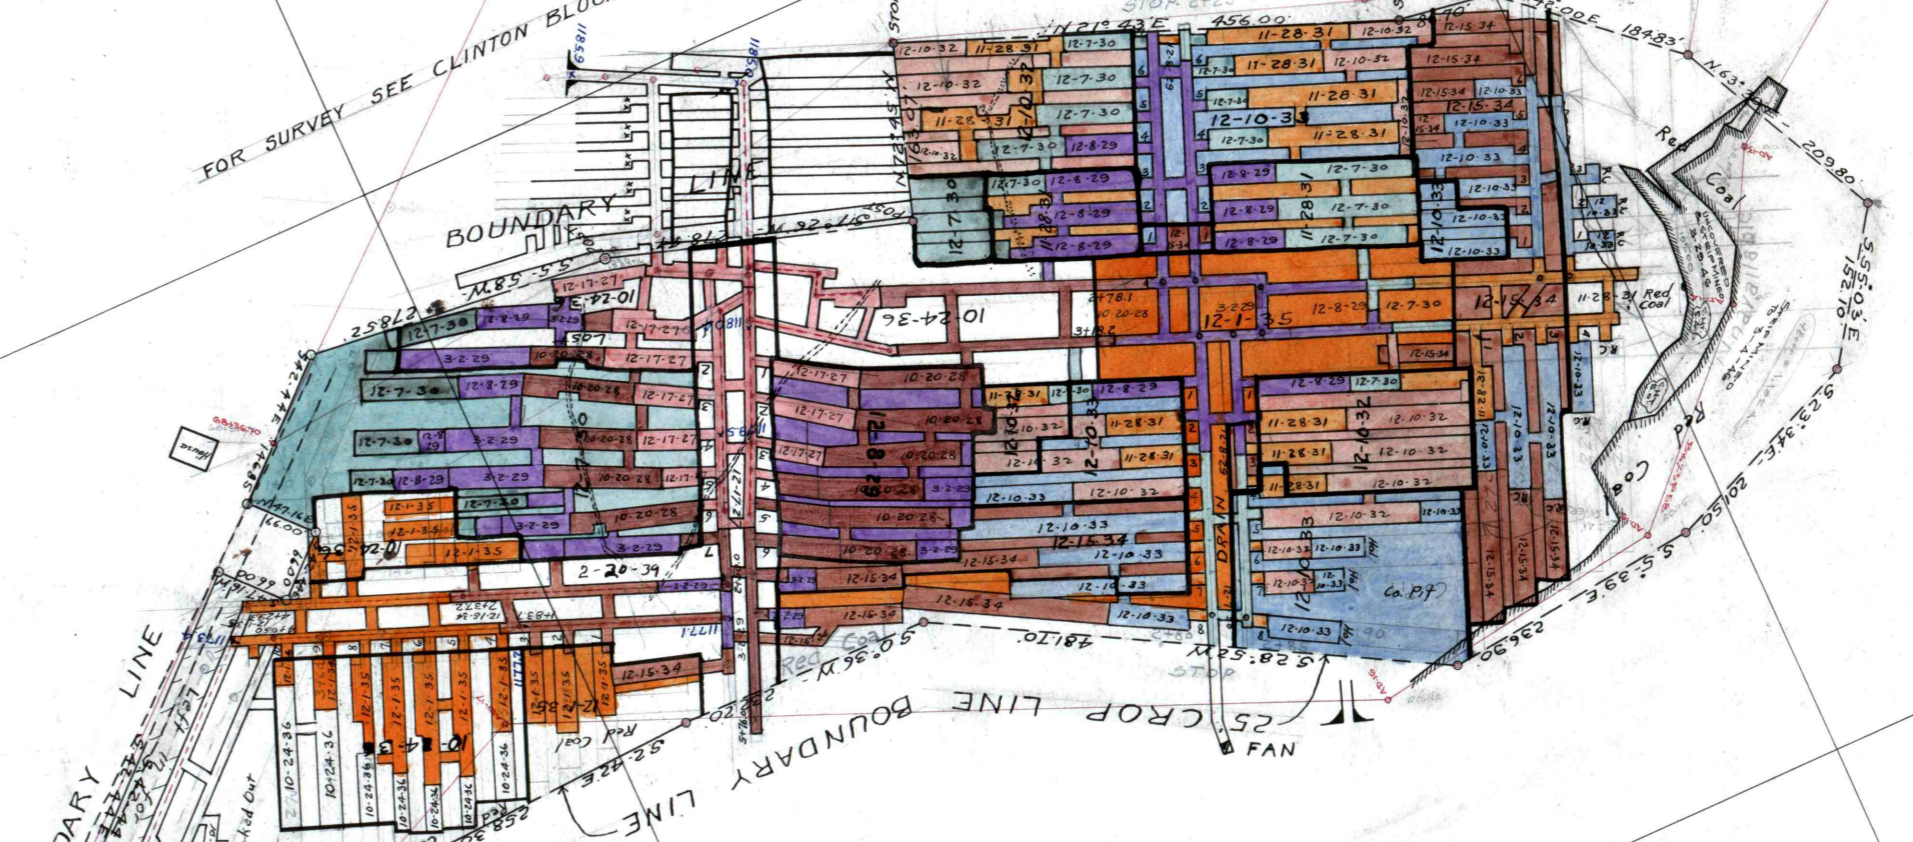

See 2-A-15

387512 1