


387512 2

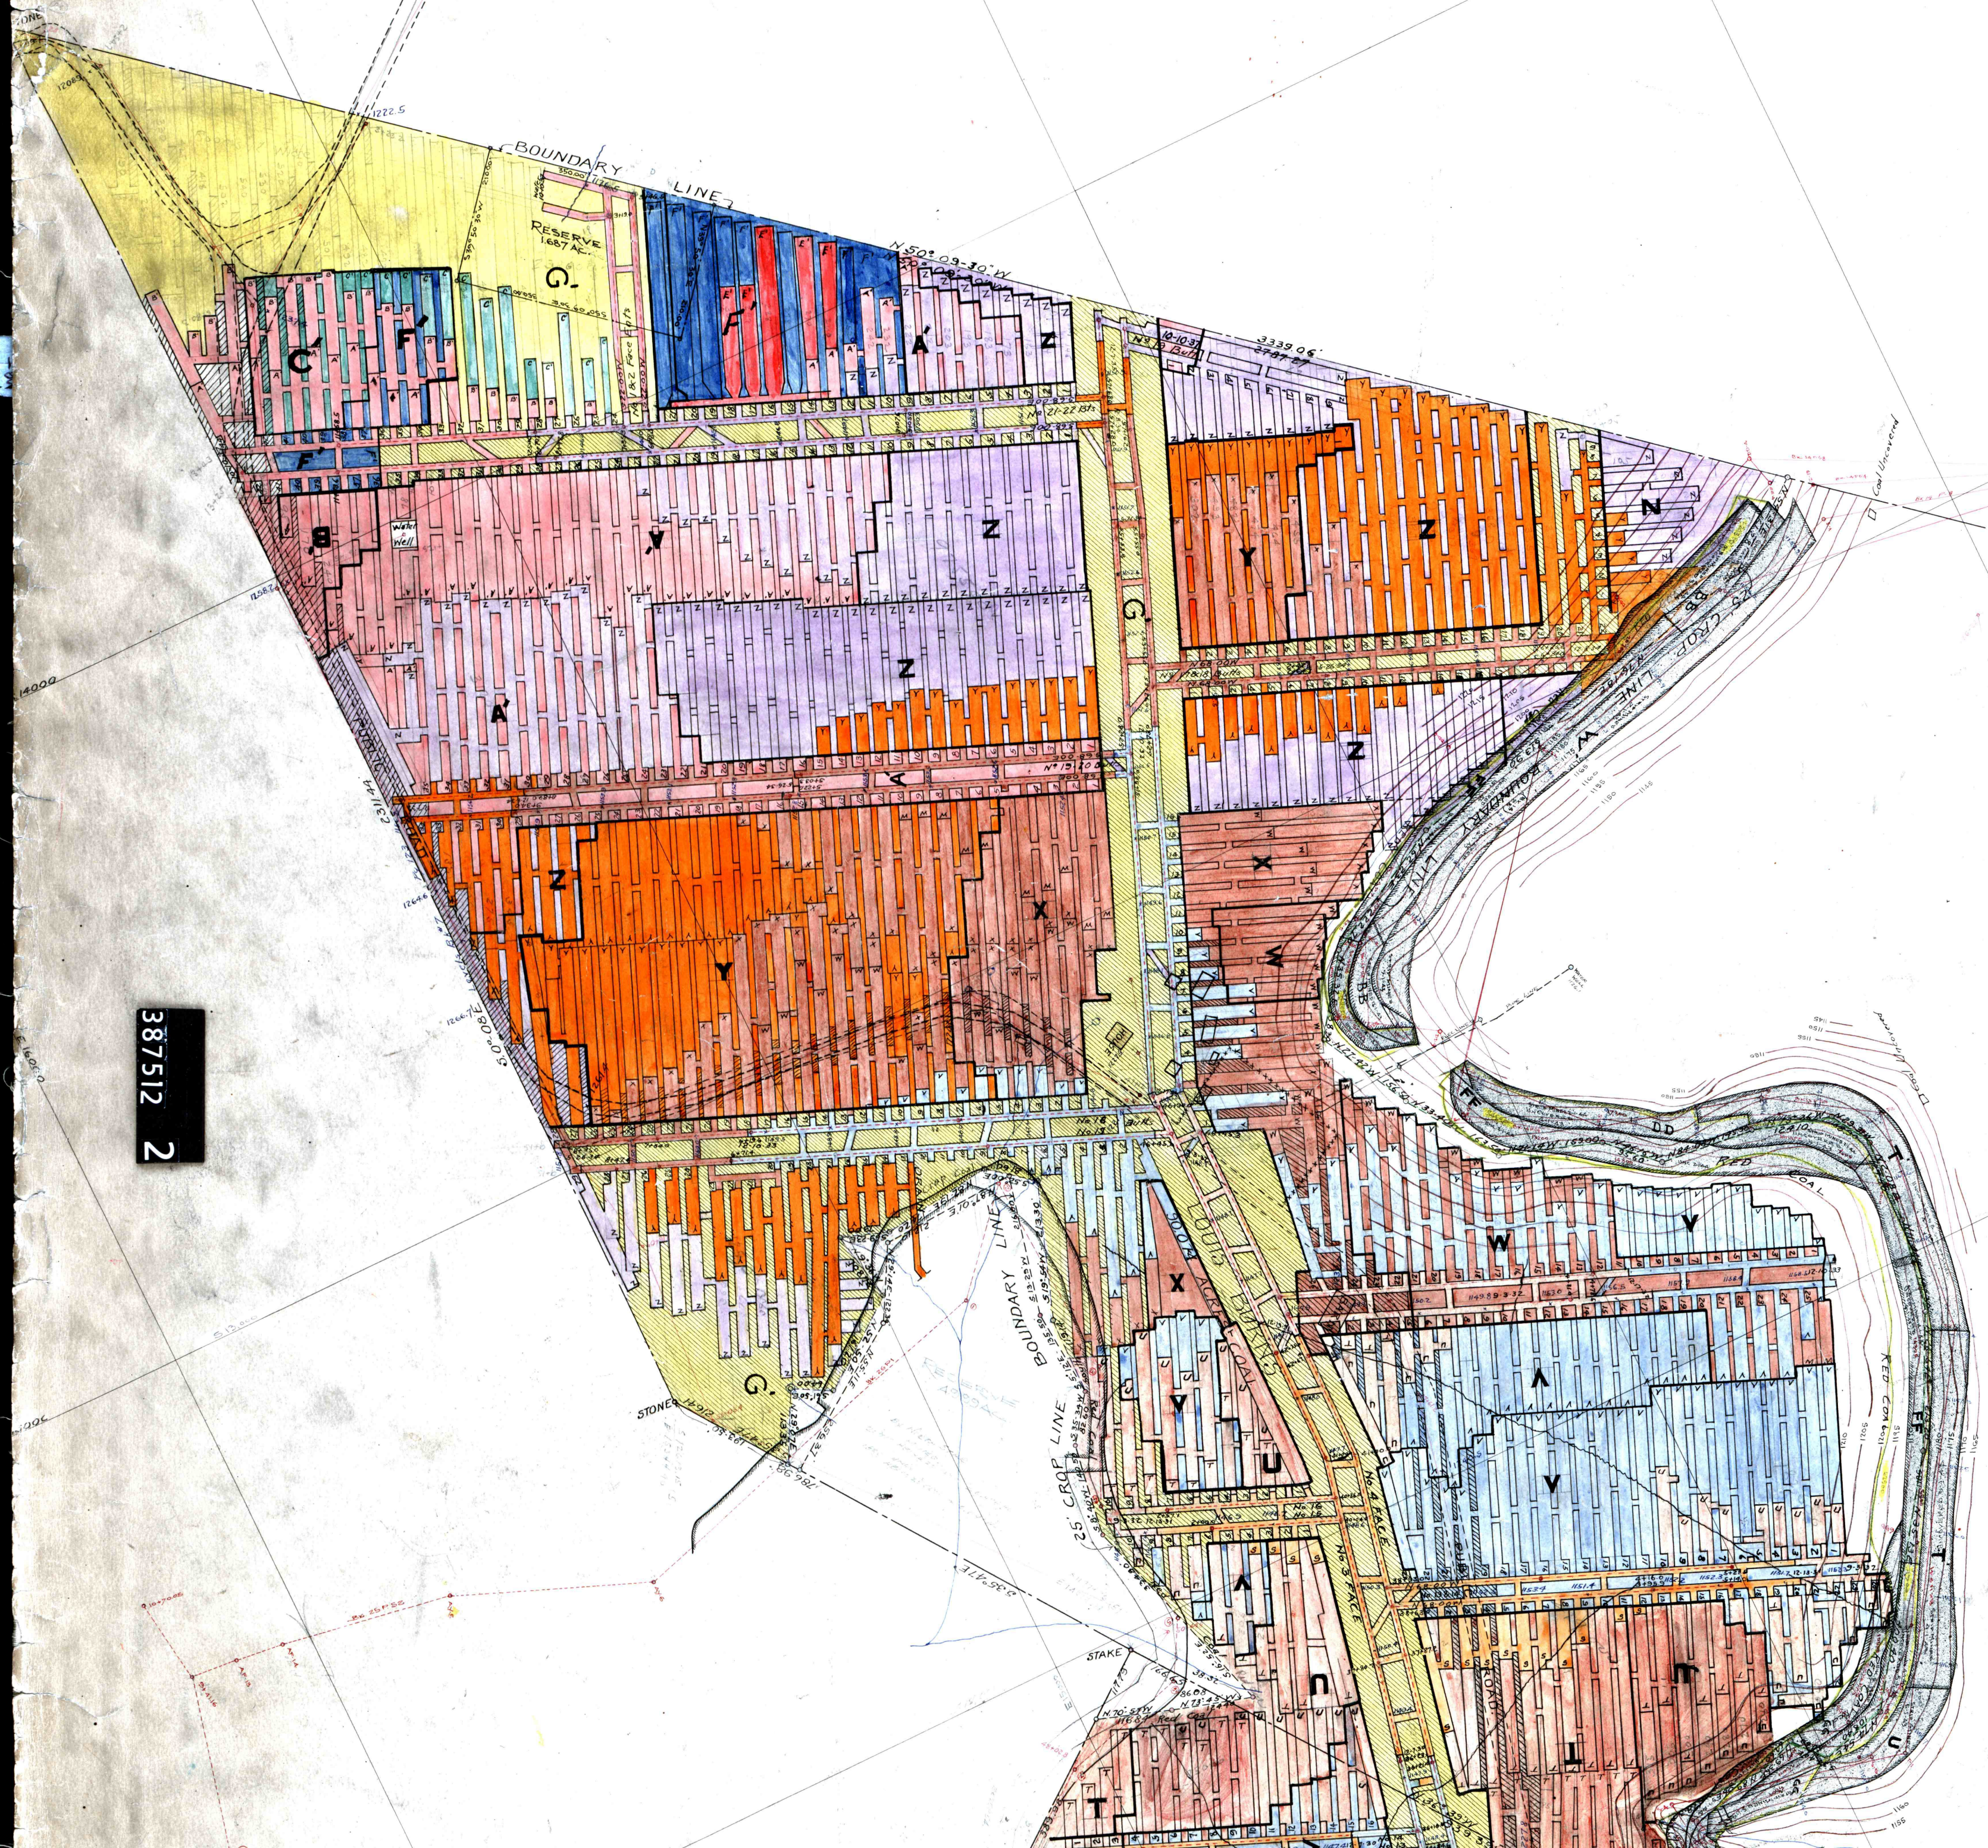

Scale 1:1000



