

K-5200

94500 E

95000 E

95500 E

96000 E


104500 S

104500 S

104500 S

104500 S

104500 S

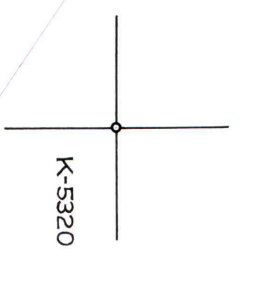


K-5200

94500 E

95000 E

95500 E

96000 E

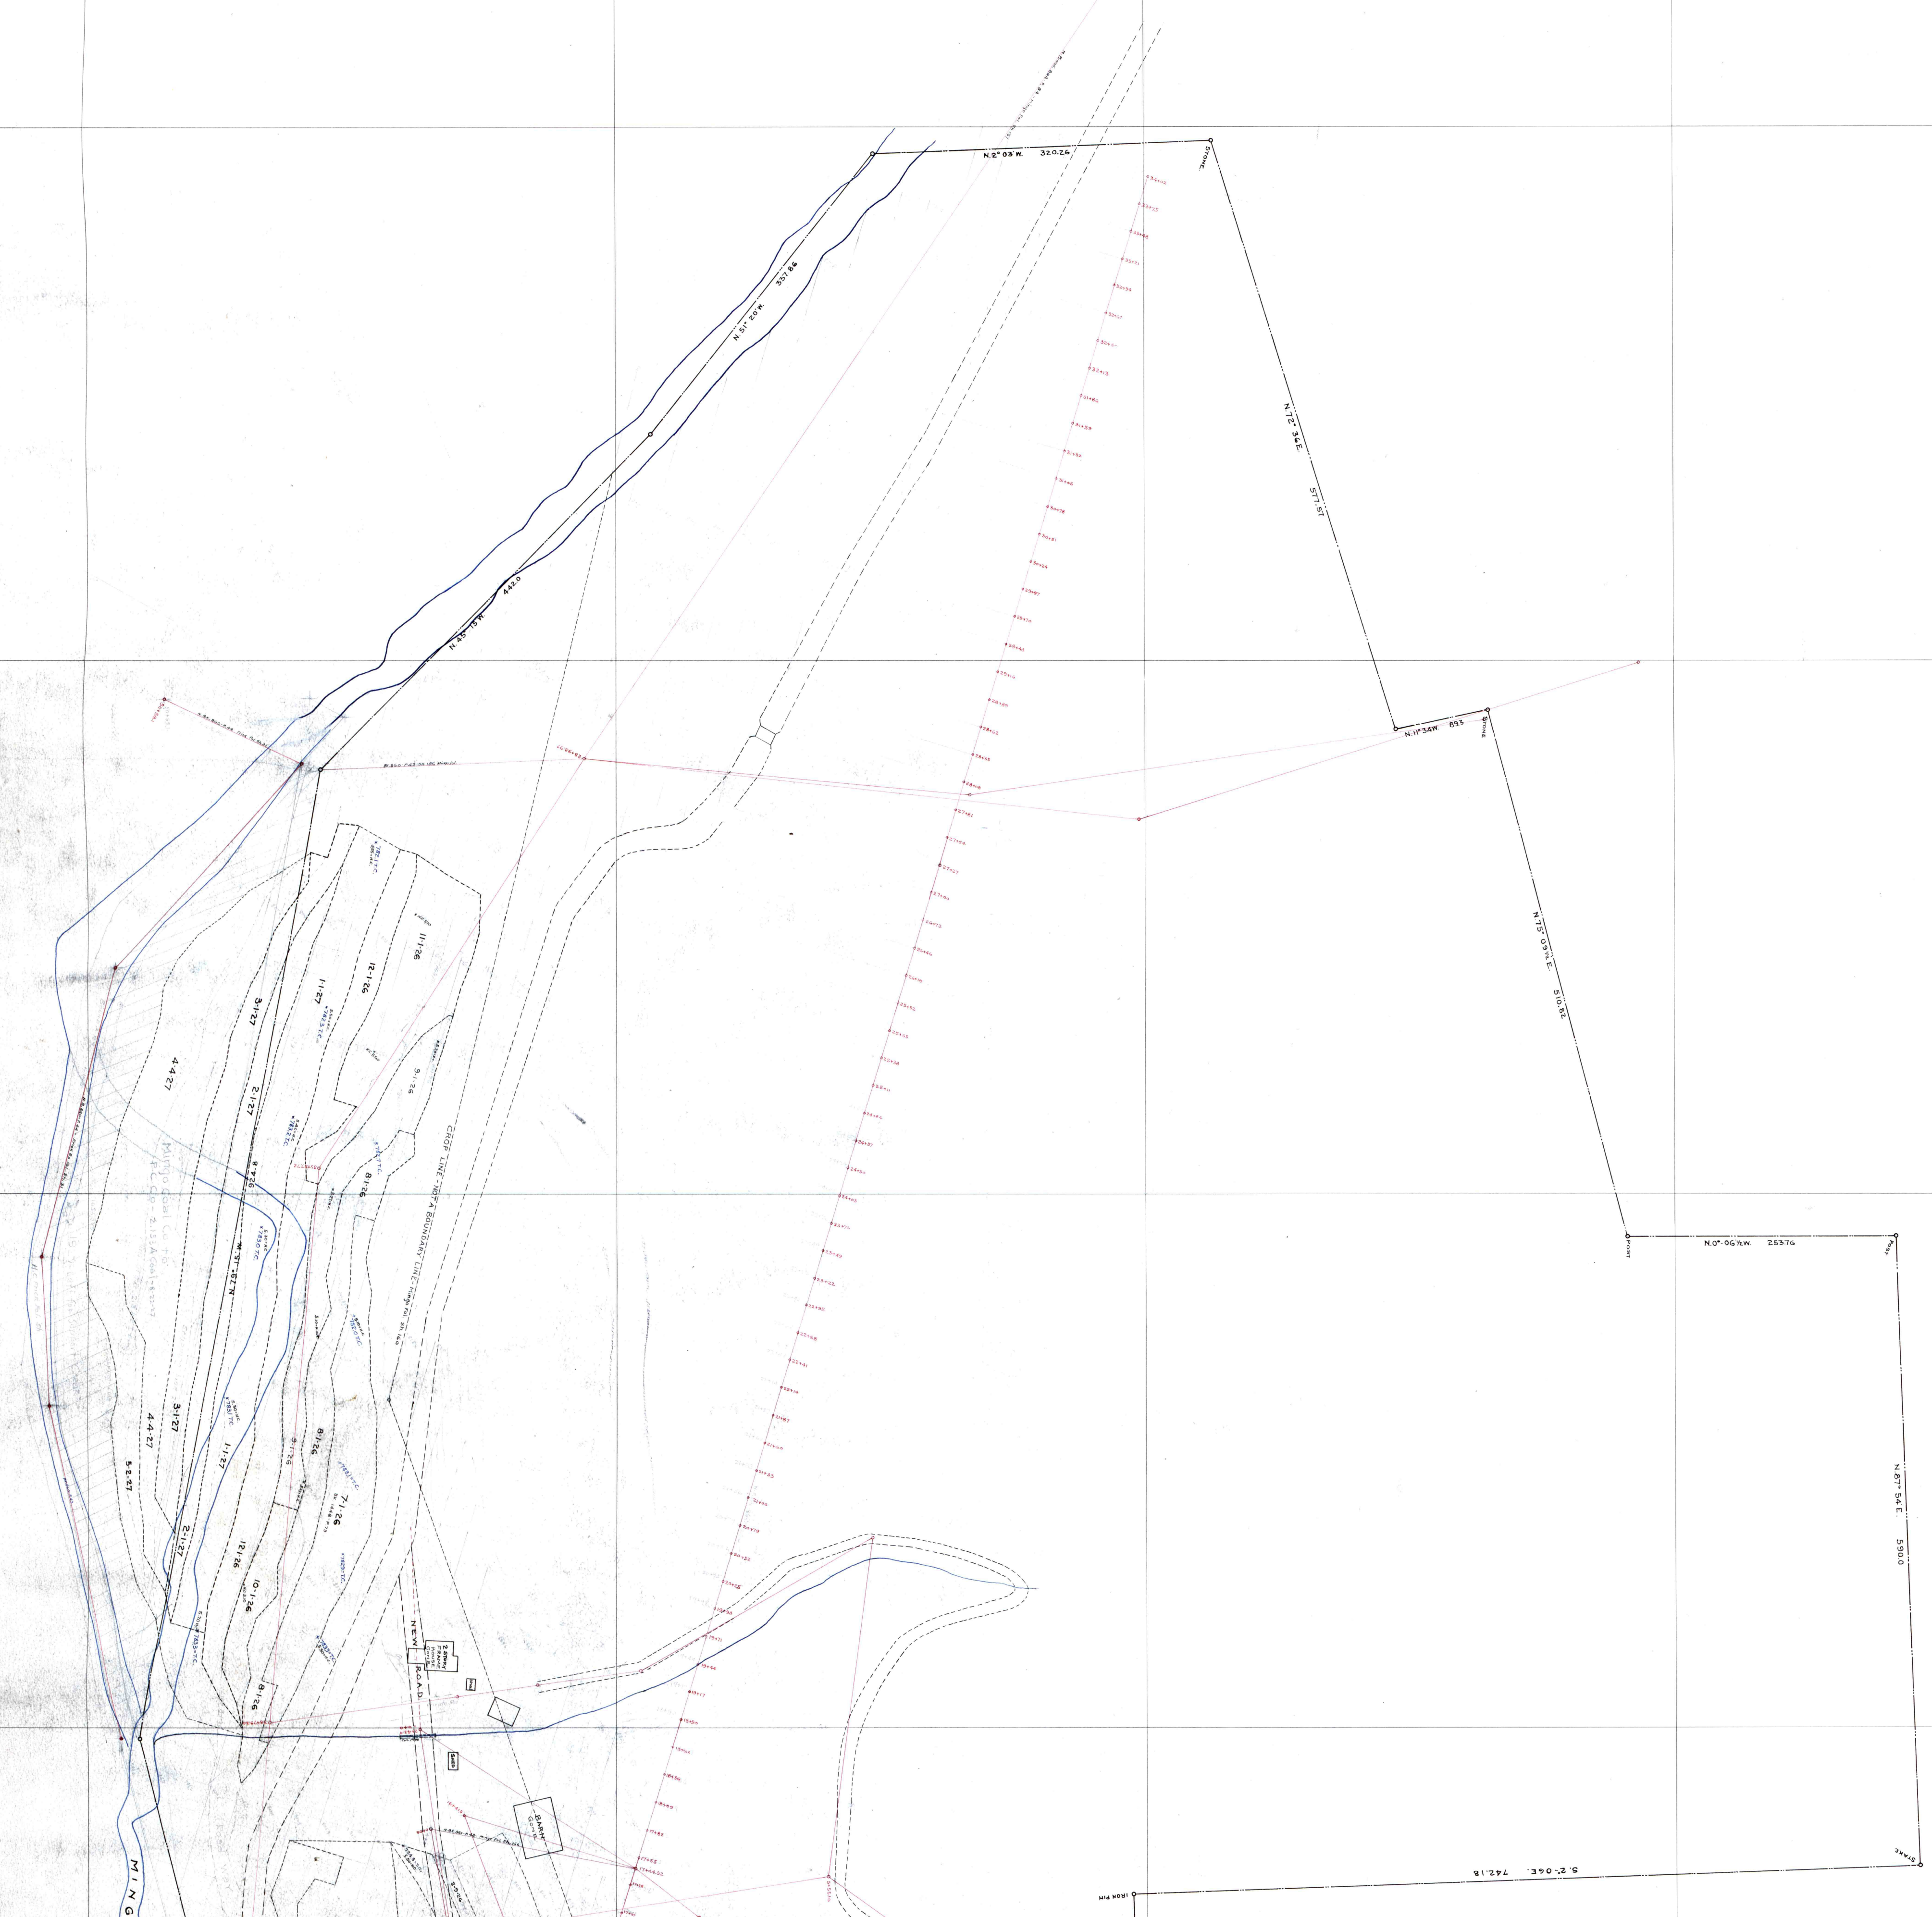

387511 1