


122

ASGD 27

387508 1

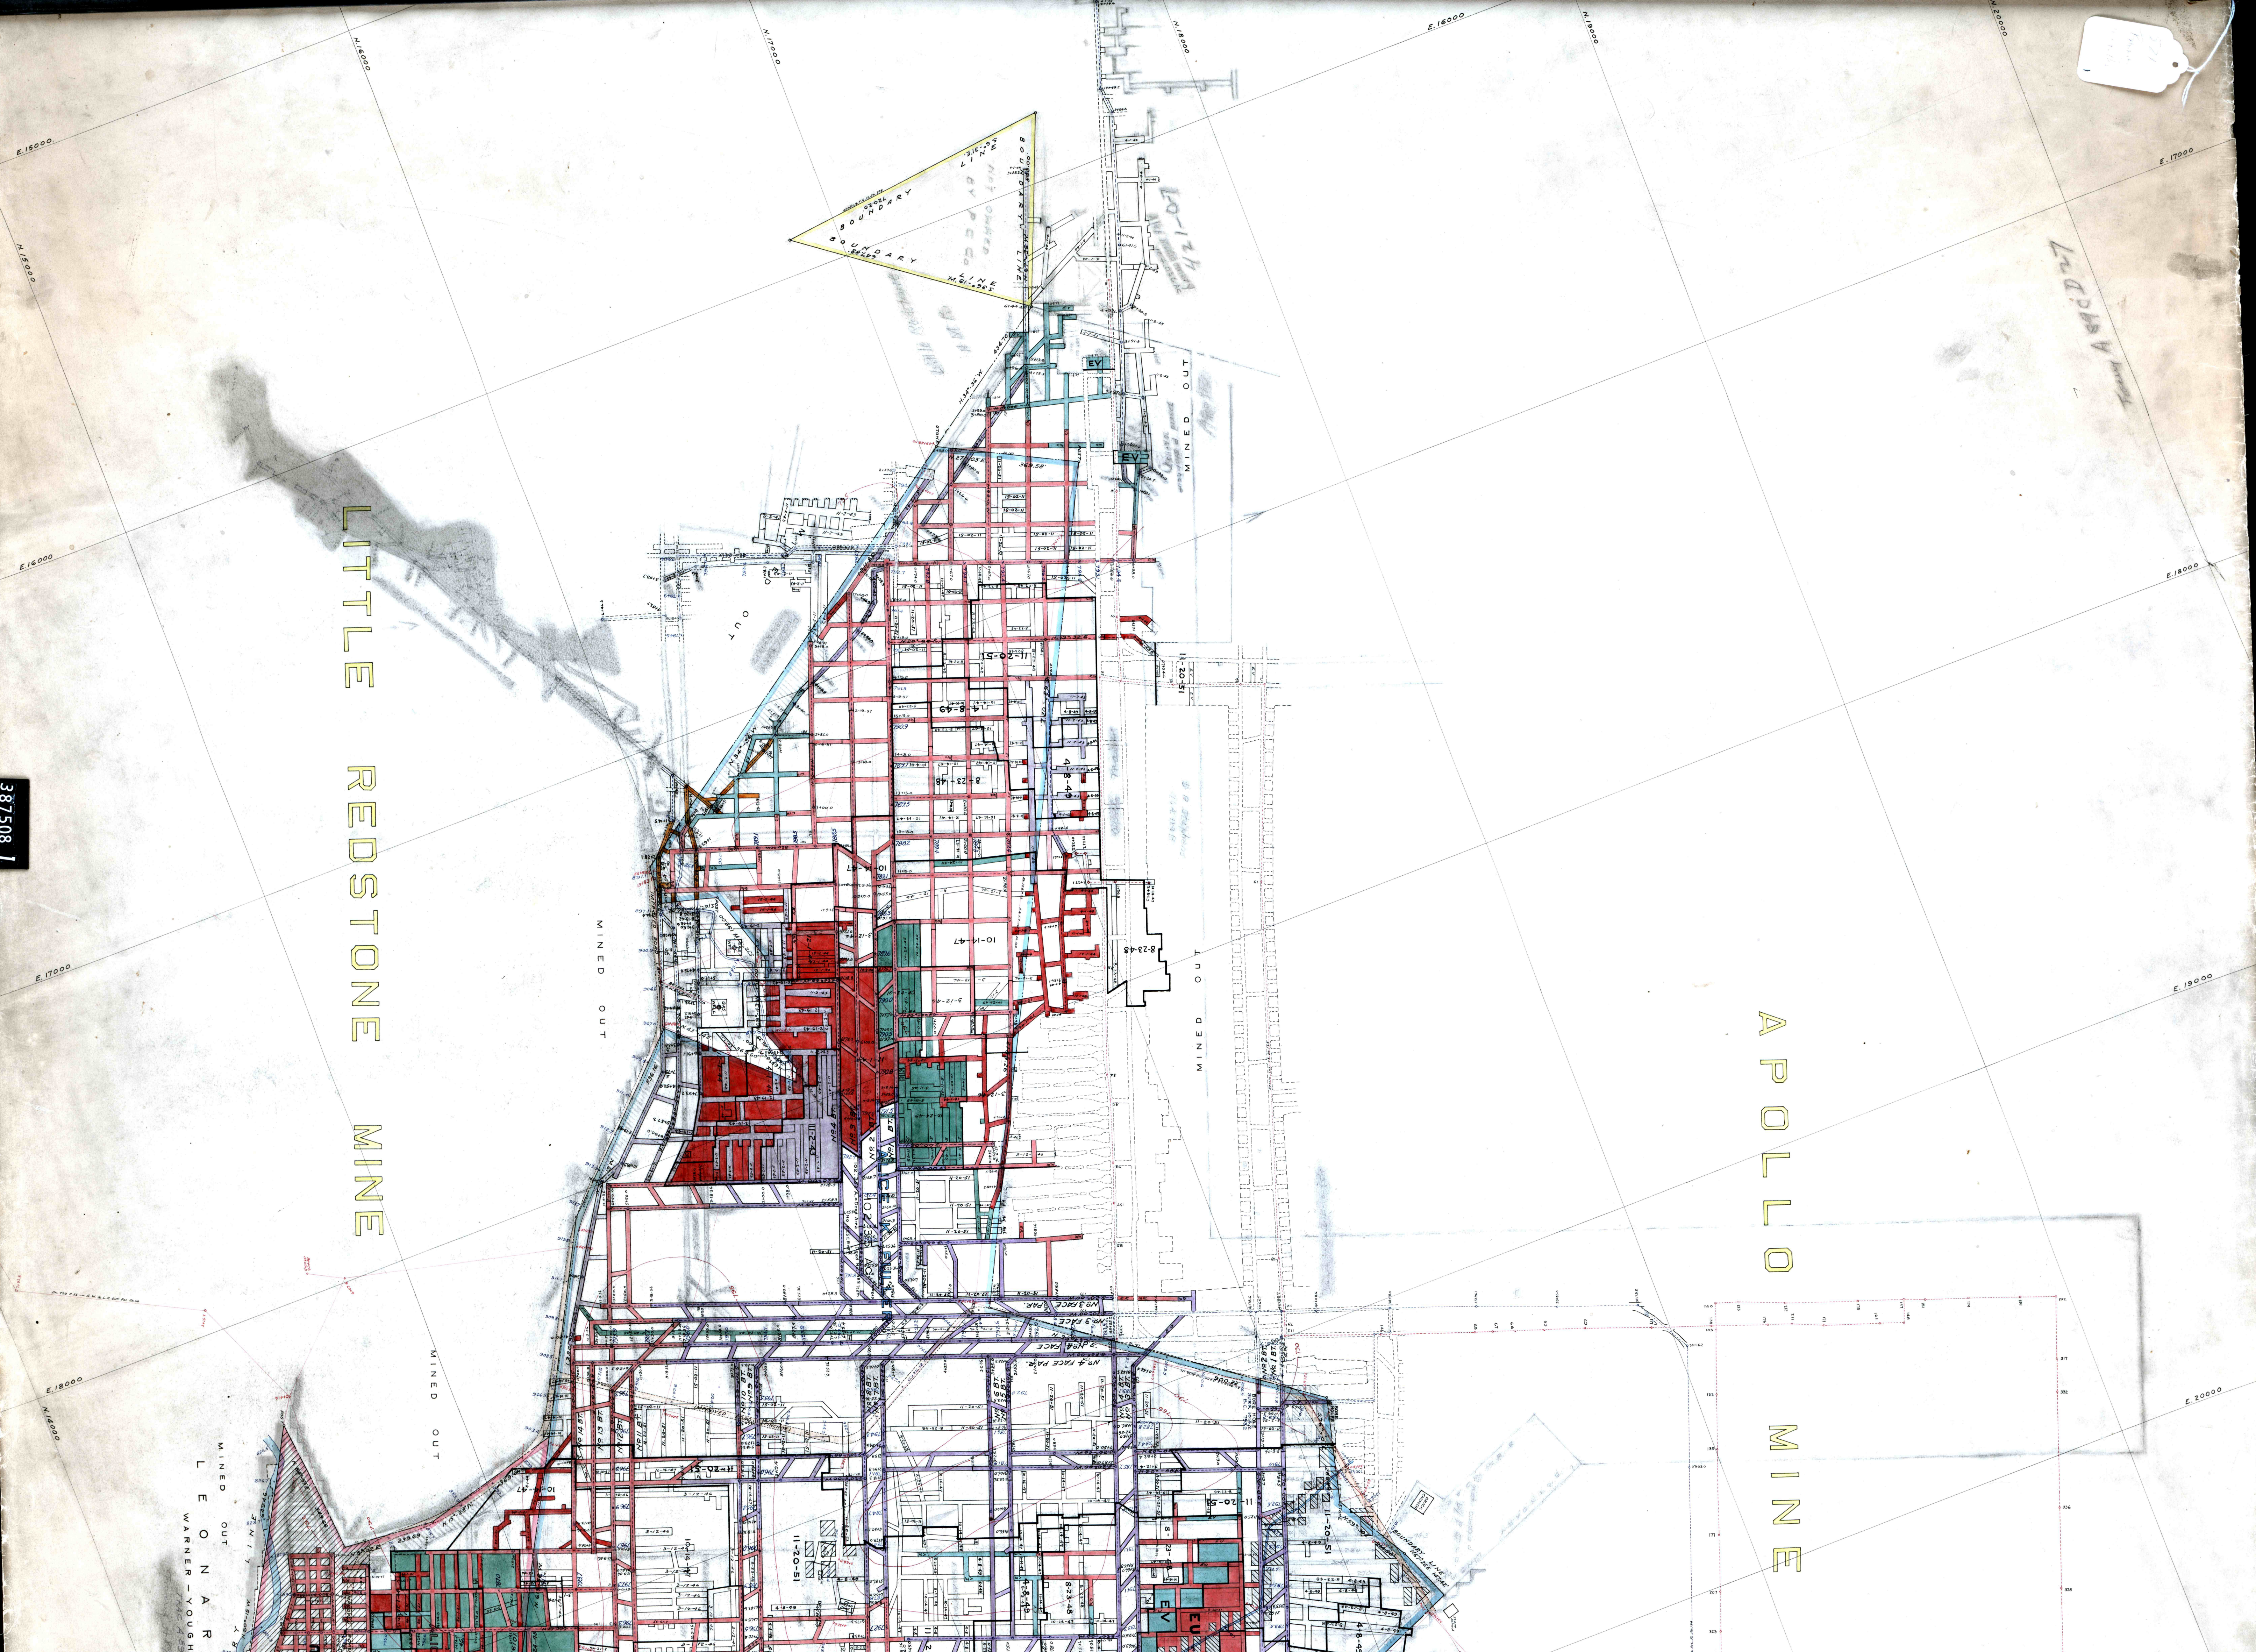

LITTLE REDSTONE MINE

APOLLO MINE

MINED OUT  
LEONARD  
WARNER-YOUGH

MINED OUT

MINED OUT

MINED OUT

MINED OUT

BOUNDARY

