


E REDSTONE MINE

APOLLO MINE

LEONARD MINE
WARNER-YOUGH COAL CO.

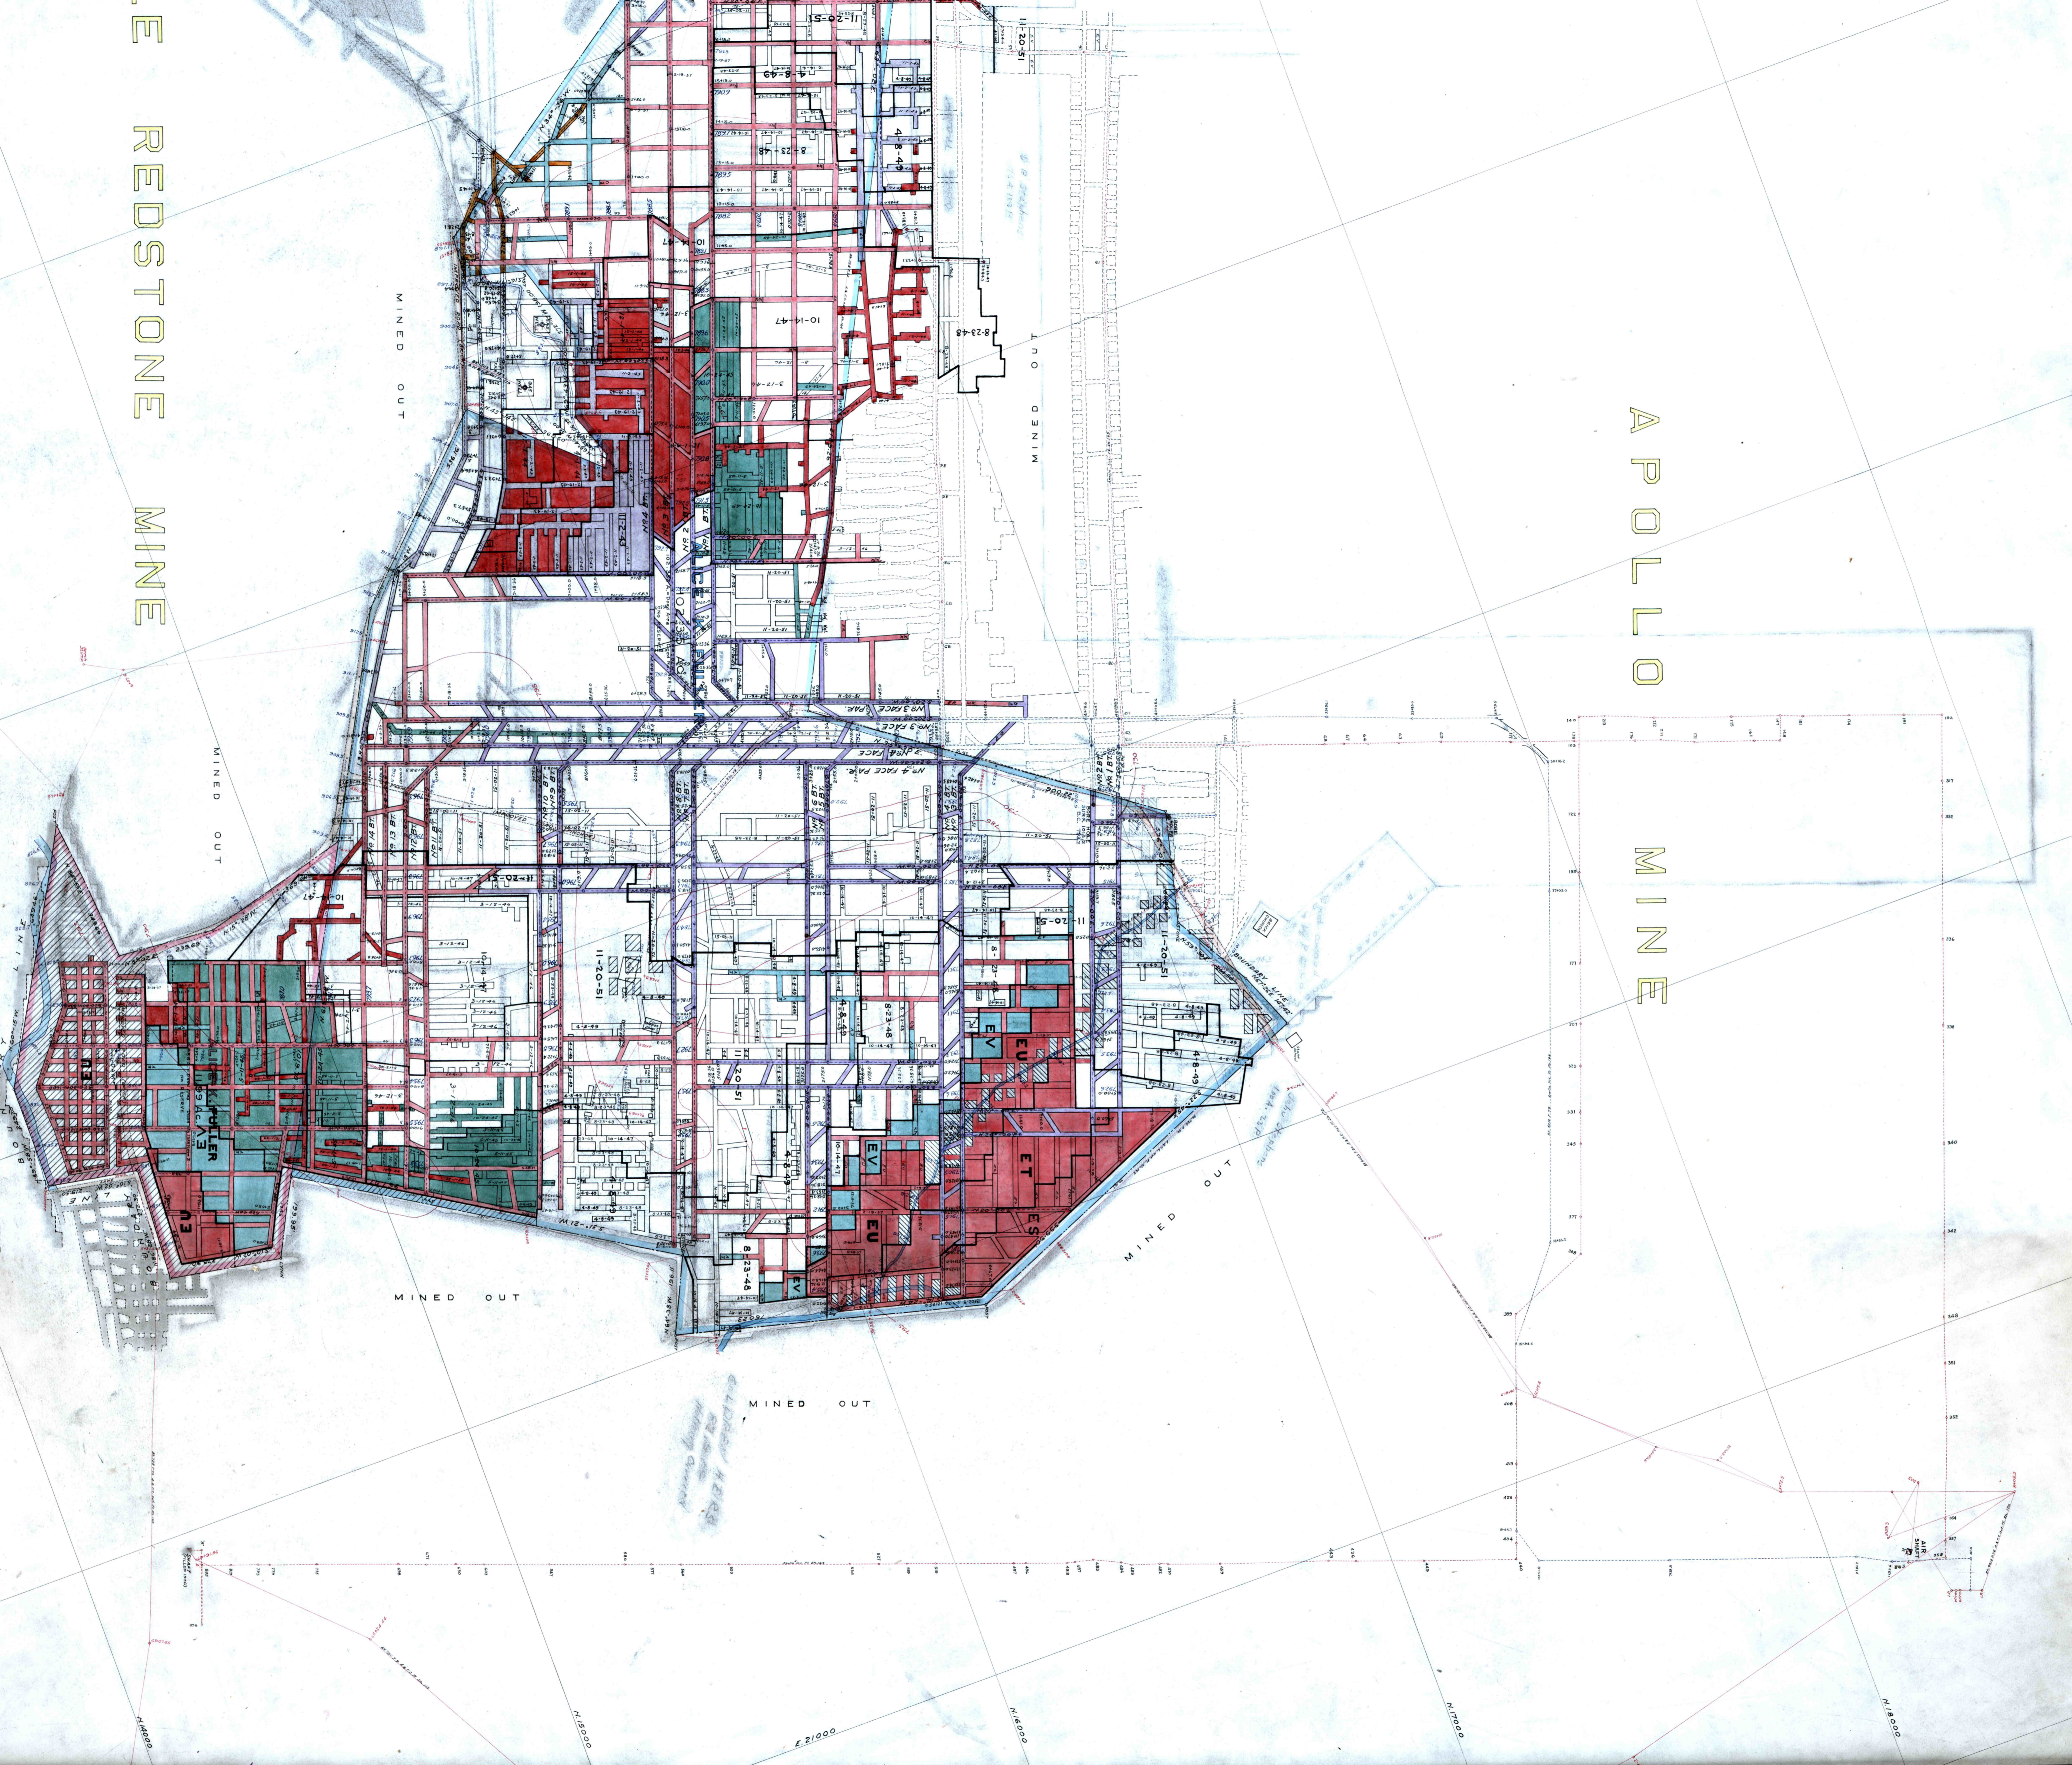

387508 2