


387514 3

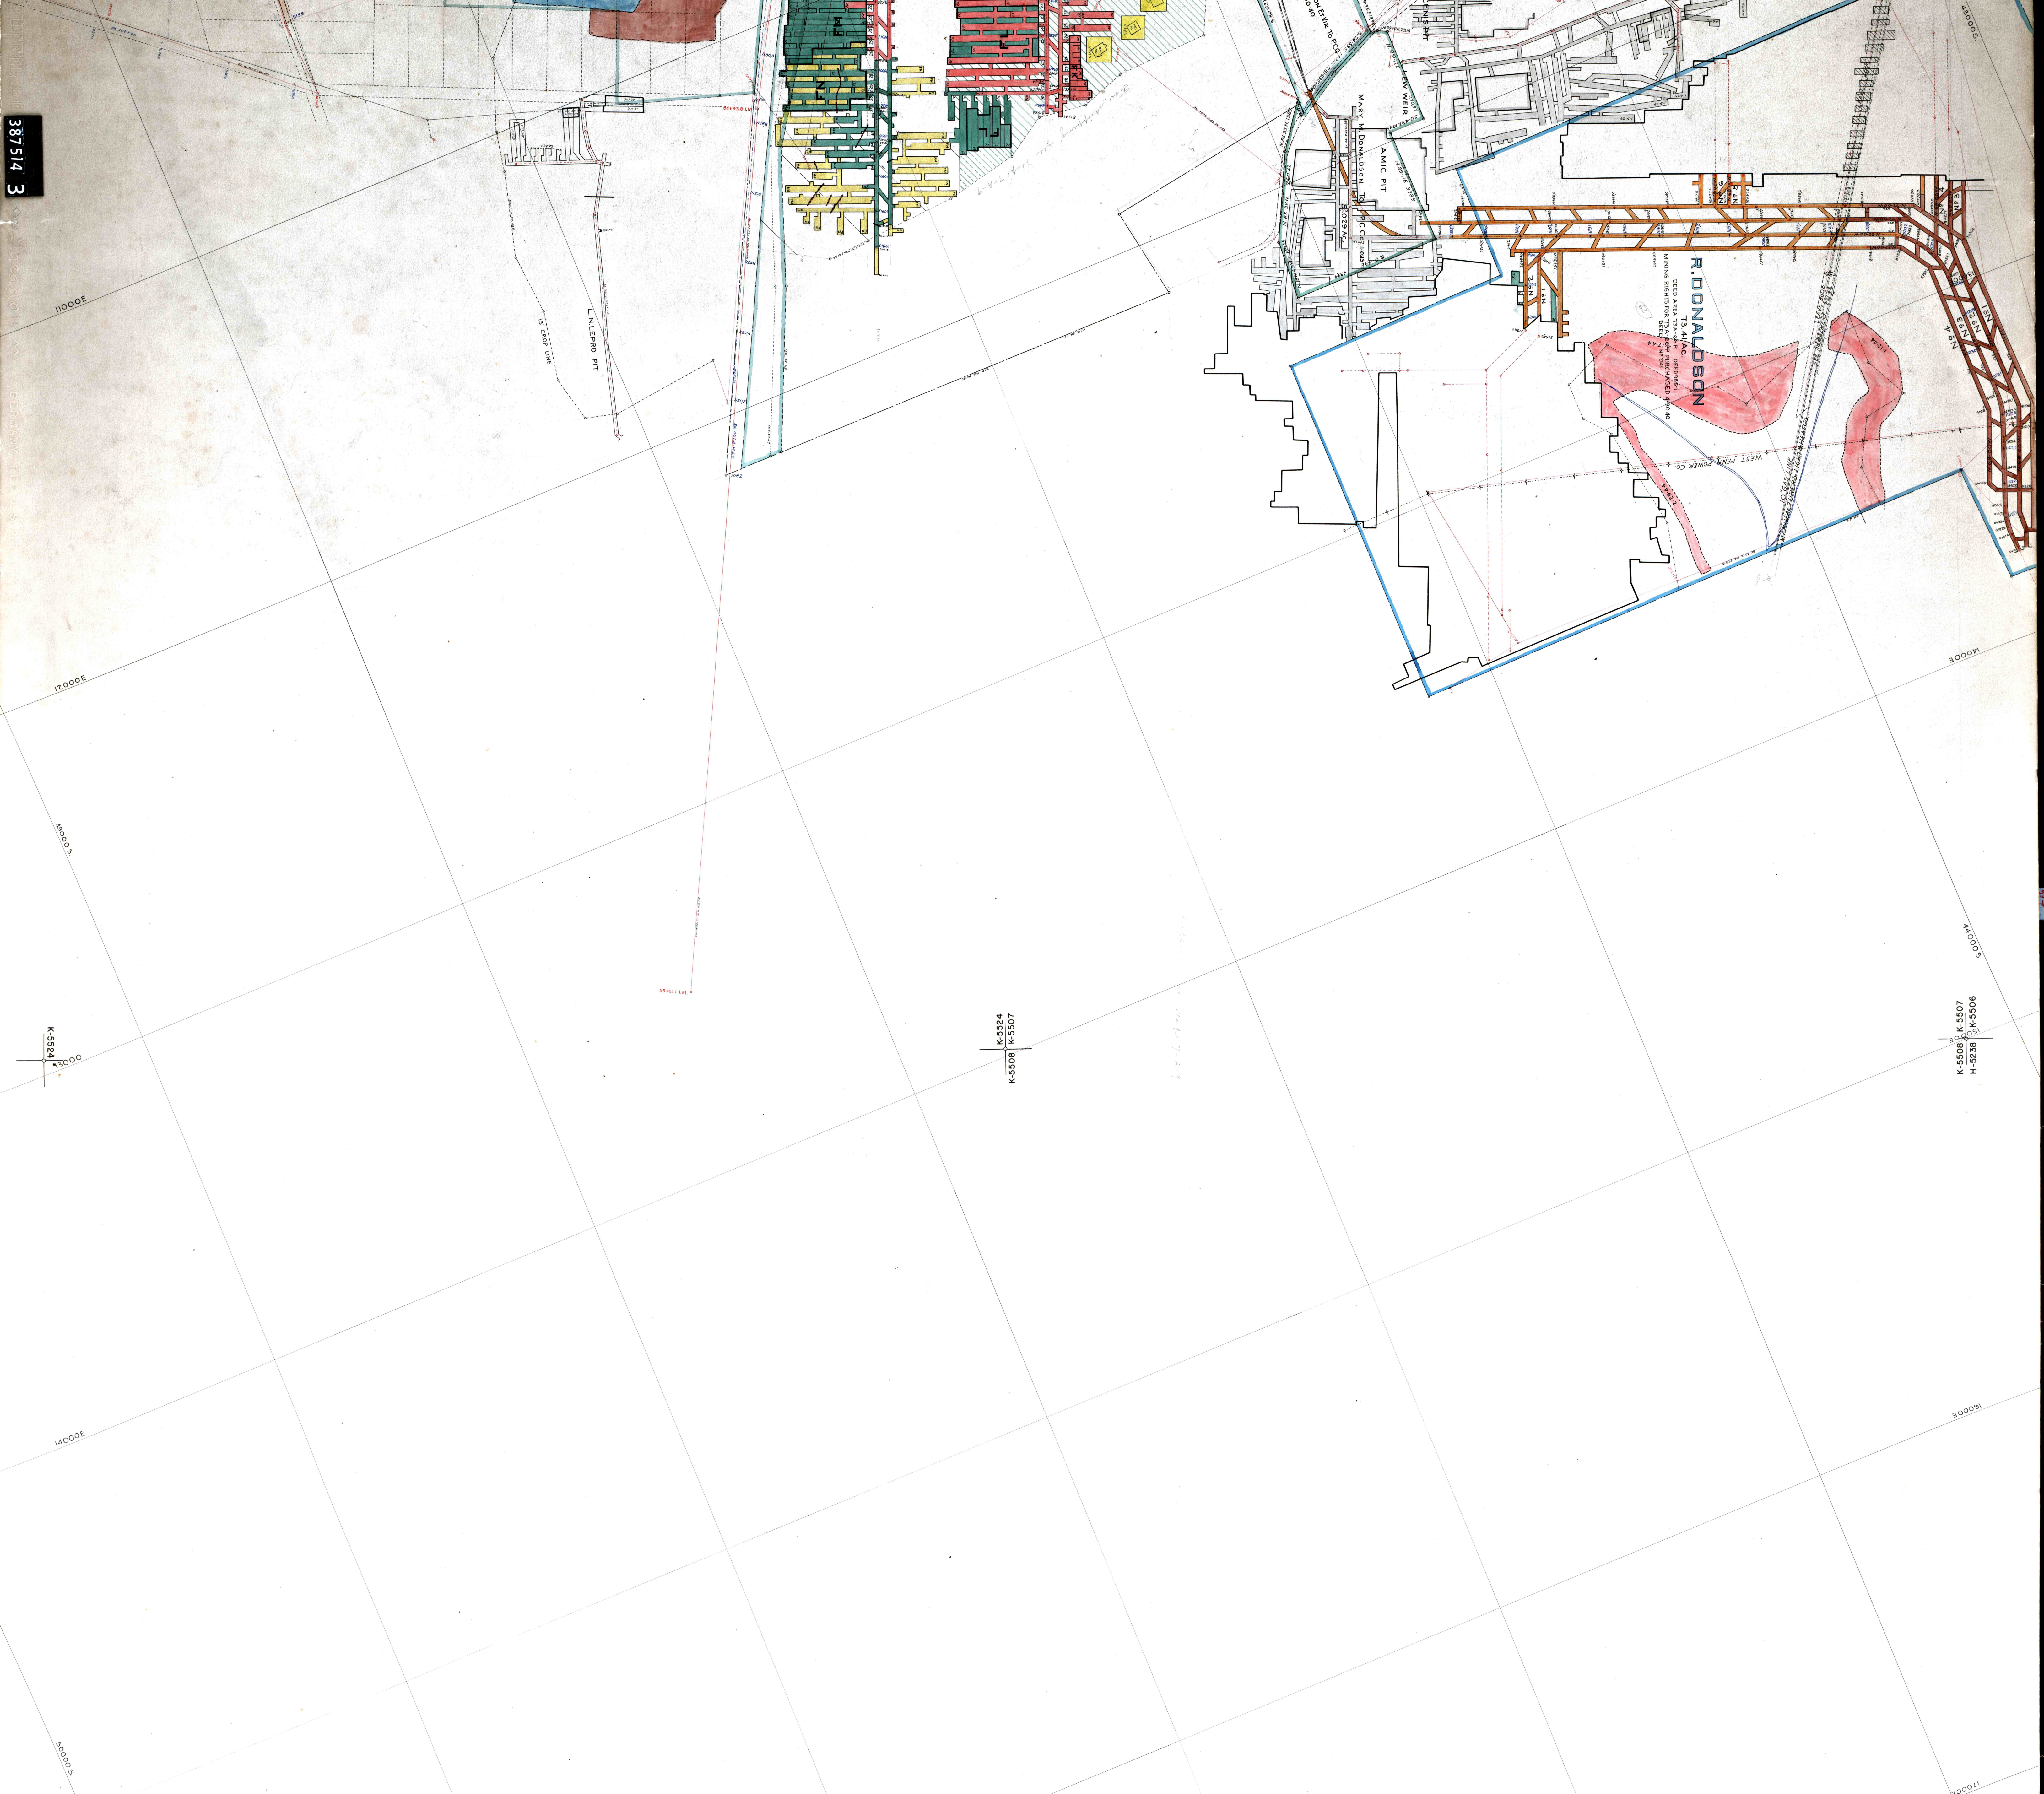

K-5524
K-5508 | K-5507

K-5508 | K-5507
H-5238 | K-5506

K-5524