


JOHN FULLER

1325-H  
92886

1890-D-27

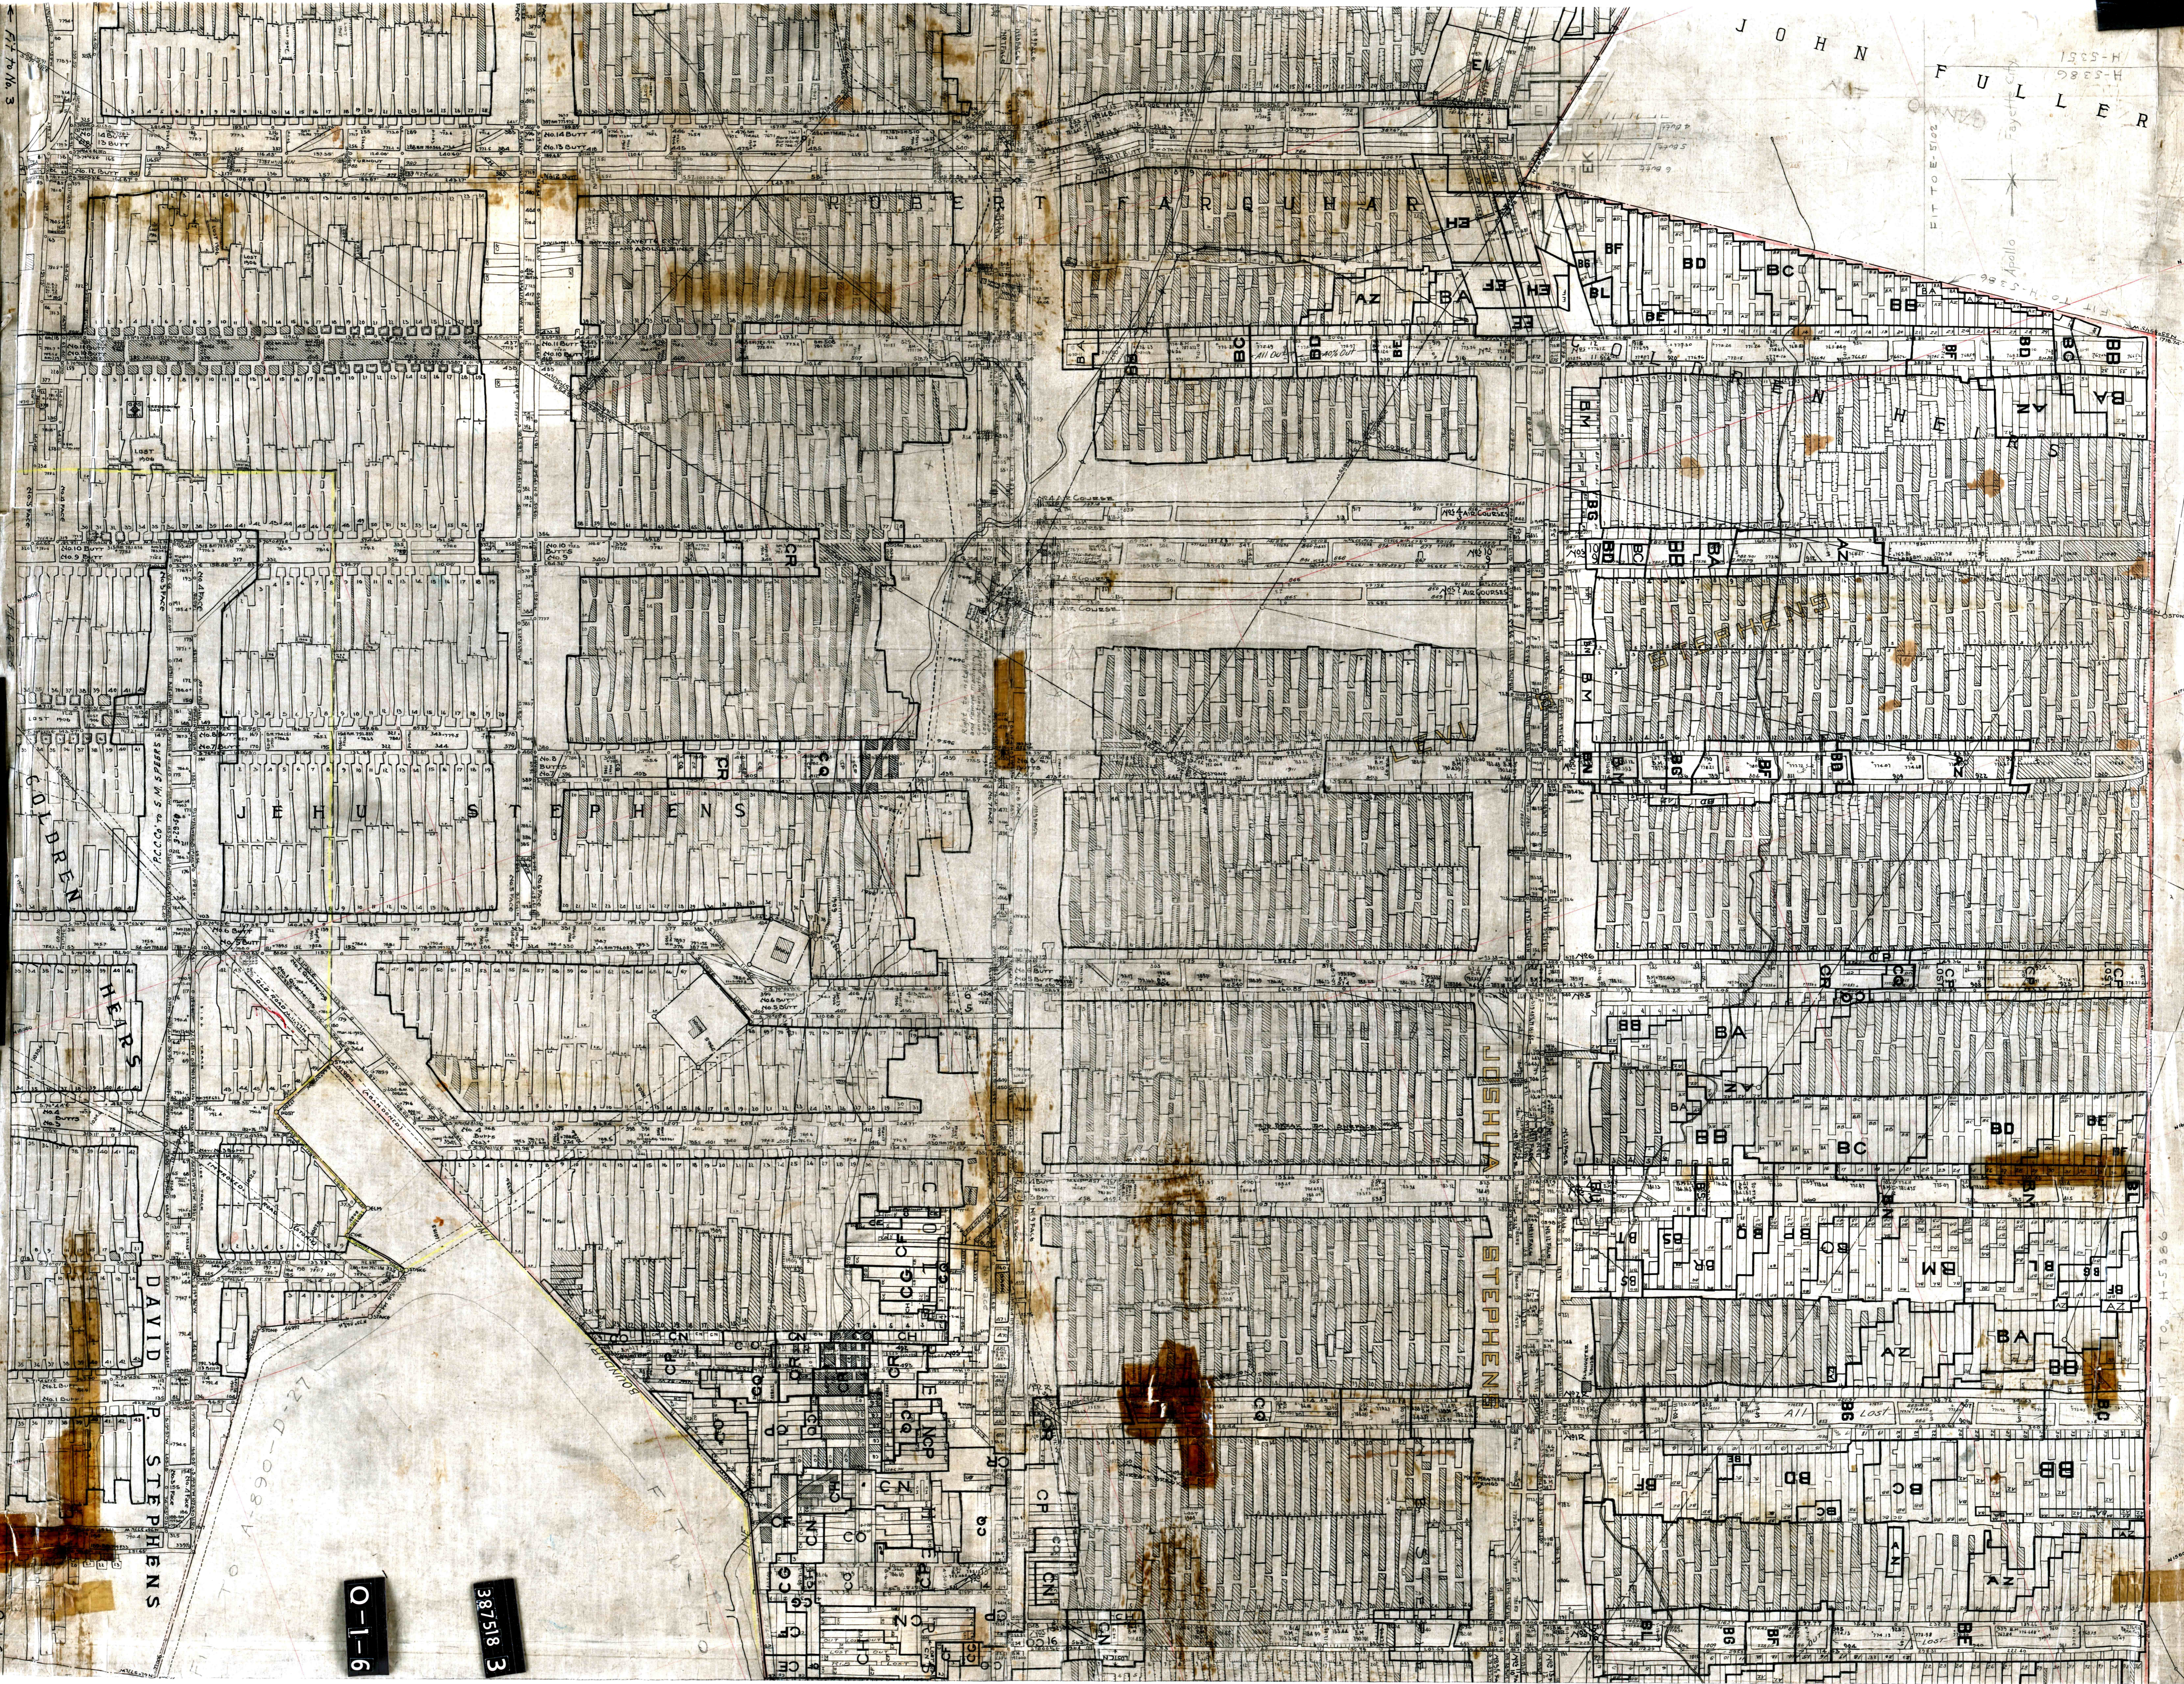

177 No 3

Sheet 12  
G-16

DAVID STEPHENS

O-1-6

387518 3

177 No 1