


387408

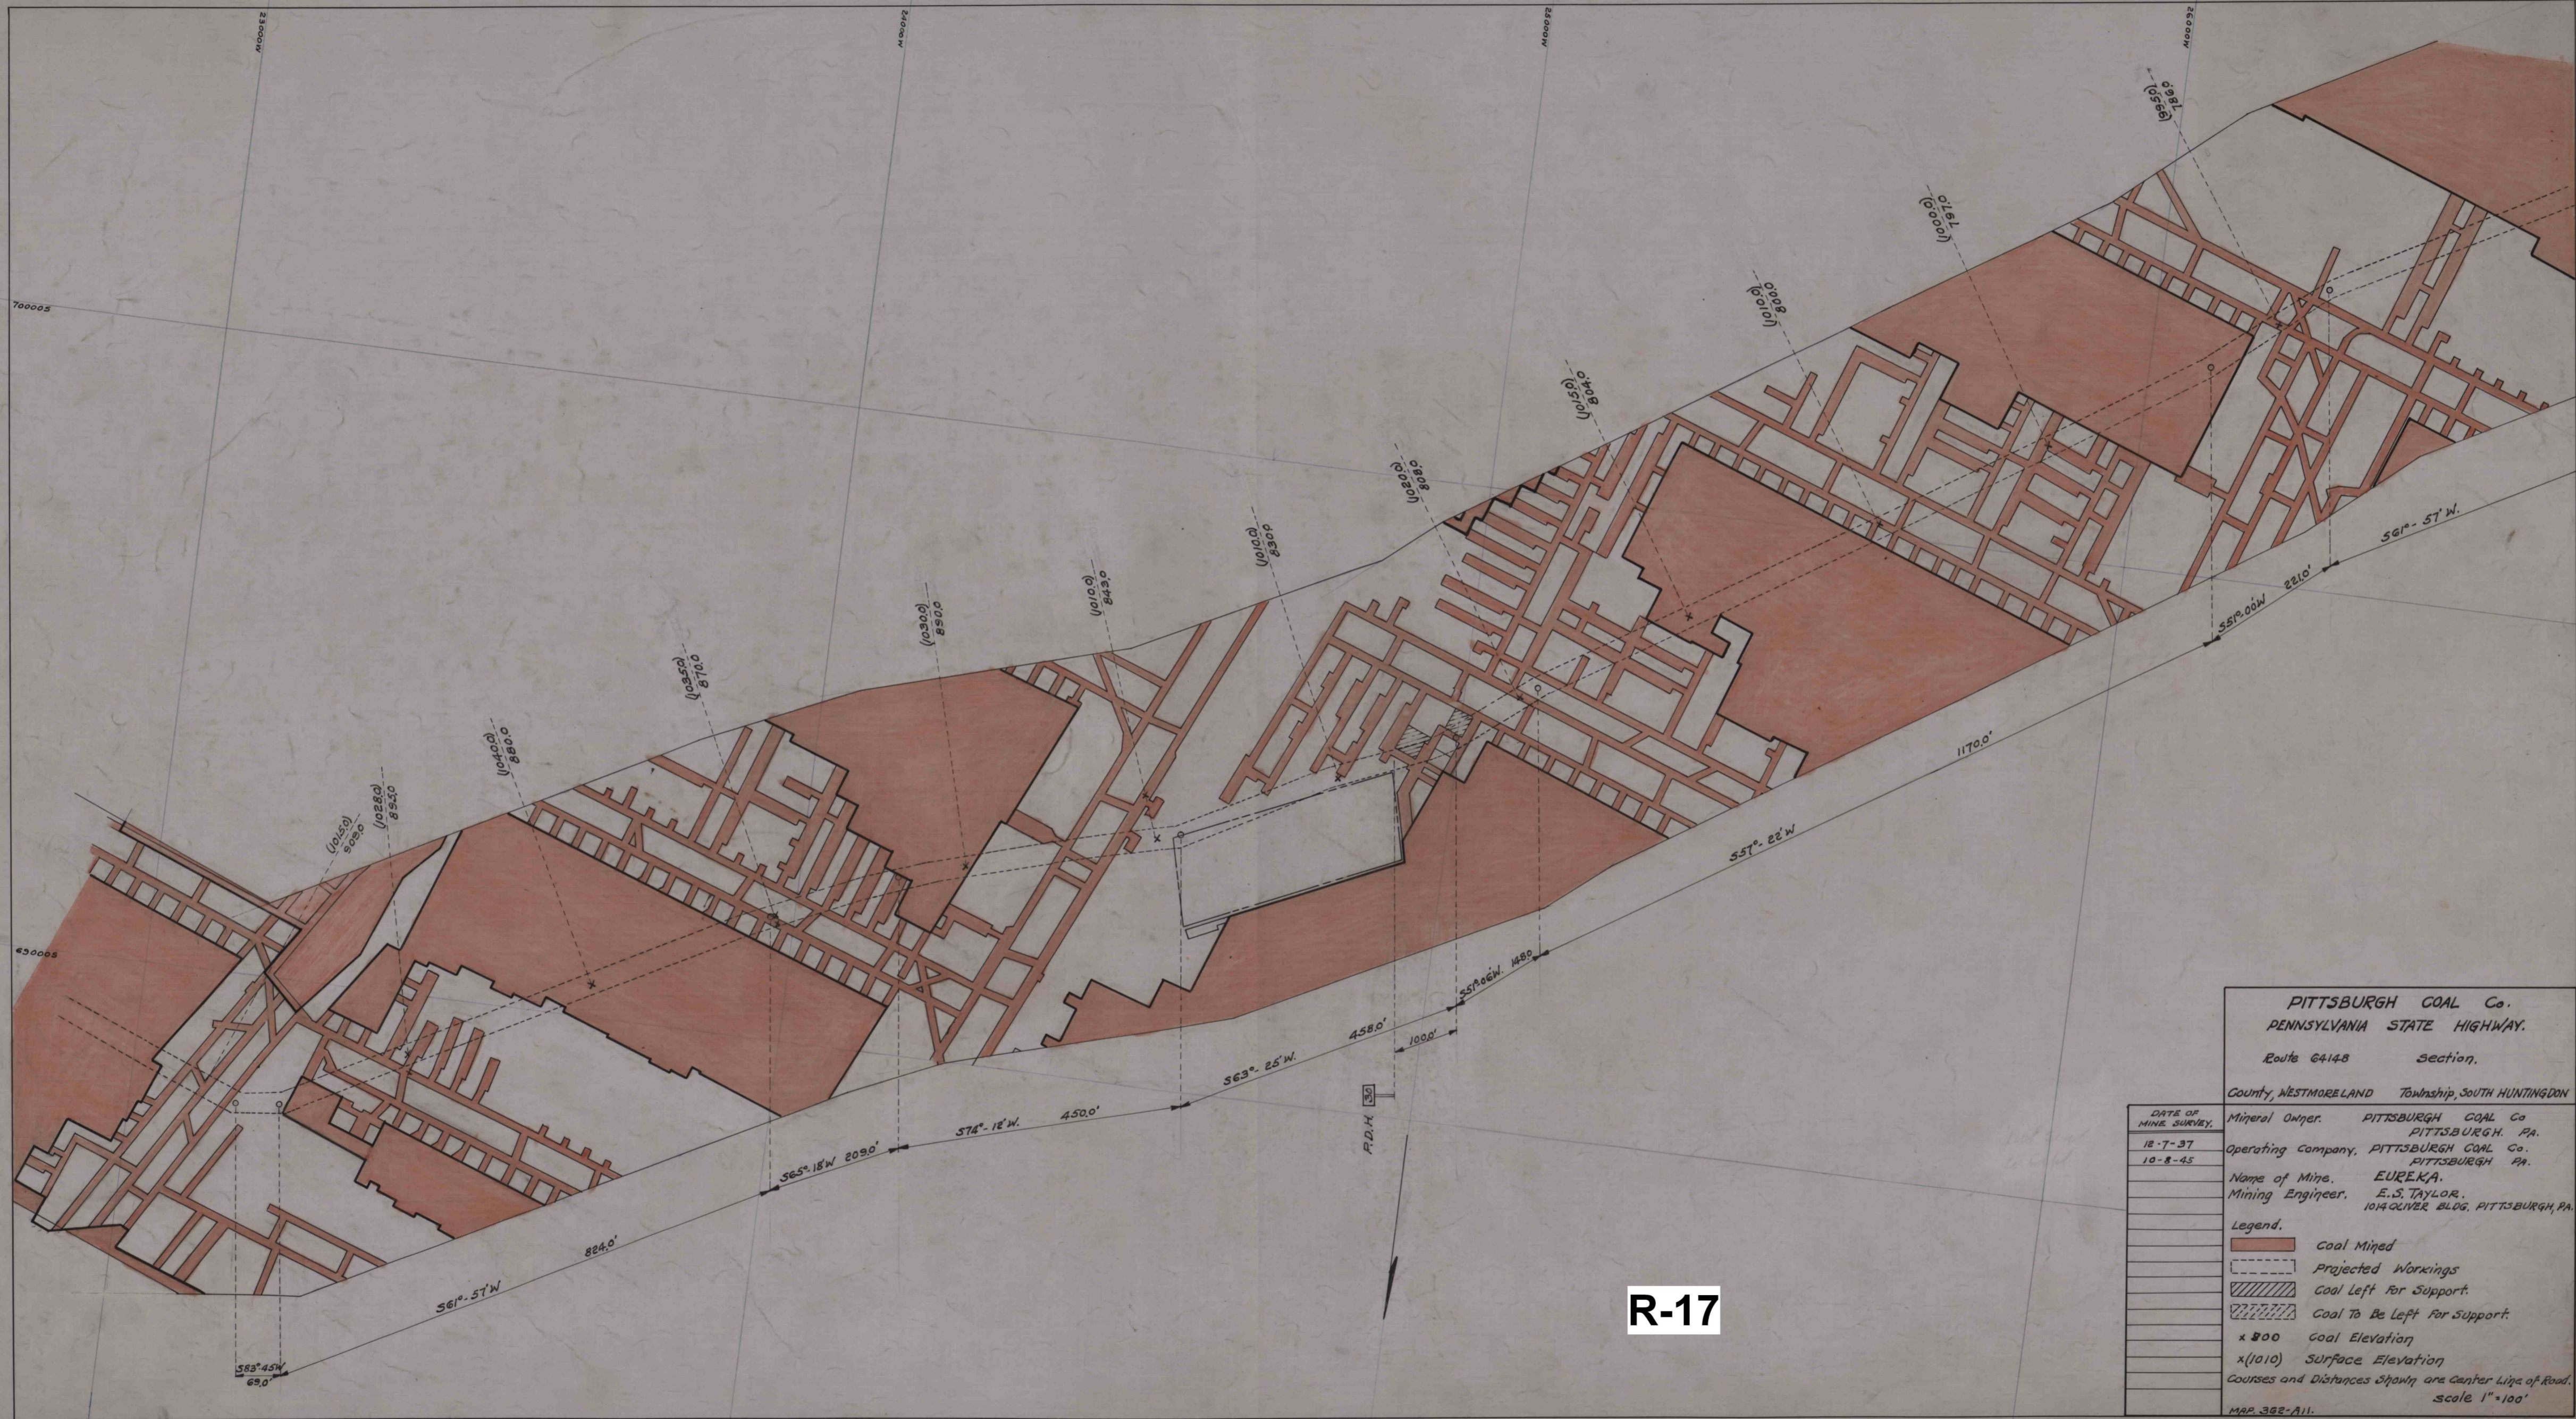

PITTSBURGH COAL Co.
 PENNSYLVANIA STATE HIGHWAY.
 Route 64148 Section.
 County, WESTMORELAND Township, SOUTH HUNTINGDON

DATE OF MINE SURVEY,	Mineral Owner.	PITTSBURGH COAL Co PITTSBURGH, PA.
12-7-37	Operating Company,	PITTSBURGH COAL Co. PITTSBURGH, PA.
10-8-45	Name of Mine,	EUREKA.
	Mining Engineer,	E. S. TAYLOR, 1014 OLIVER BLDG., PITTSBURGH, PA.

- Legend.
- Coal Mined
 - Projected Workings
 - Coal Left for Support.
 - Coal To Be Left for Support.
 - x 800 Coal Elevation
 - x (1010) Surface Elevation
- Courses and Distances shown are Center Line of Road.
 scale 1" = 100'
- MAP 362-A11.

R-17