


Portion of Mine Workings
in the
PITTSBURG SEAM
in relation to
STATE HIGHWAYS
ADAMS MINE
WESTMORELAND COAL CO.
situate in

North Huntingdon Township Westmoreland County, Pa.
Engineering Department Westmoreland Coal Co. Irwin, Pa.
 November 24, 1943 Scale 1" = 100'
Geo. T. Lewis Chief Engineer

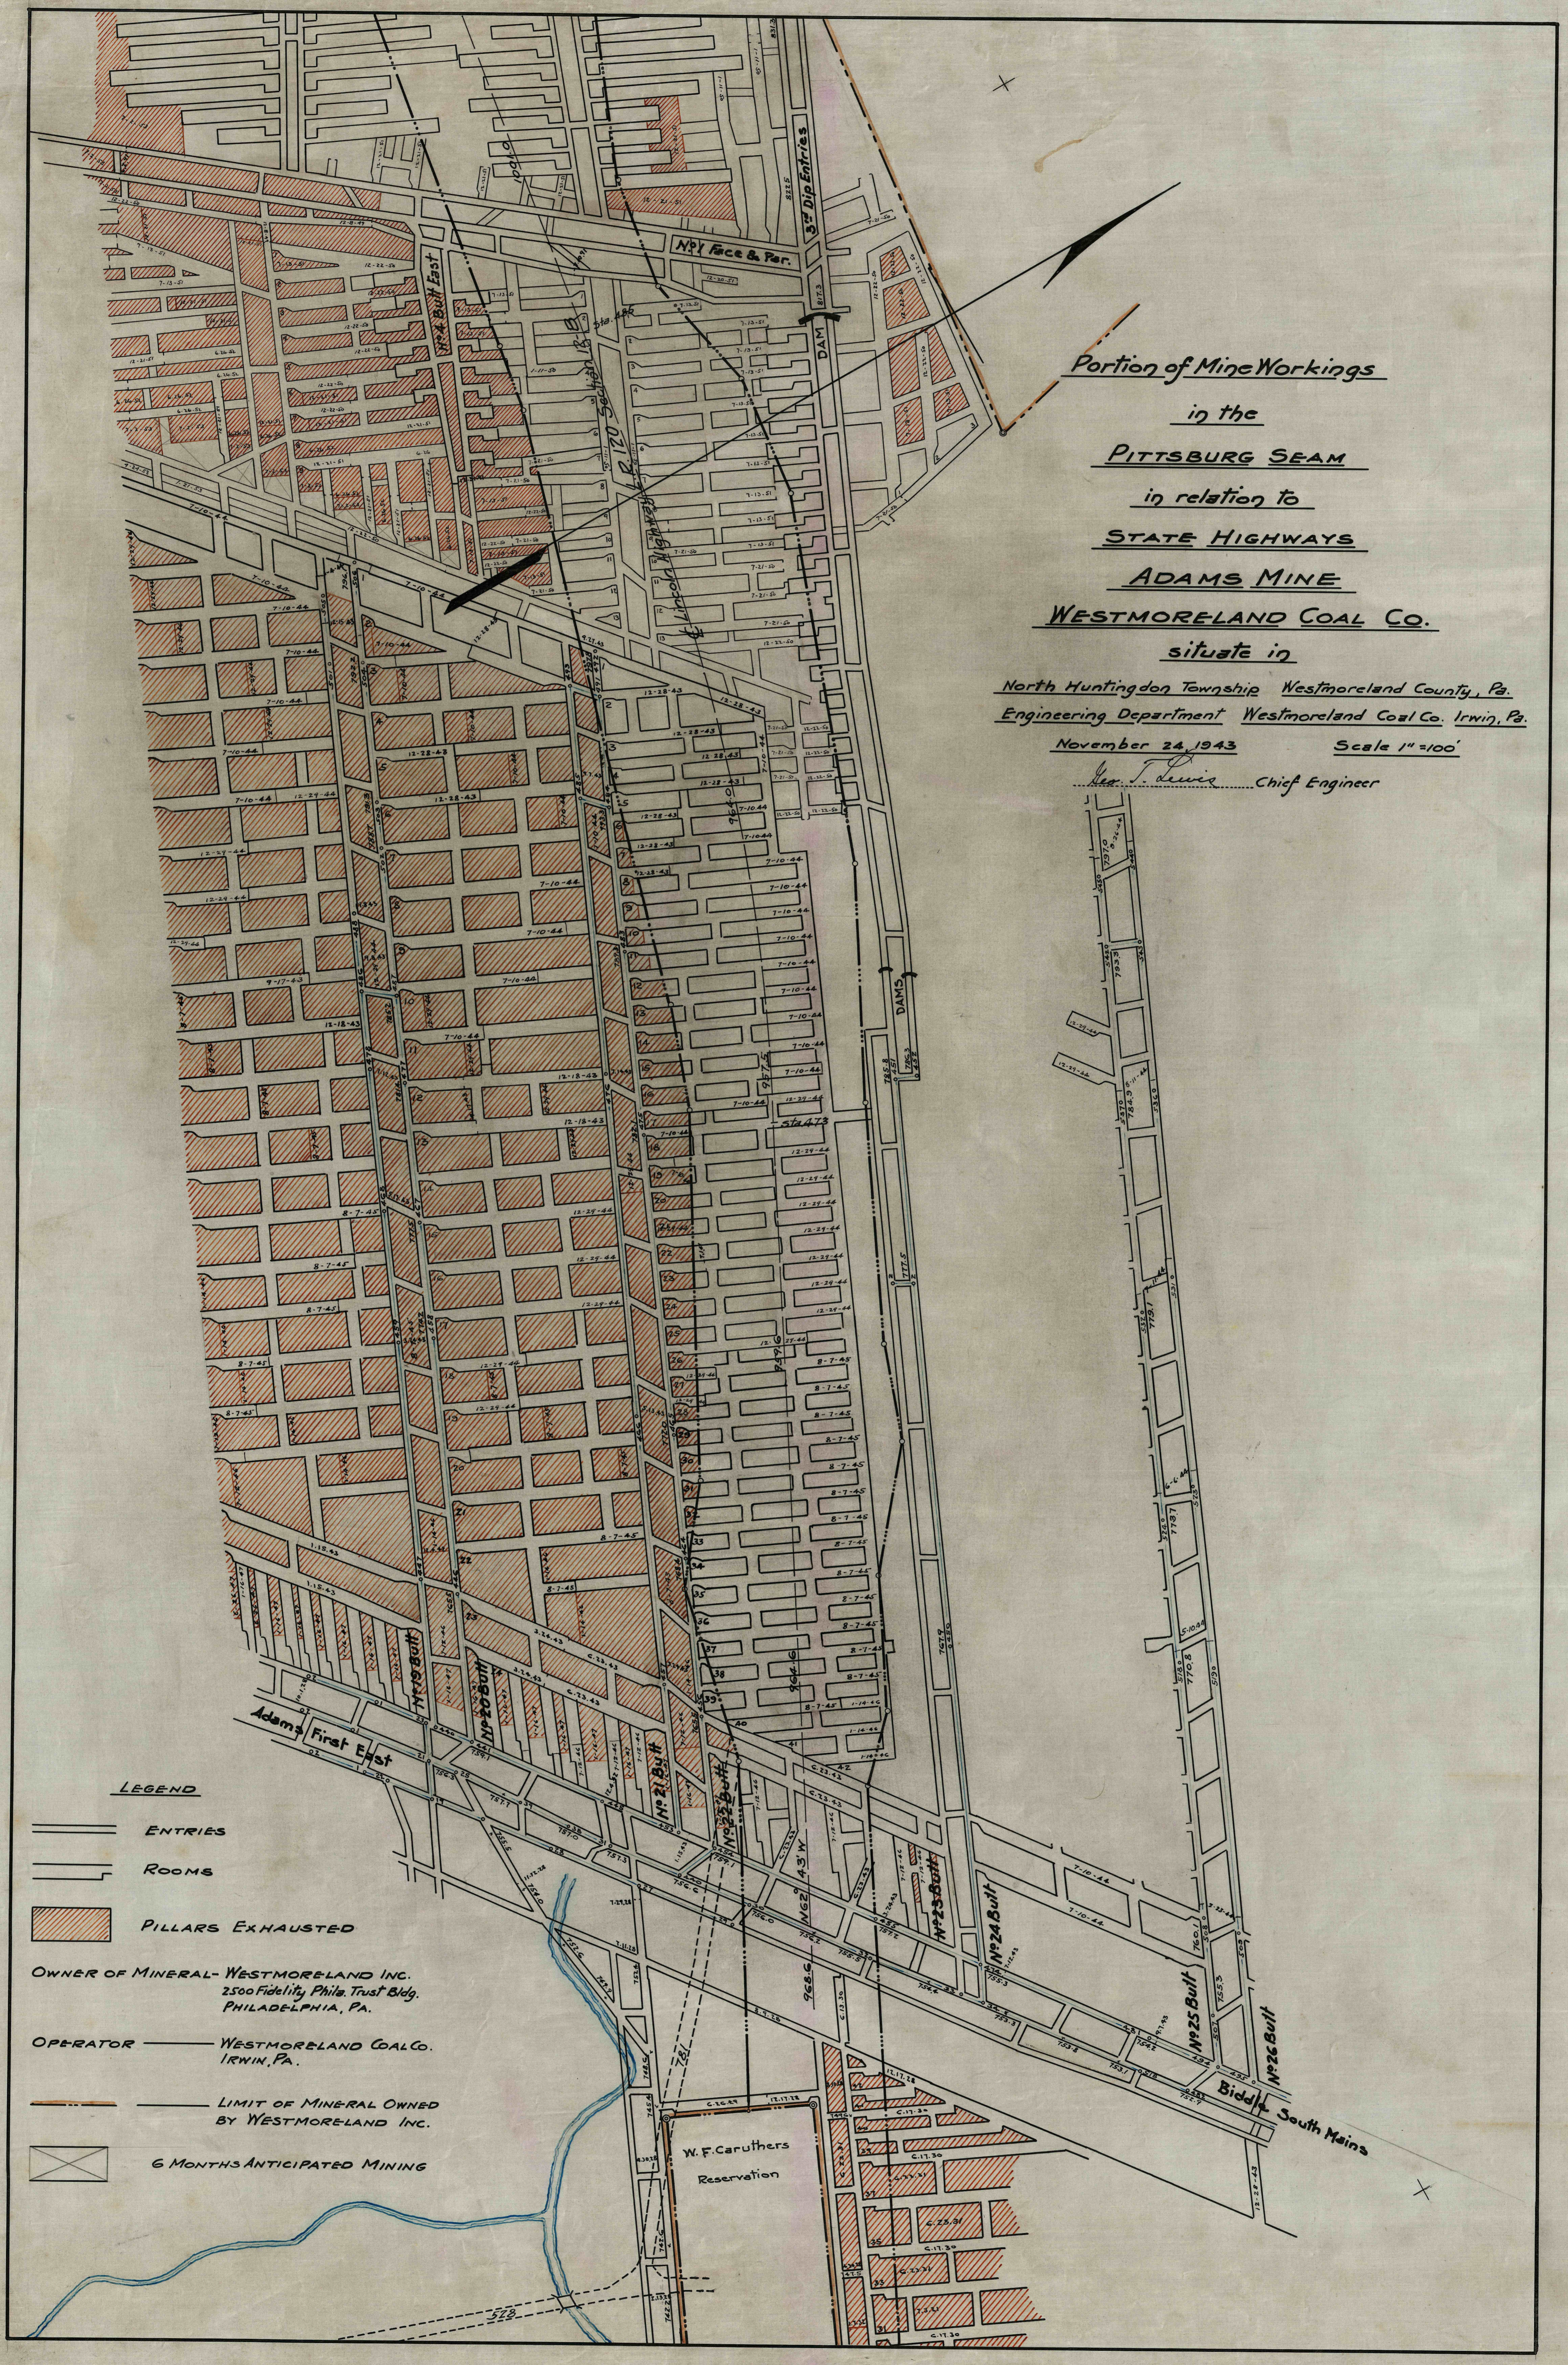

LEGEND

- ENTRIES
- ROOMS
- PILLARS EXHAUSTED
- OWNER OF MINERAL** - WESTMORELAND INC.
2500 Fidelity Phila. Trust Bldg.
PHILADELPHIA, PA.
- OPERATOR** - WESTMORELAND COAL CO.
IRWIN, PA.
- LIMIT OF MINERAL OWNED
BY WESTMORELAND INC.
- 6 MONTHS ANTICIPATED MINING