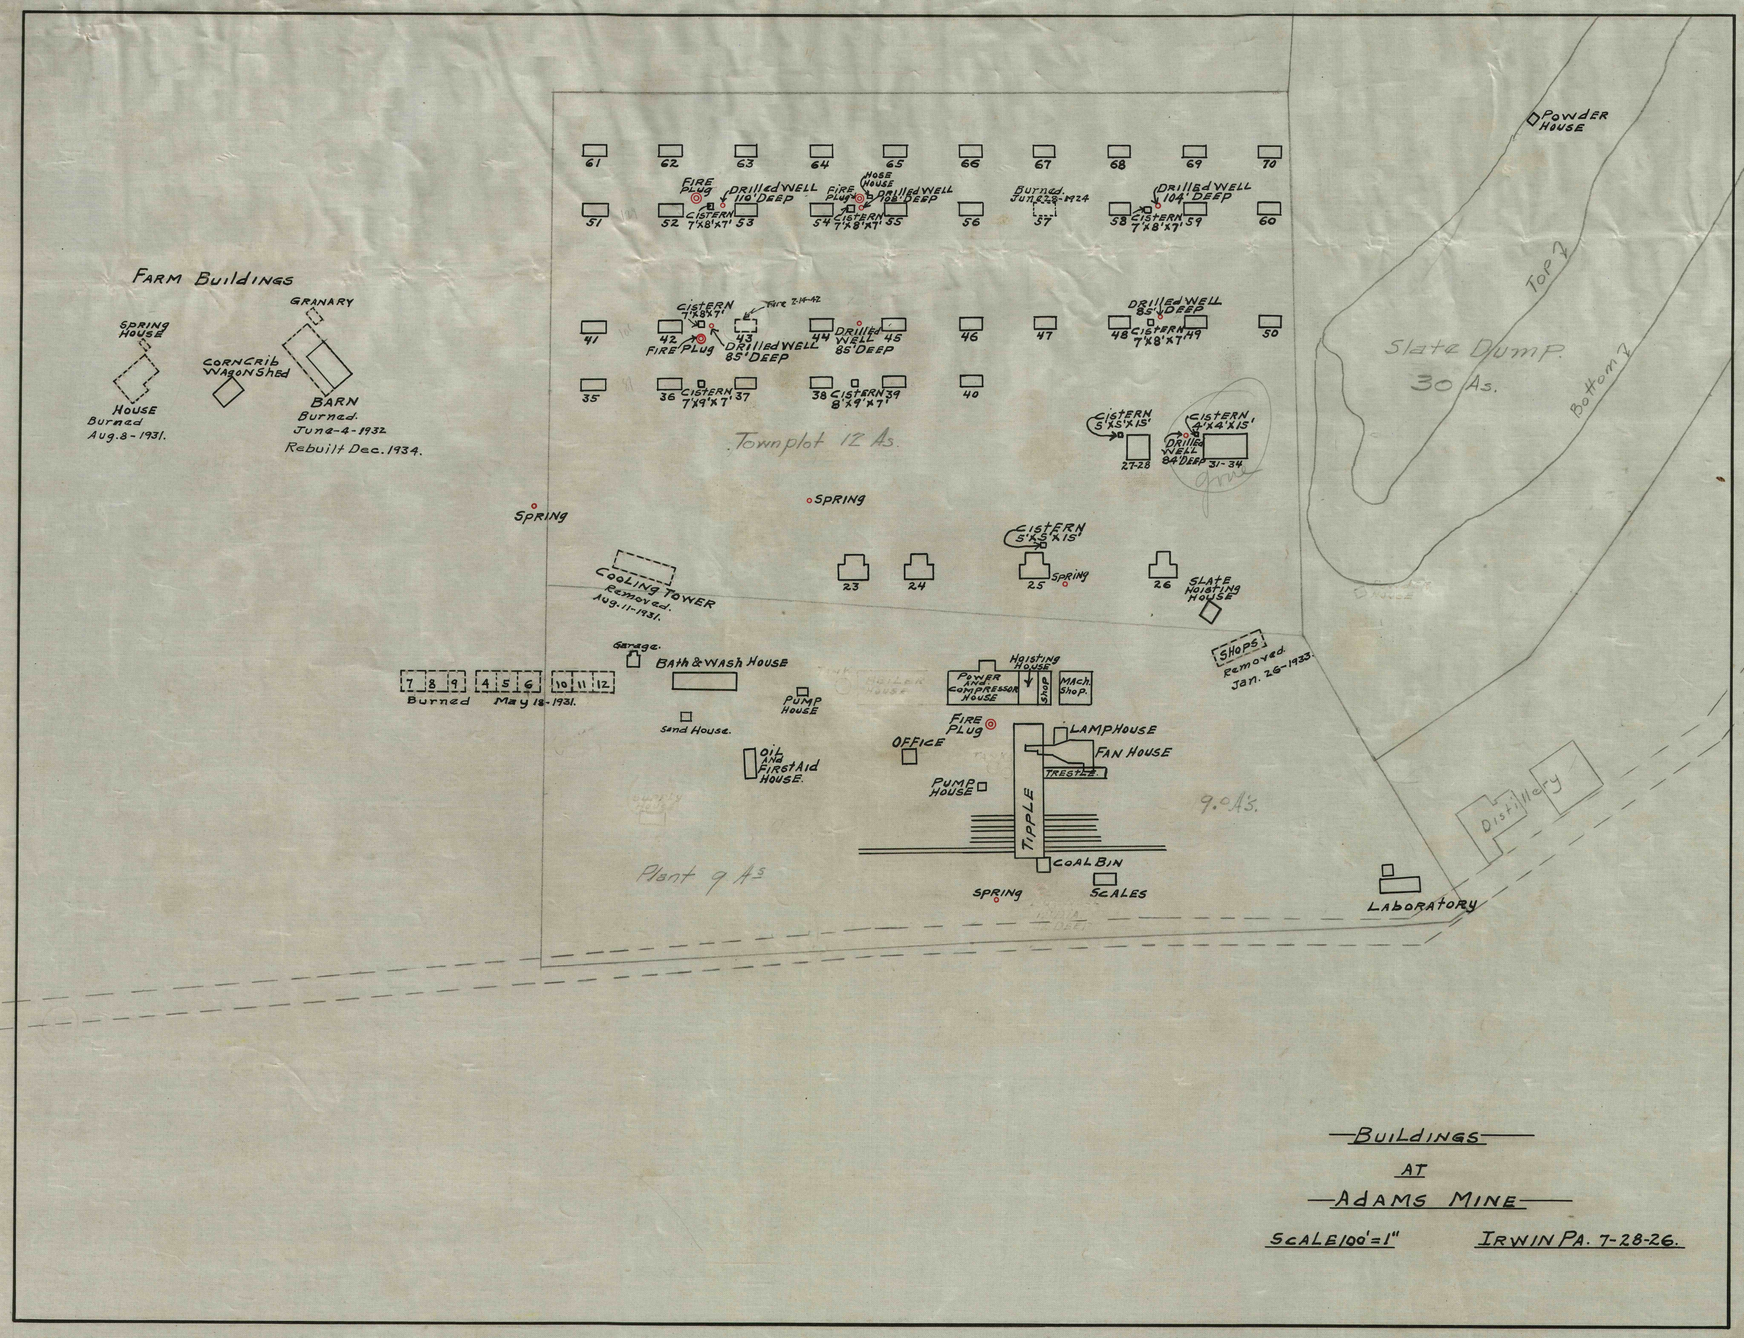

BUILDINGS
AT
ADAMS MINE
SCALE 100'=1" IRWIN PA. 7-28-26.