


Anderson, Eclipse and Germania  
Profile  
C  
E-1

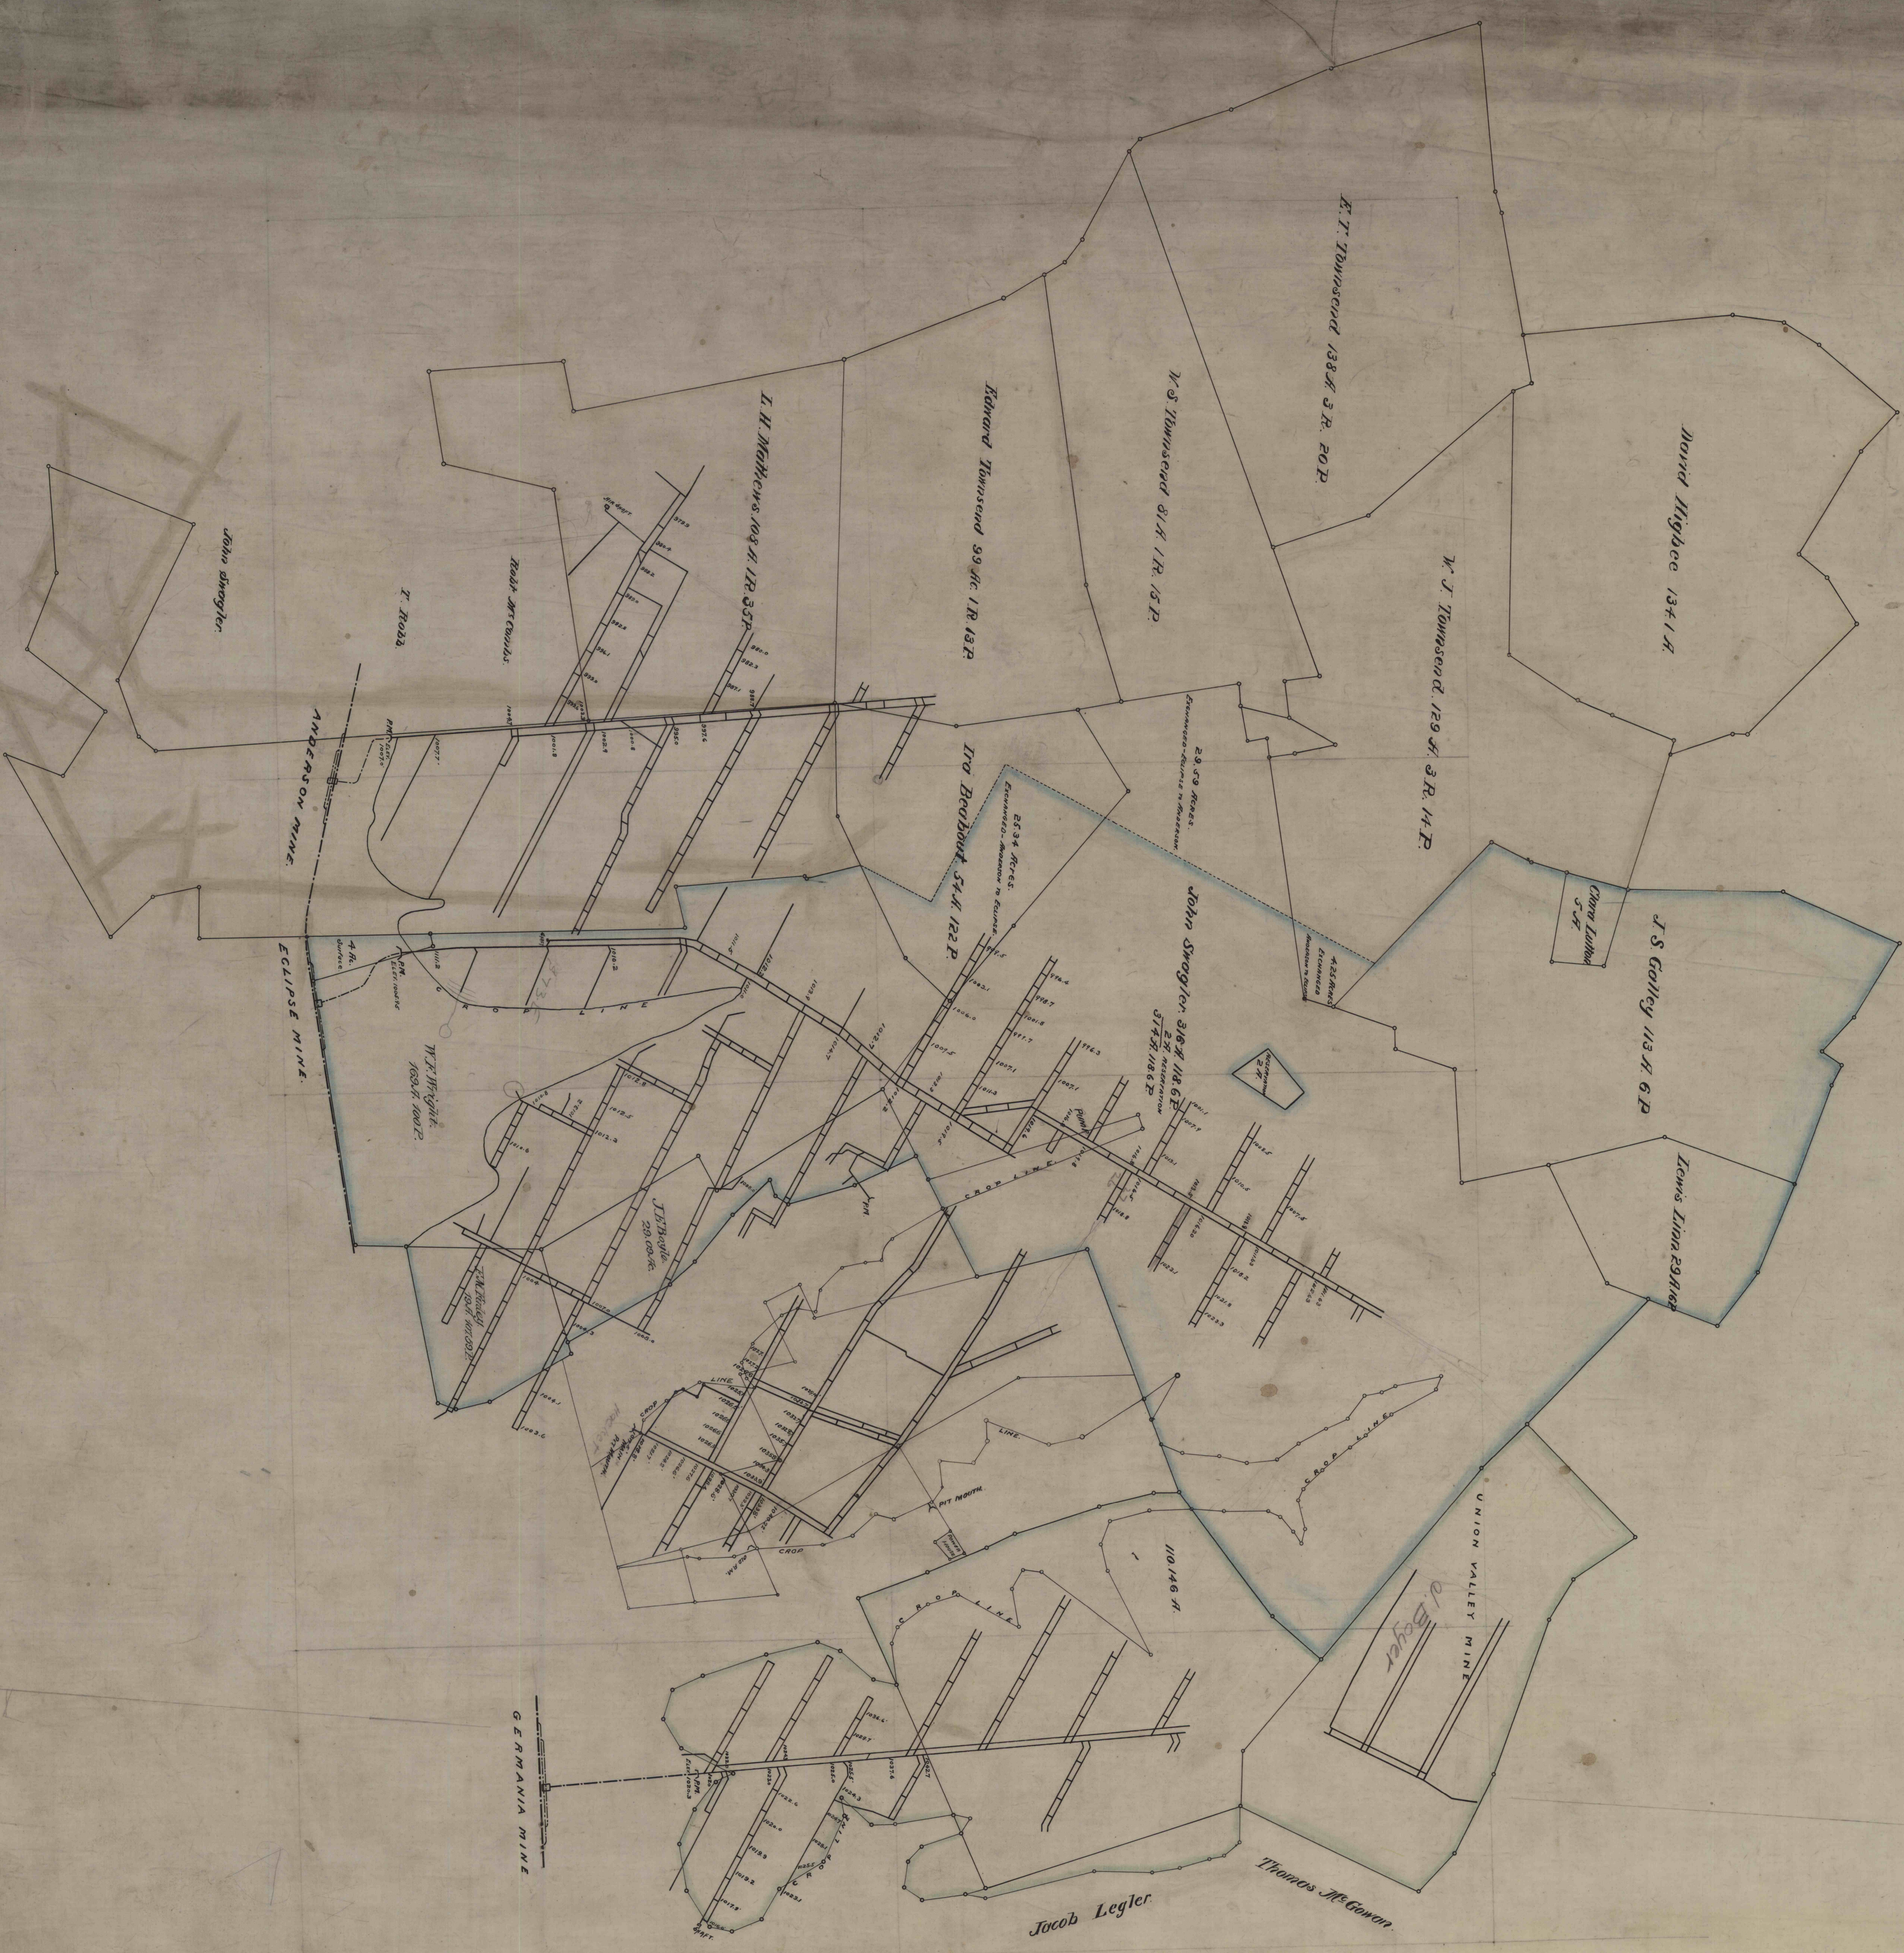

CONNECTED PLAN  
OF THE  
ANDERSON, ECLIPSE & GERMANIA  
MINES  
SCALE 500 FT. = 1 IN.  
JAN. 30 - 1900.