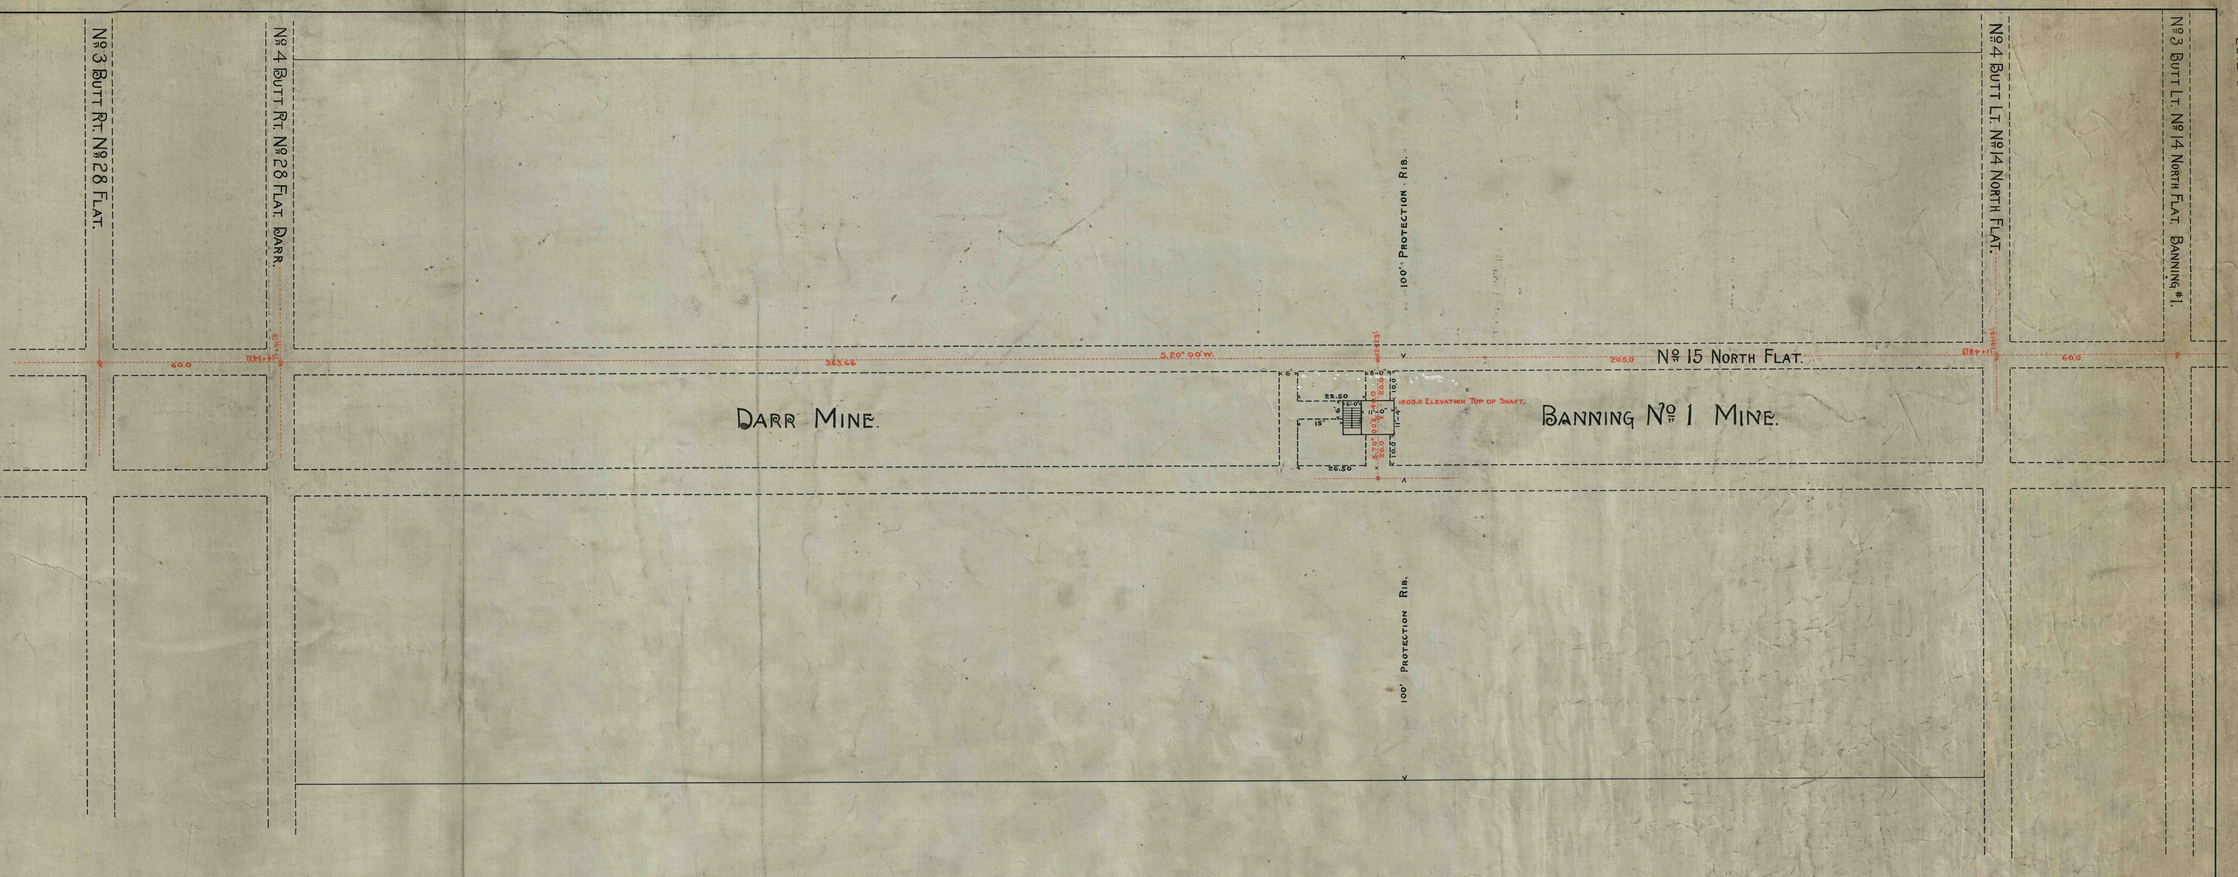

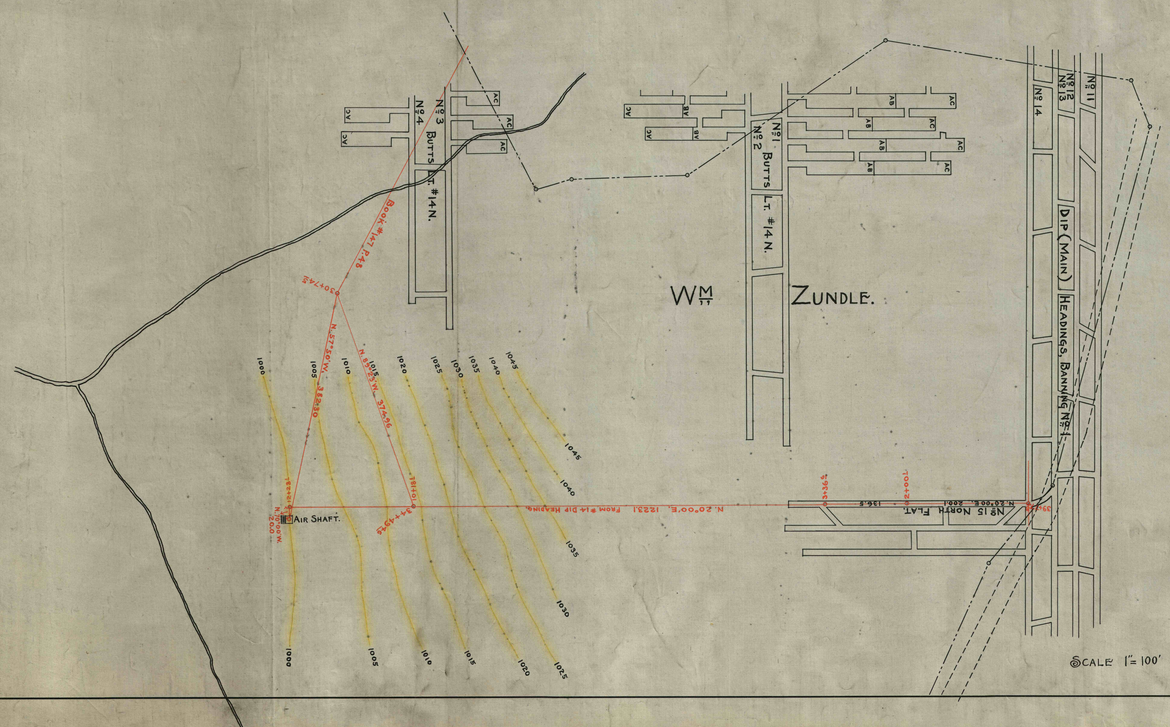

Plan Showing
Banning No 1 and Darr Shaft Location on Wm Zundle Farm.

Situated in Rostraver Township, Westmoreland Co, Pa.

Scale 1"=20' May 9, 1907.

Eng. Dept. P.C.Co.
W.L.E.

G-5023

G-5023