

EARL R. FONNER
49-22-4

DEEMS CRUMRINE
49-22-3

~~J. V. THOMPSON~~
BETH. EXG. 28

J. BUCHINGHAM
49-22-2

JOHN DIVILBLISS
49-22-22

GEORGE HOFFMAN
49-22-1

~~J. M. MILLER NO. 3~~
P. B. 1-49

WILLIAM URSIC
49-25-5



~~MARGARET ANN NICHOLS HEIRS~~
P. B. 1-6

R. DRANZO
49-25-5.01

G. TOKAR
49-25-5.03

J. BROWN
49-25-5.04

R. GOLICK

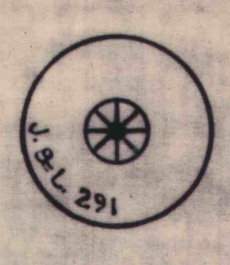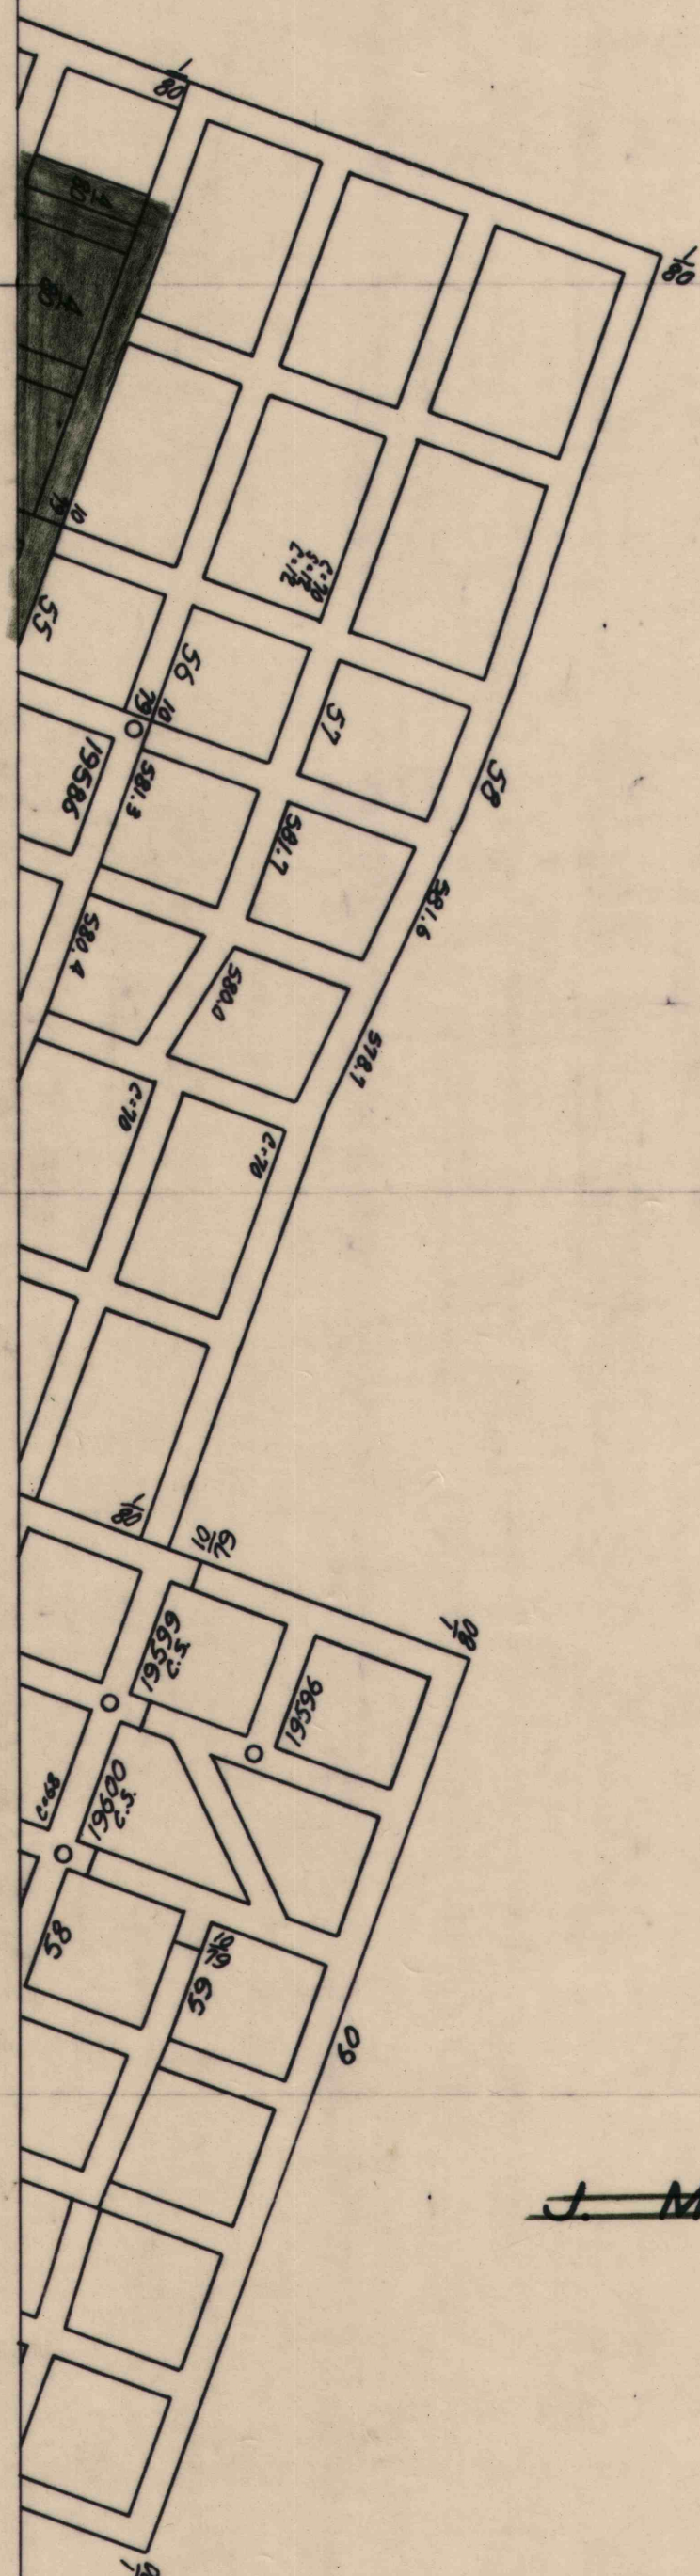

T-383

PLUGGED
202

62079