

W. 47500 W. 46500 W. 45500 W. 44500

7 BEALLS. III

FRANK SCHULZ  
49-21-6

~~CHAS. & ELLA BIGLER~~



~~AMOS HEIRS~~

JAMES HOMME  
49-21-7

~~EVA~~  
E. FONNER  
49-22-4

~~J. T.~~  
D. CRUMLINE  
49-22-3

G. HOFFMAN  
49-22-1

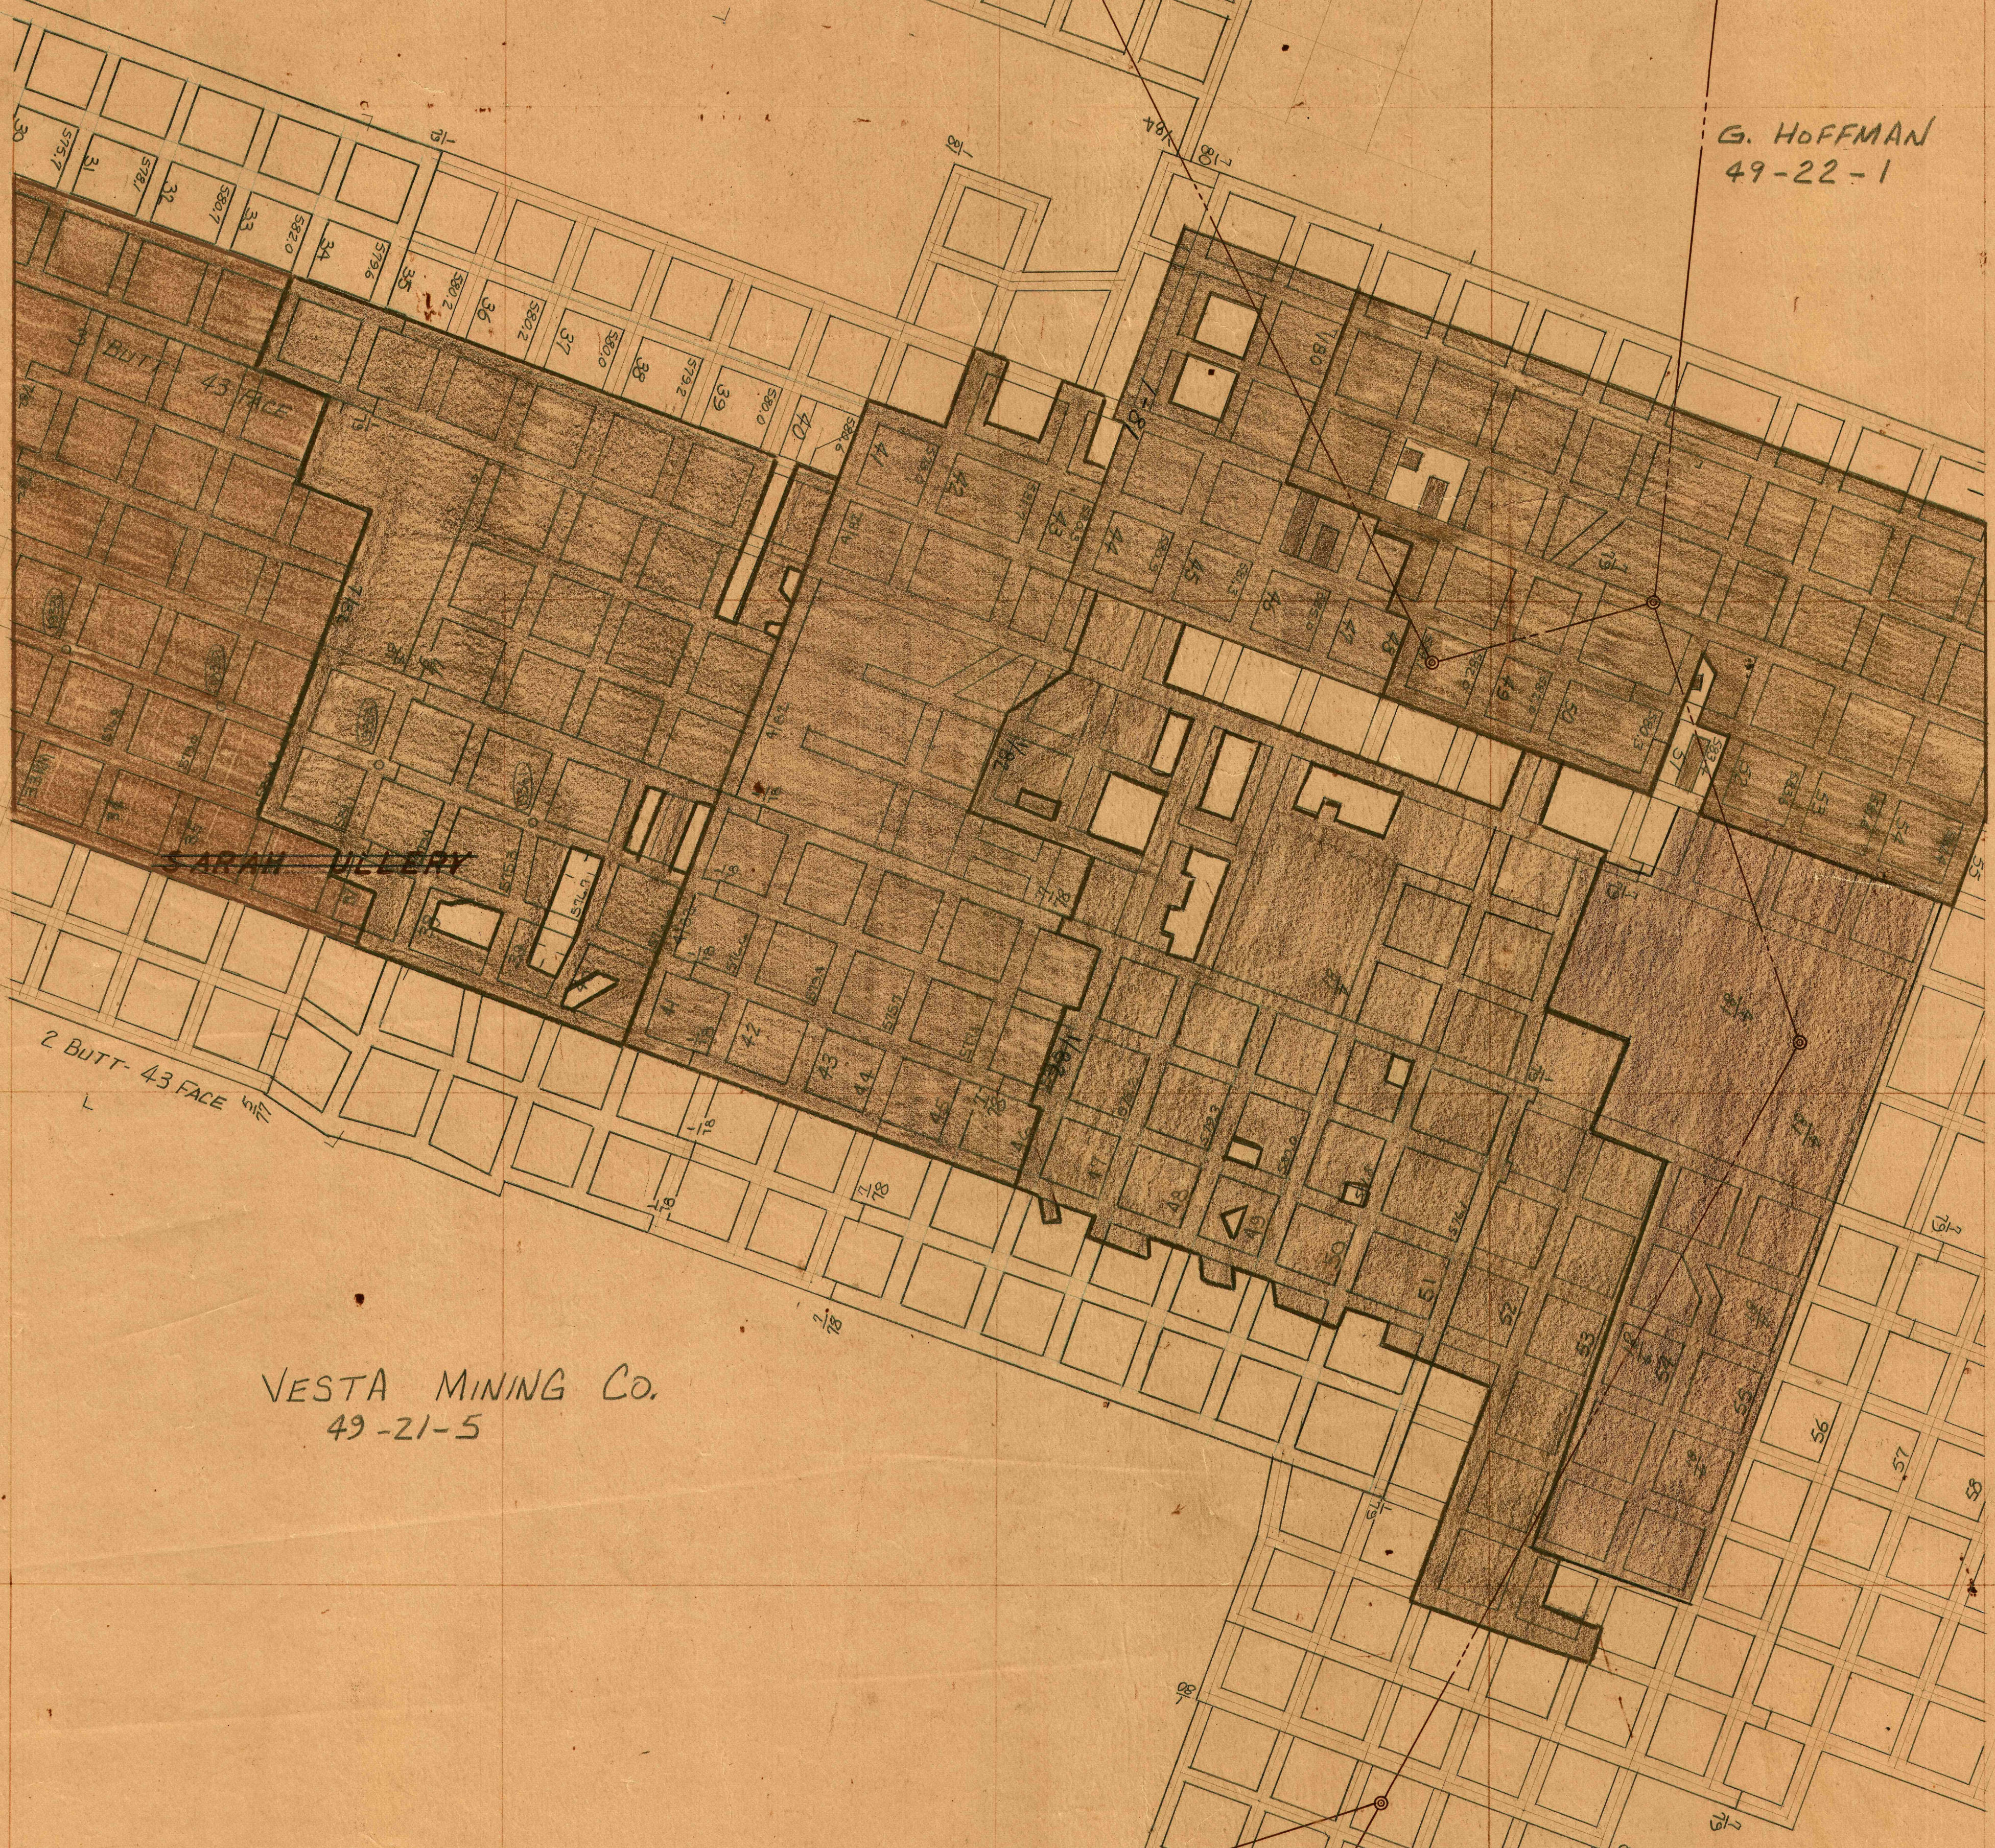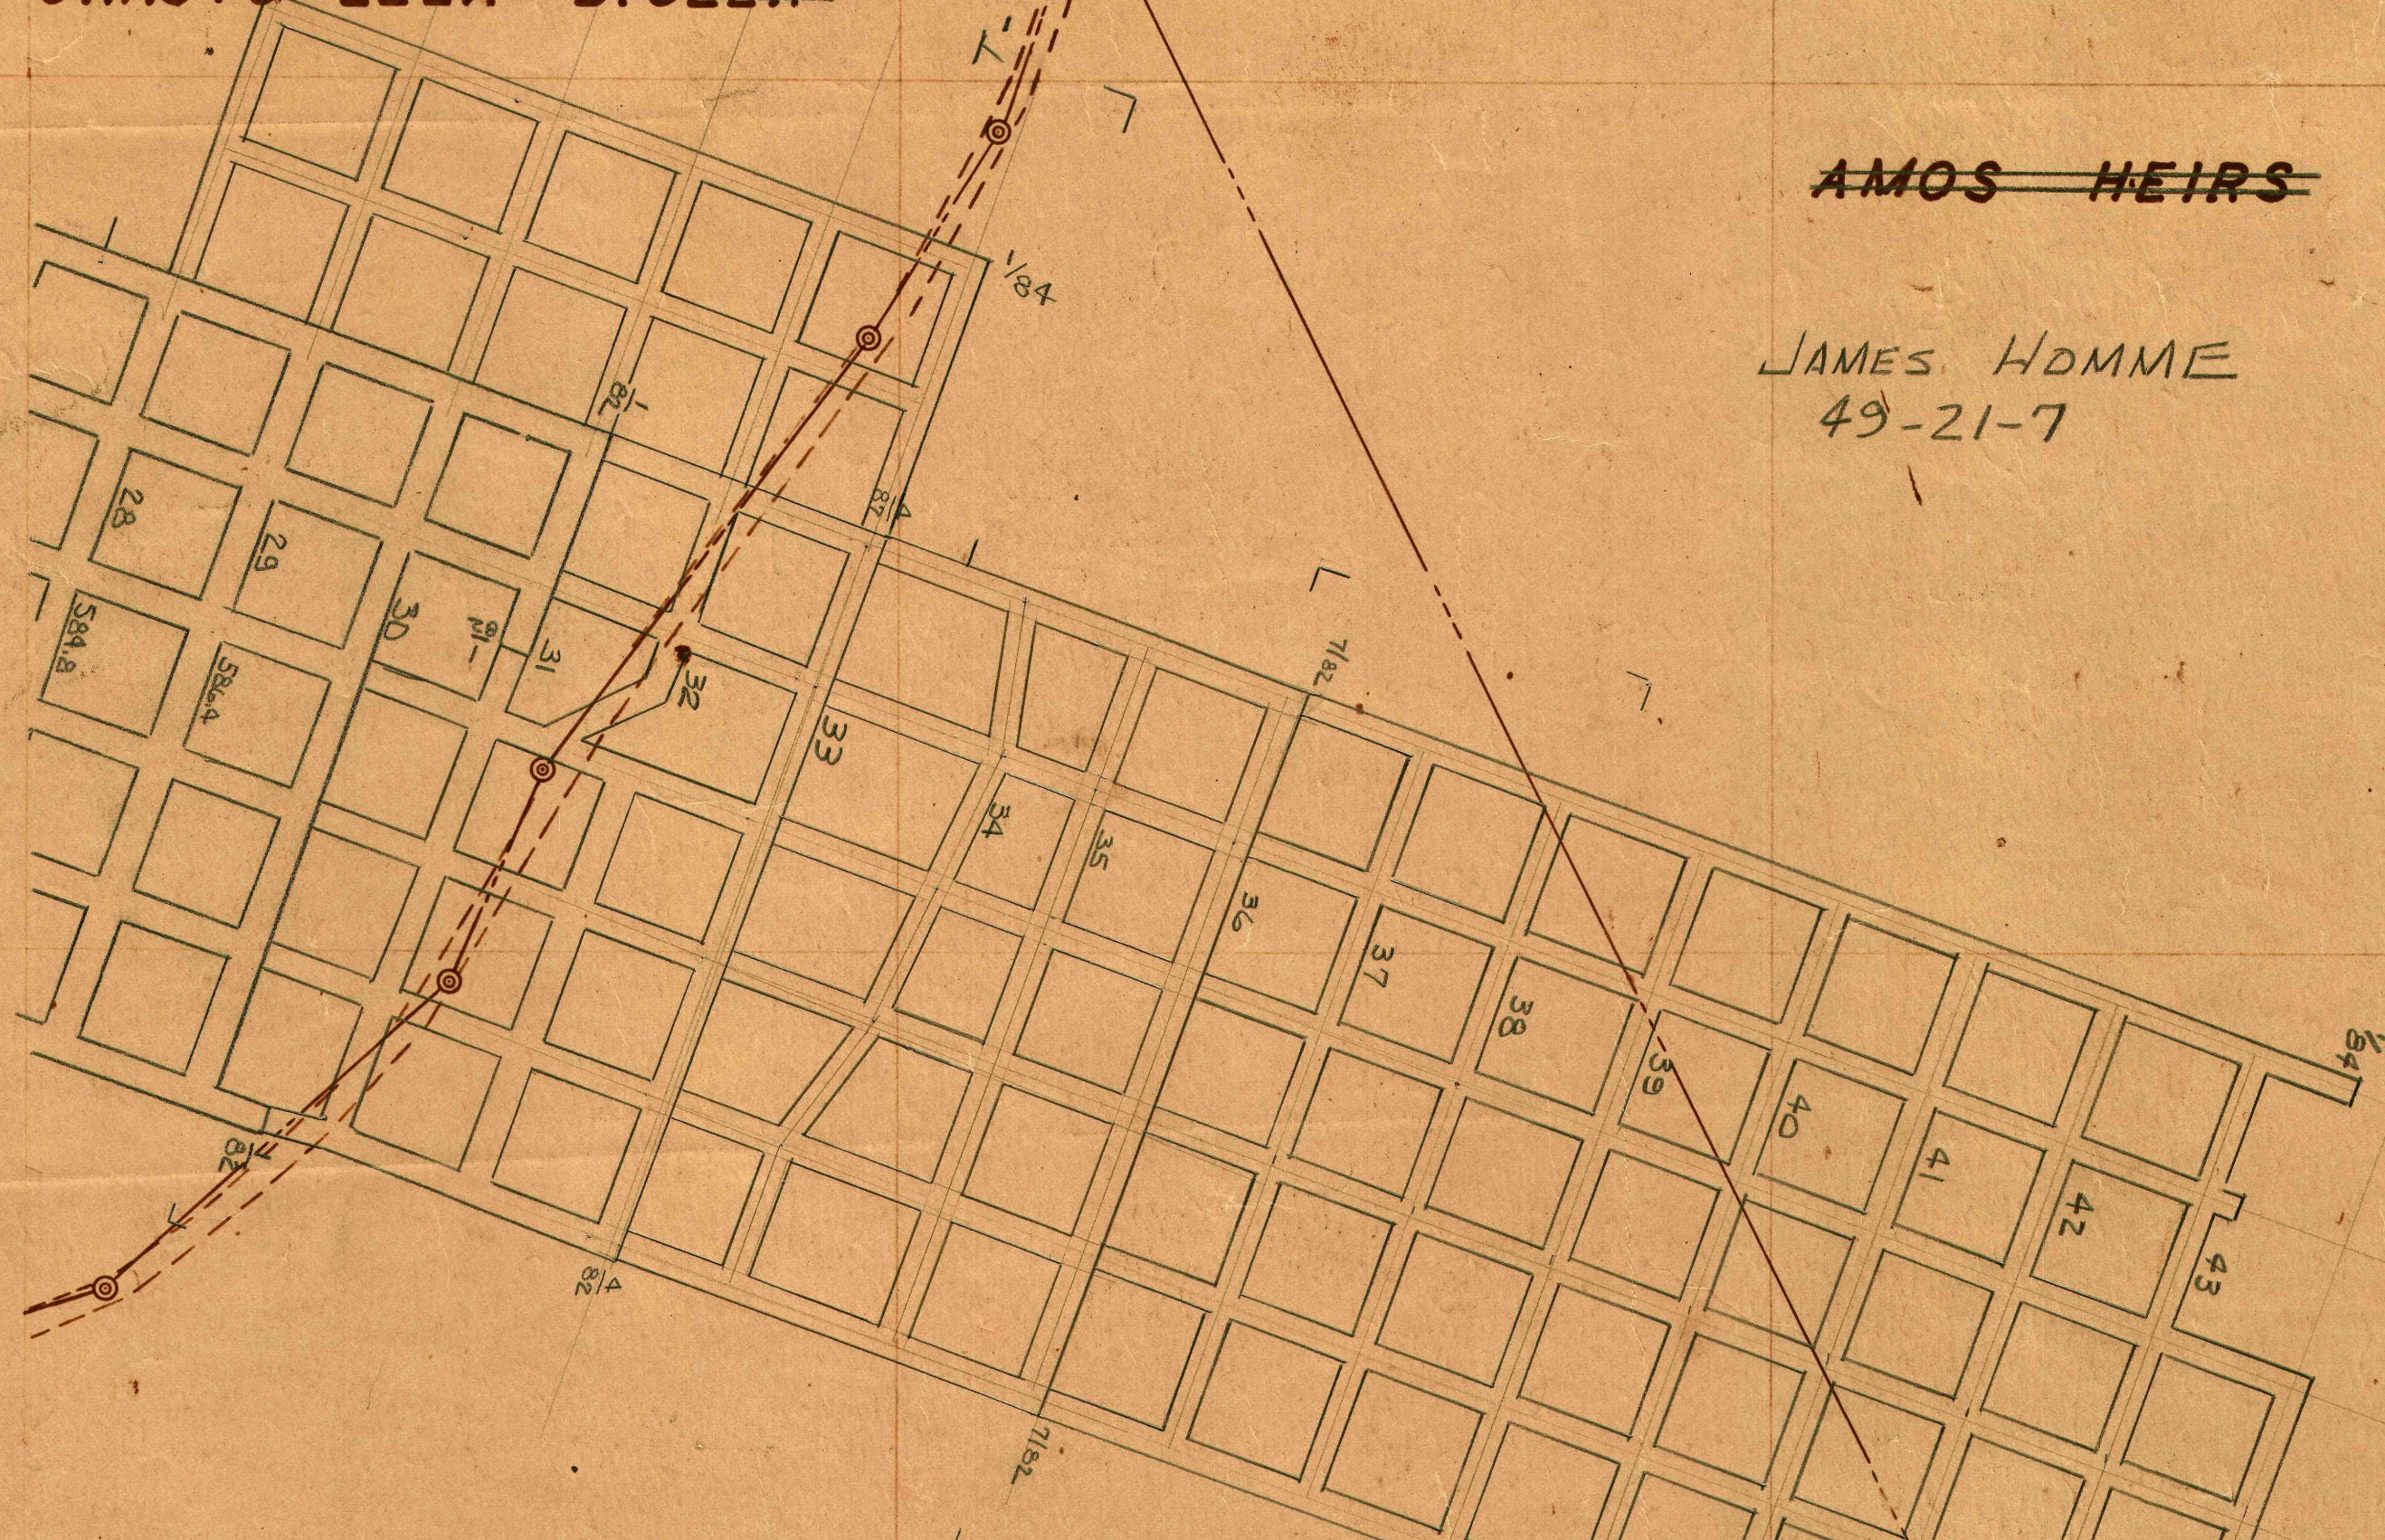

VESTA MINING Co.  
49-21-5

2 BUTT-43 FACE

GEORGE HOFFMAN  
49-26-4


MARY J. MYERS

RONALD BECK  
49-26-5

H. BECK  
49-26-5/01

FRANK & MARY GUZA  
49-25-5

R. DRANZO  
49-25-5.01

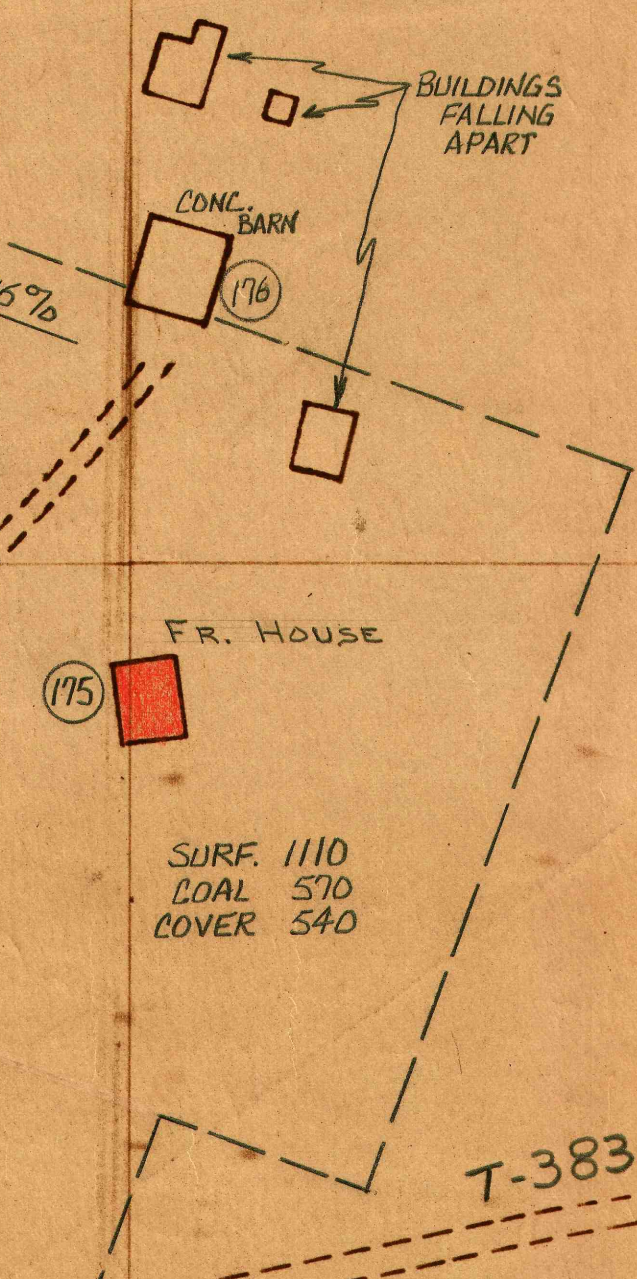

7 BEALLS. III