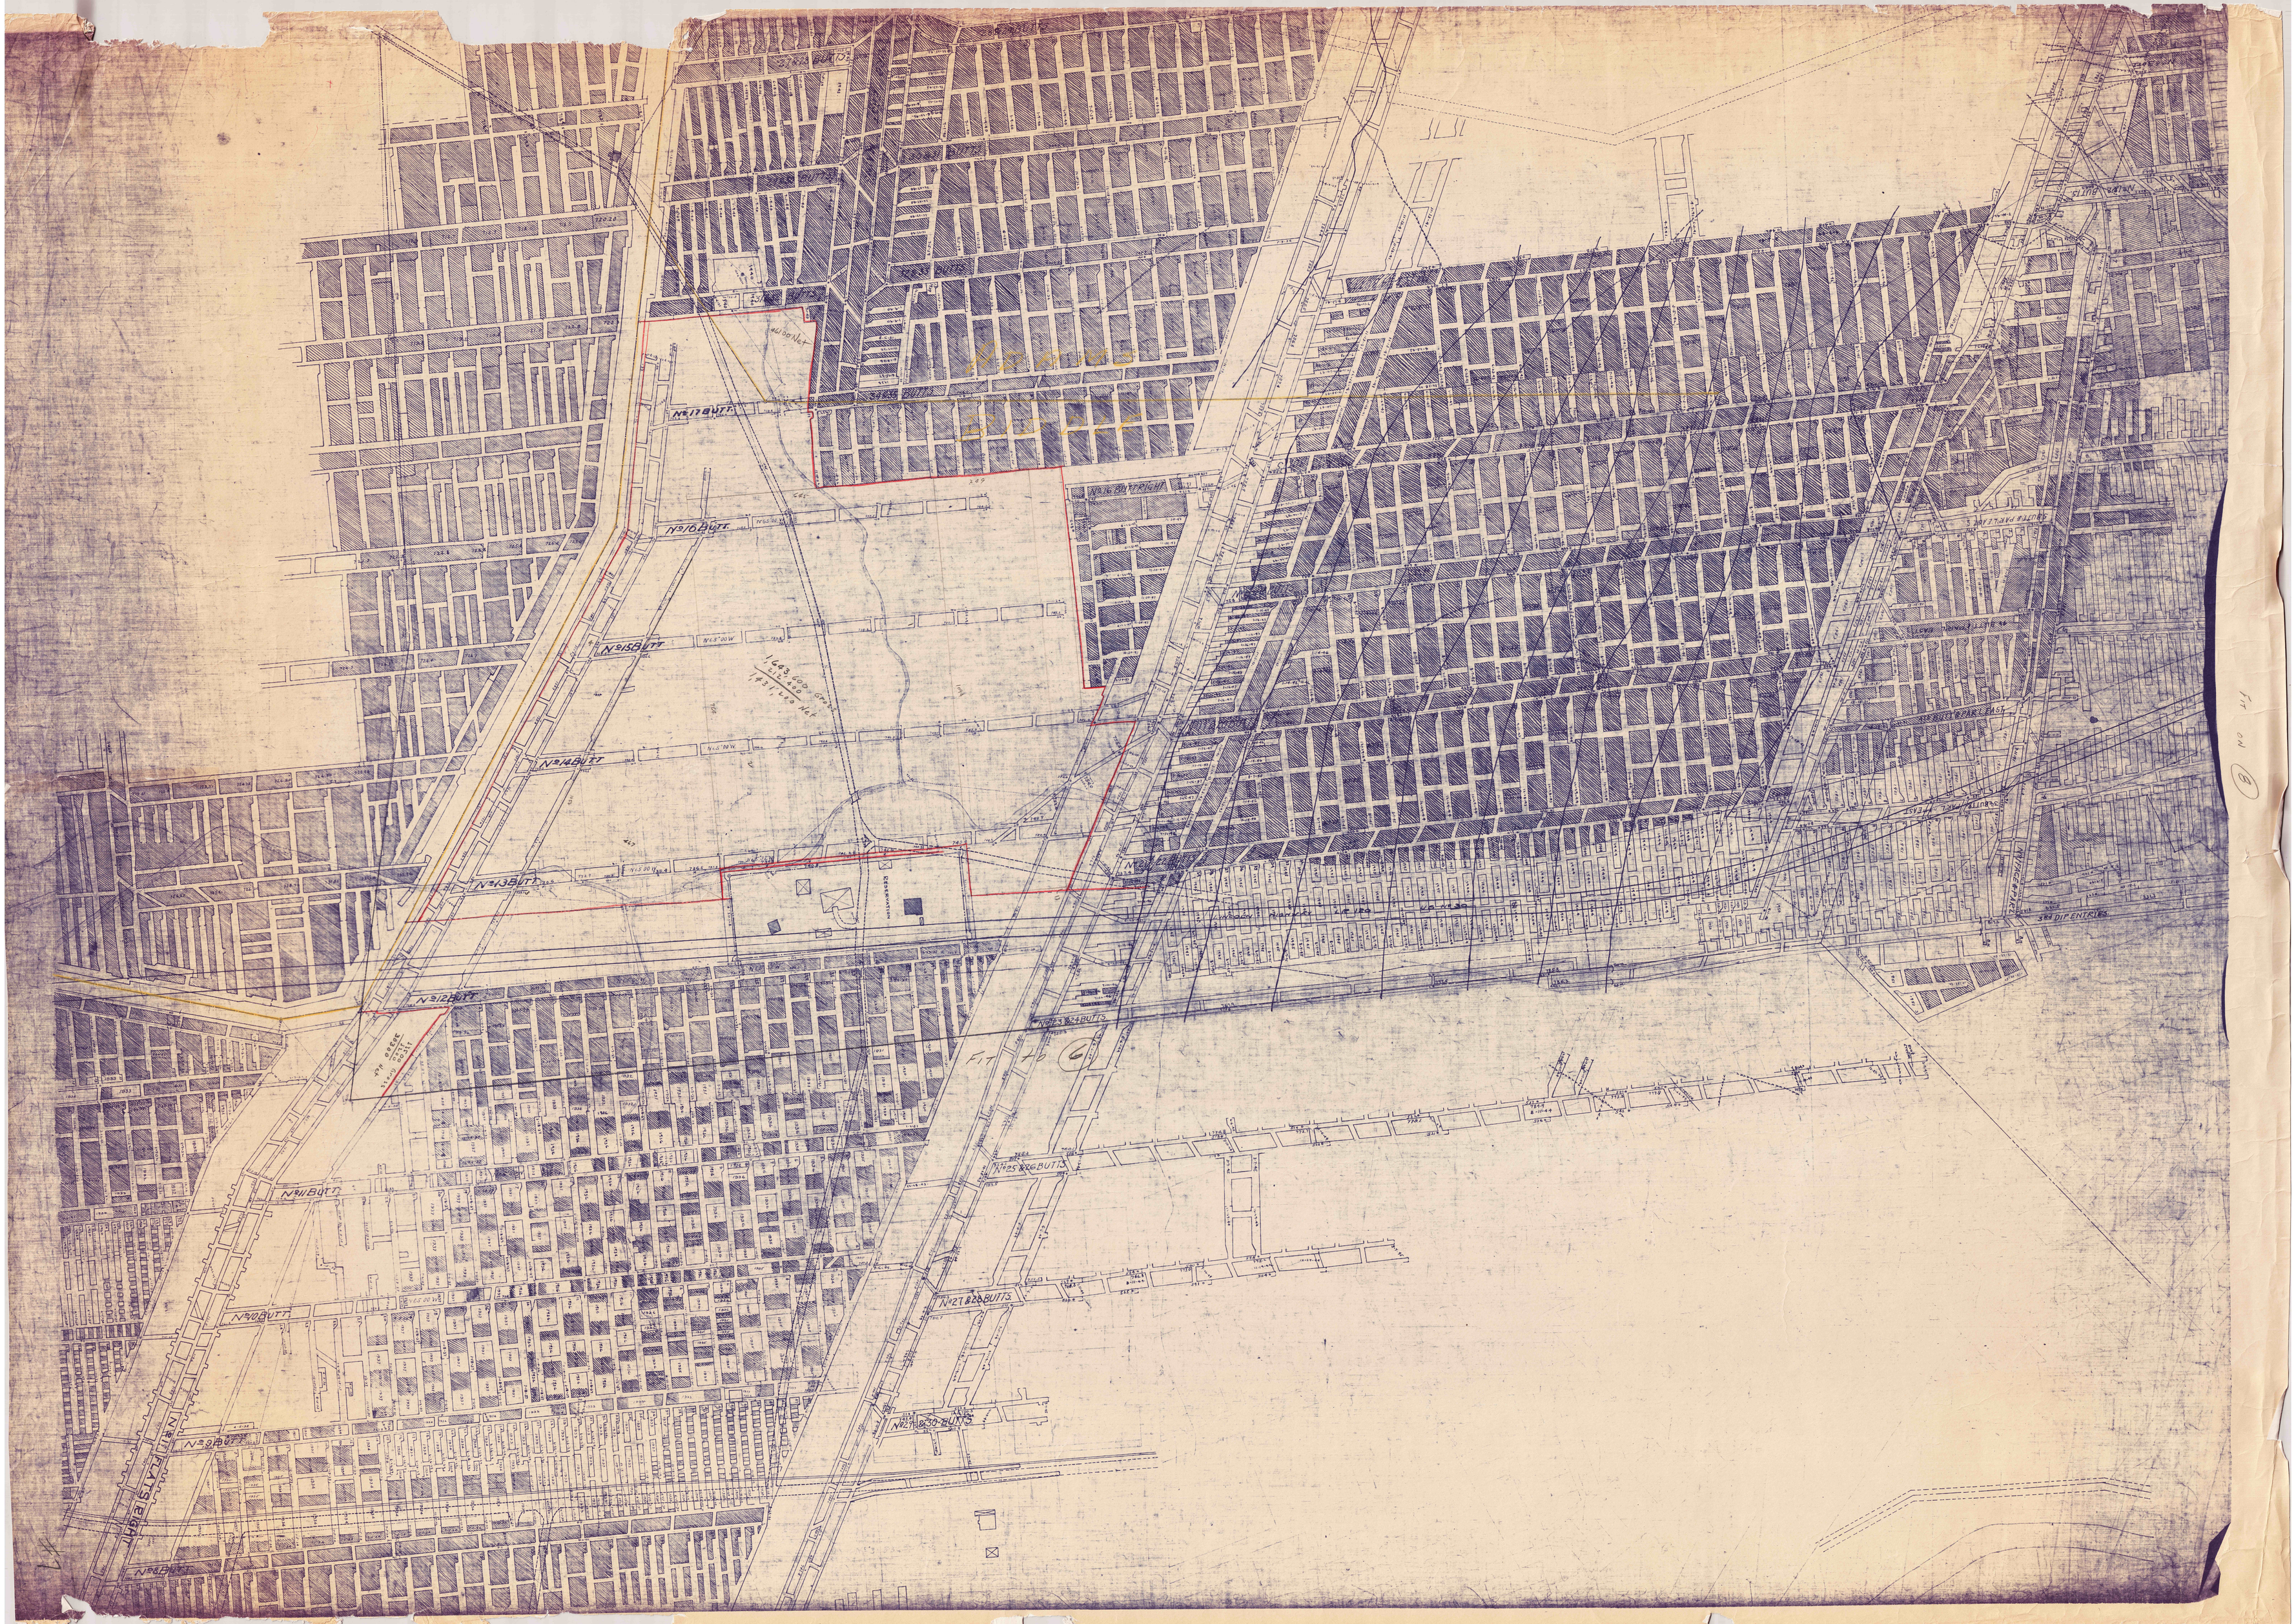
N°13 BUTT.
N°12 BUTT.
N°11 BUTT.
N°10 BUTT.
N°9 BUTT.
N°8 BUTT.
N°25 BUTTS
N°27 BUTTS
N°27 BUTTS
N°13 BUTTS
1693.000 Gross
1831.270 Nat
Fit to 6
Fit to 8
Fit to 9
Fit to 11
Fit to 12
Fit to 14
Fit to 15
Fit to