


COAL

Co.

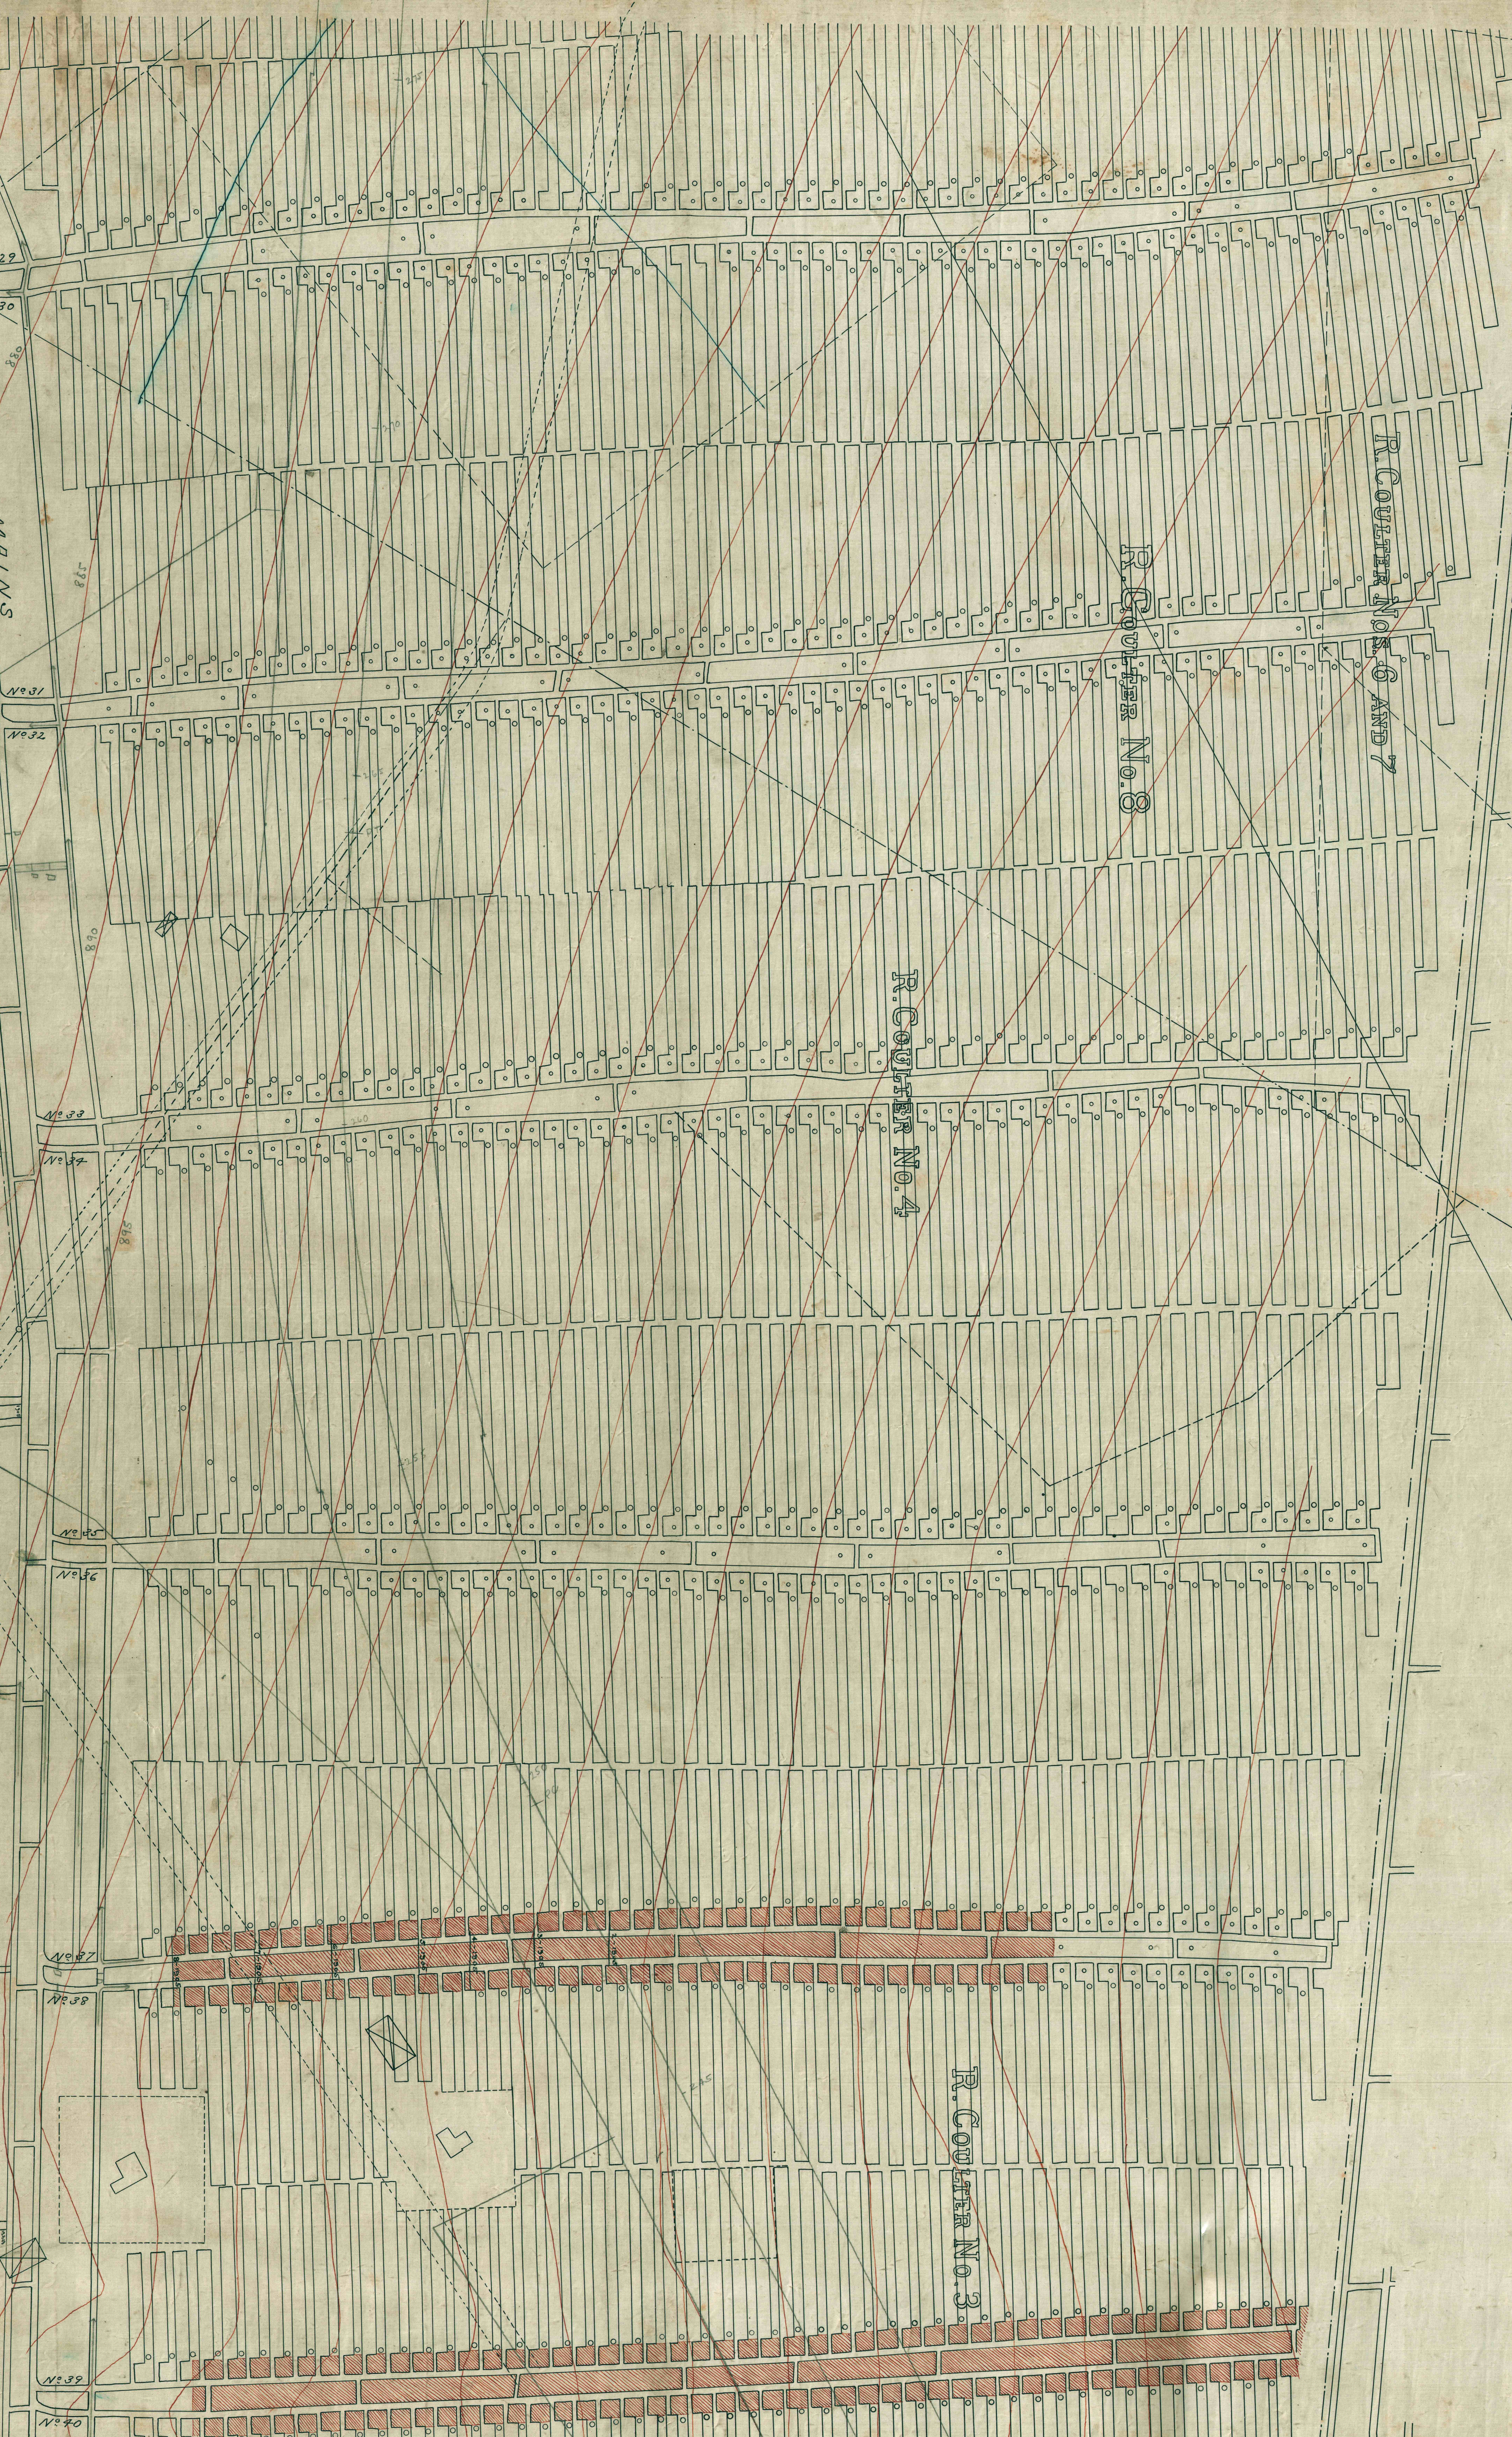


R. COOPER No. 7

R. COOPER No. 8

R. COOPER No. 4

R. COOPER No. 3

UPPER MAINS

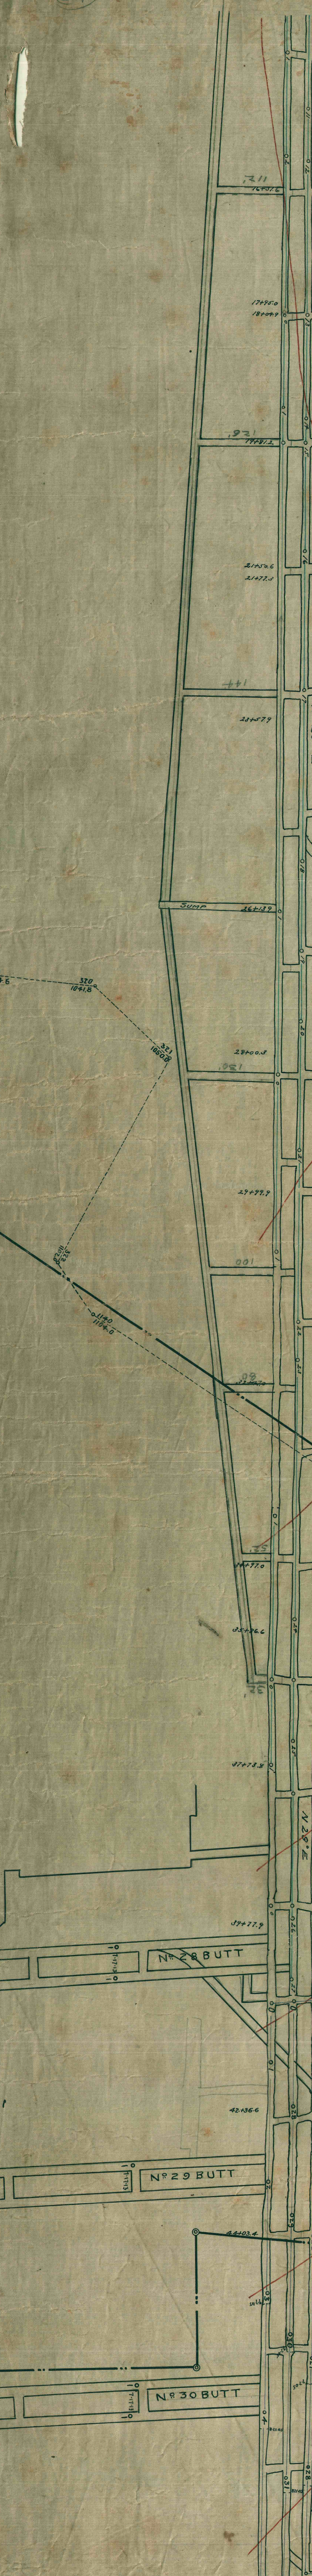

N 29 BUTT
N 28 BUTT
N 27 BUTT
N 26 BUTT
N 25 BUTT
N 24 BUTT
N 23 BUTT
N 22 BUTT
N 21 BUTT
N 20 BUTT
N 19 BUTT
N 18 BUTT
N 17 BUTT
N 16 BUTT
N 15 BUTT
N 14 BUTT
N 13 BUTT
N 12 BUTT
N 11 BUTT
N 10 BUTT
N 9 BUTT
N 8 BUTT
N 7 BUTT
N 6 BUTT
N 5 BUTT
N 4 BUTT
N 3 BUTT
N 2 BUTT
N 1 BUTT

130
131
132
133
134
135
136
137
138
139
140
141
142
143
144
145
146
147
148
149
150