



A-54-10-12

PLAN OF THE BRIDGEVILLE MINES SITUATED AT BRIDGEVILLE ALLEY CO PA OWNED AND OPERATED BY BRIDGEVILLE CONS. CO PITTSBURGH, PA.

March 1896

Scale 1:1000

Date of last survey
September 1894

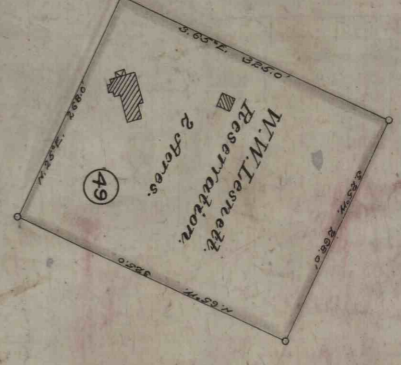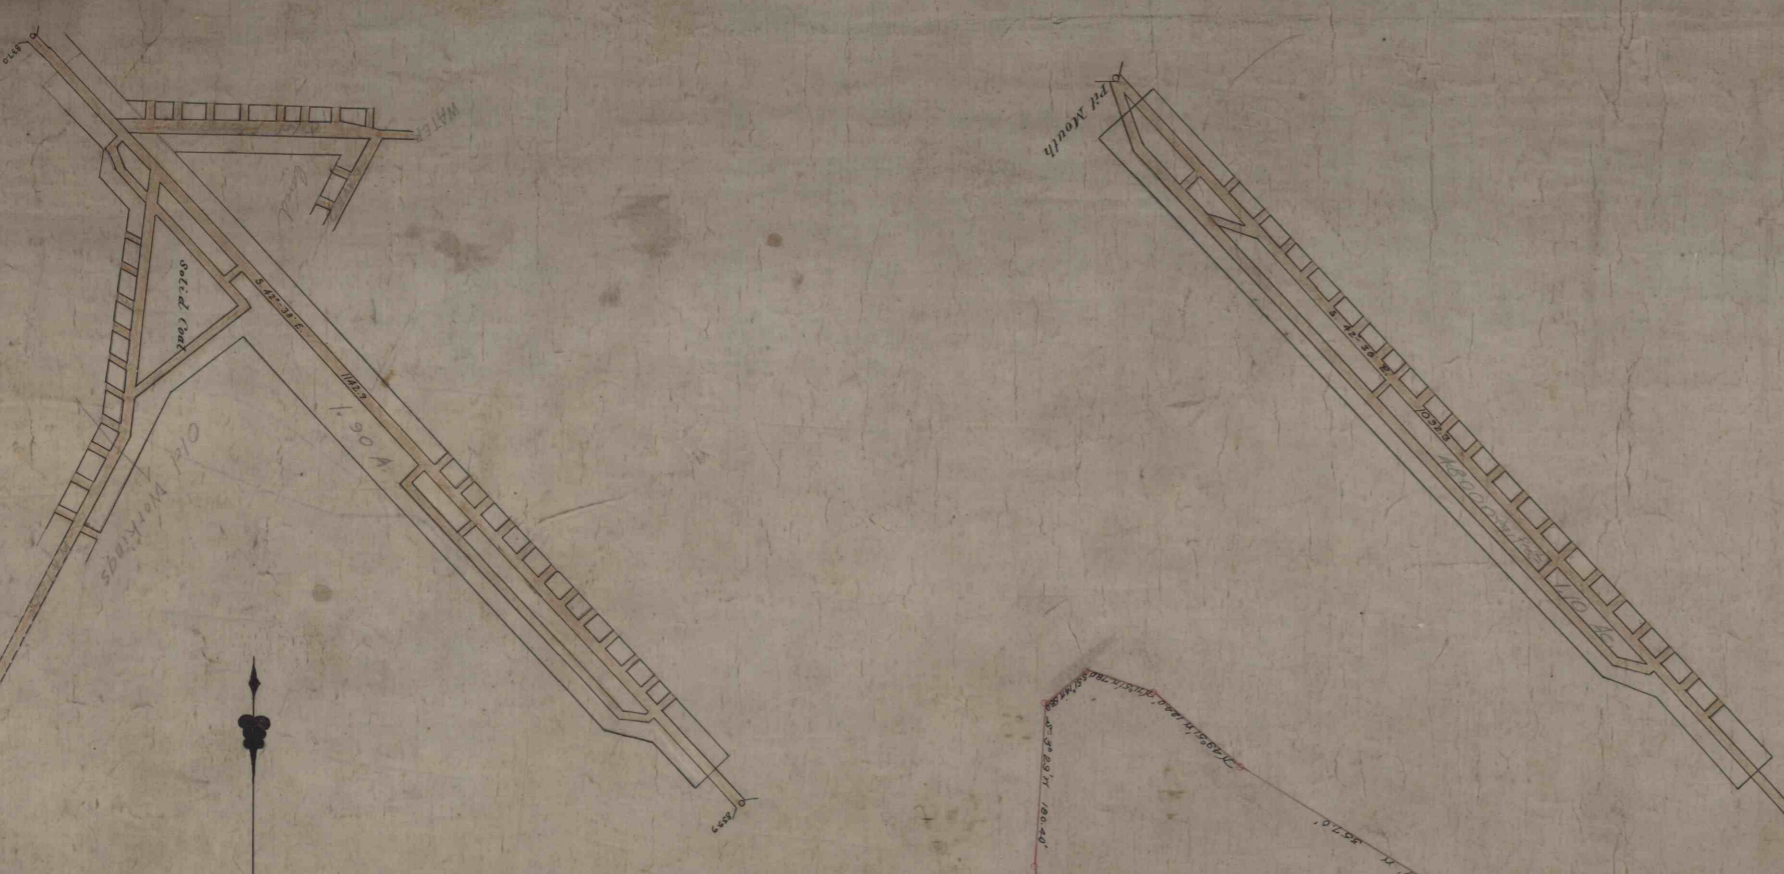

M.W. LESNETT
2833 A.

Modern Has

W.M. RAYNER