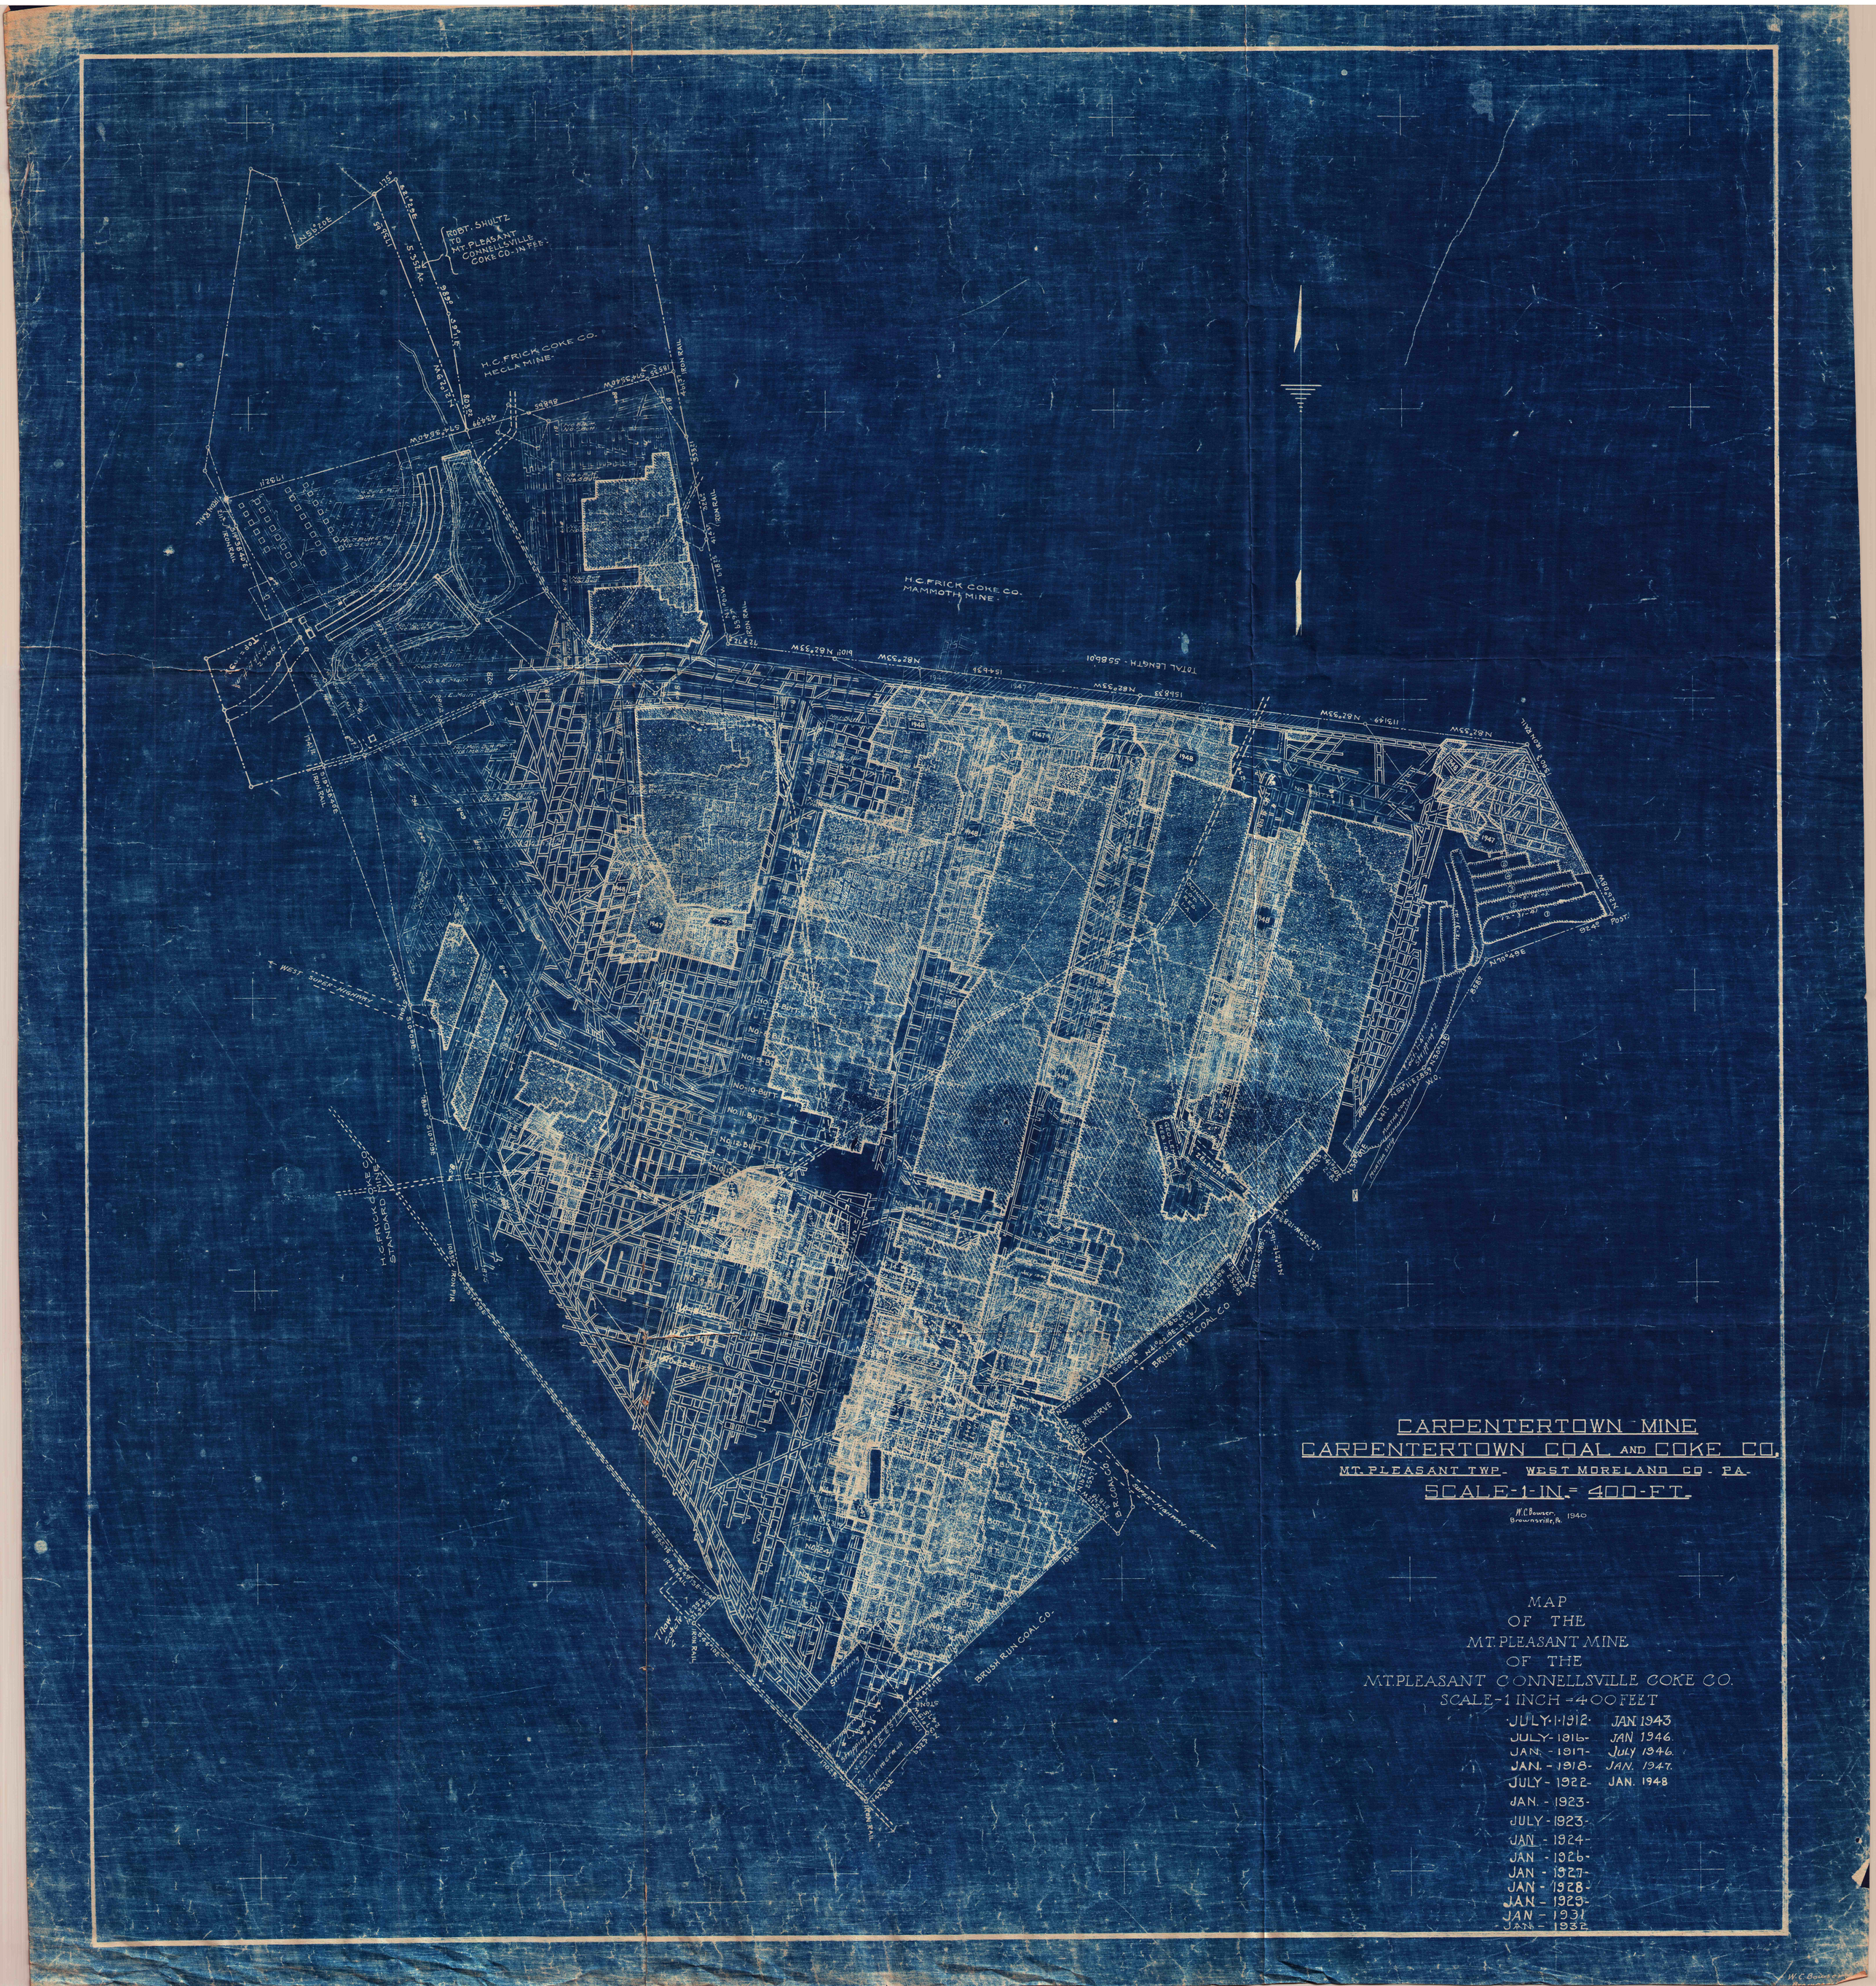
ROBT. SHULTZ
TO
MT. PLEASANT
CONNELLSVILLE
COKE CO. IN FEE
H.C. FRICK COKE CO.
HECLA MINE
H.C. FRICK COKE CO.
MAMMOTH MINE
TOTAL LENGTH - 5586.01
WEST SUPER HIGHWAY
H.C. FRICK COKE CO.
STANDARD MINE
BRUSH RUN COAL CO.
CARPENTERTOWN MINE
CARPENTERTOWN COAL AND COKE CO.
MT. PLEASANT TWP. - WEST MORELAND CO. - PA.
SCALE - 1 - IN. = 400 - FT.
W.C. Bowser,
Brownsville, Pa. 1940
MAP
OF THE
MT. PLEASANT MINE
OF THE
MT. PLEASANT CONNELLSVILLE COKE CO.
SCALE - 1 INCH = 400 FEET
JULY - 1 - 1912 - JAN 1943
JULY - 1916 - JAN 1946.
JAN. - 1917 - July 1946.
JAN. - 1918 - JAN. 1947.
JULY - 1922 - JAN. 1948
JAN. - 1923 -
JULY - 1923 -
JAN. - 1924 -
JAN. - 1926 -
JAN. - 1927 -
JAN. - 1928 -
JAN. - 1929 -
JAN. - 1931
JAN. - 1932