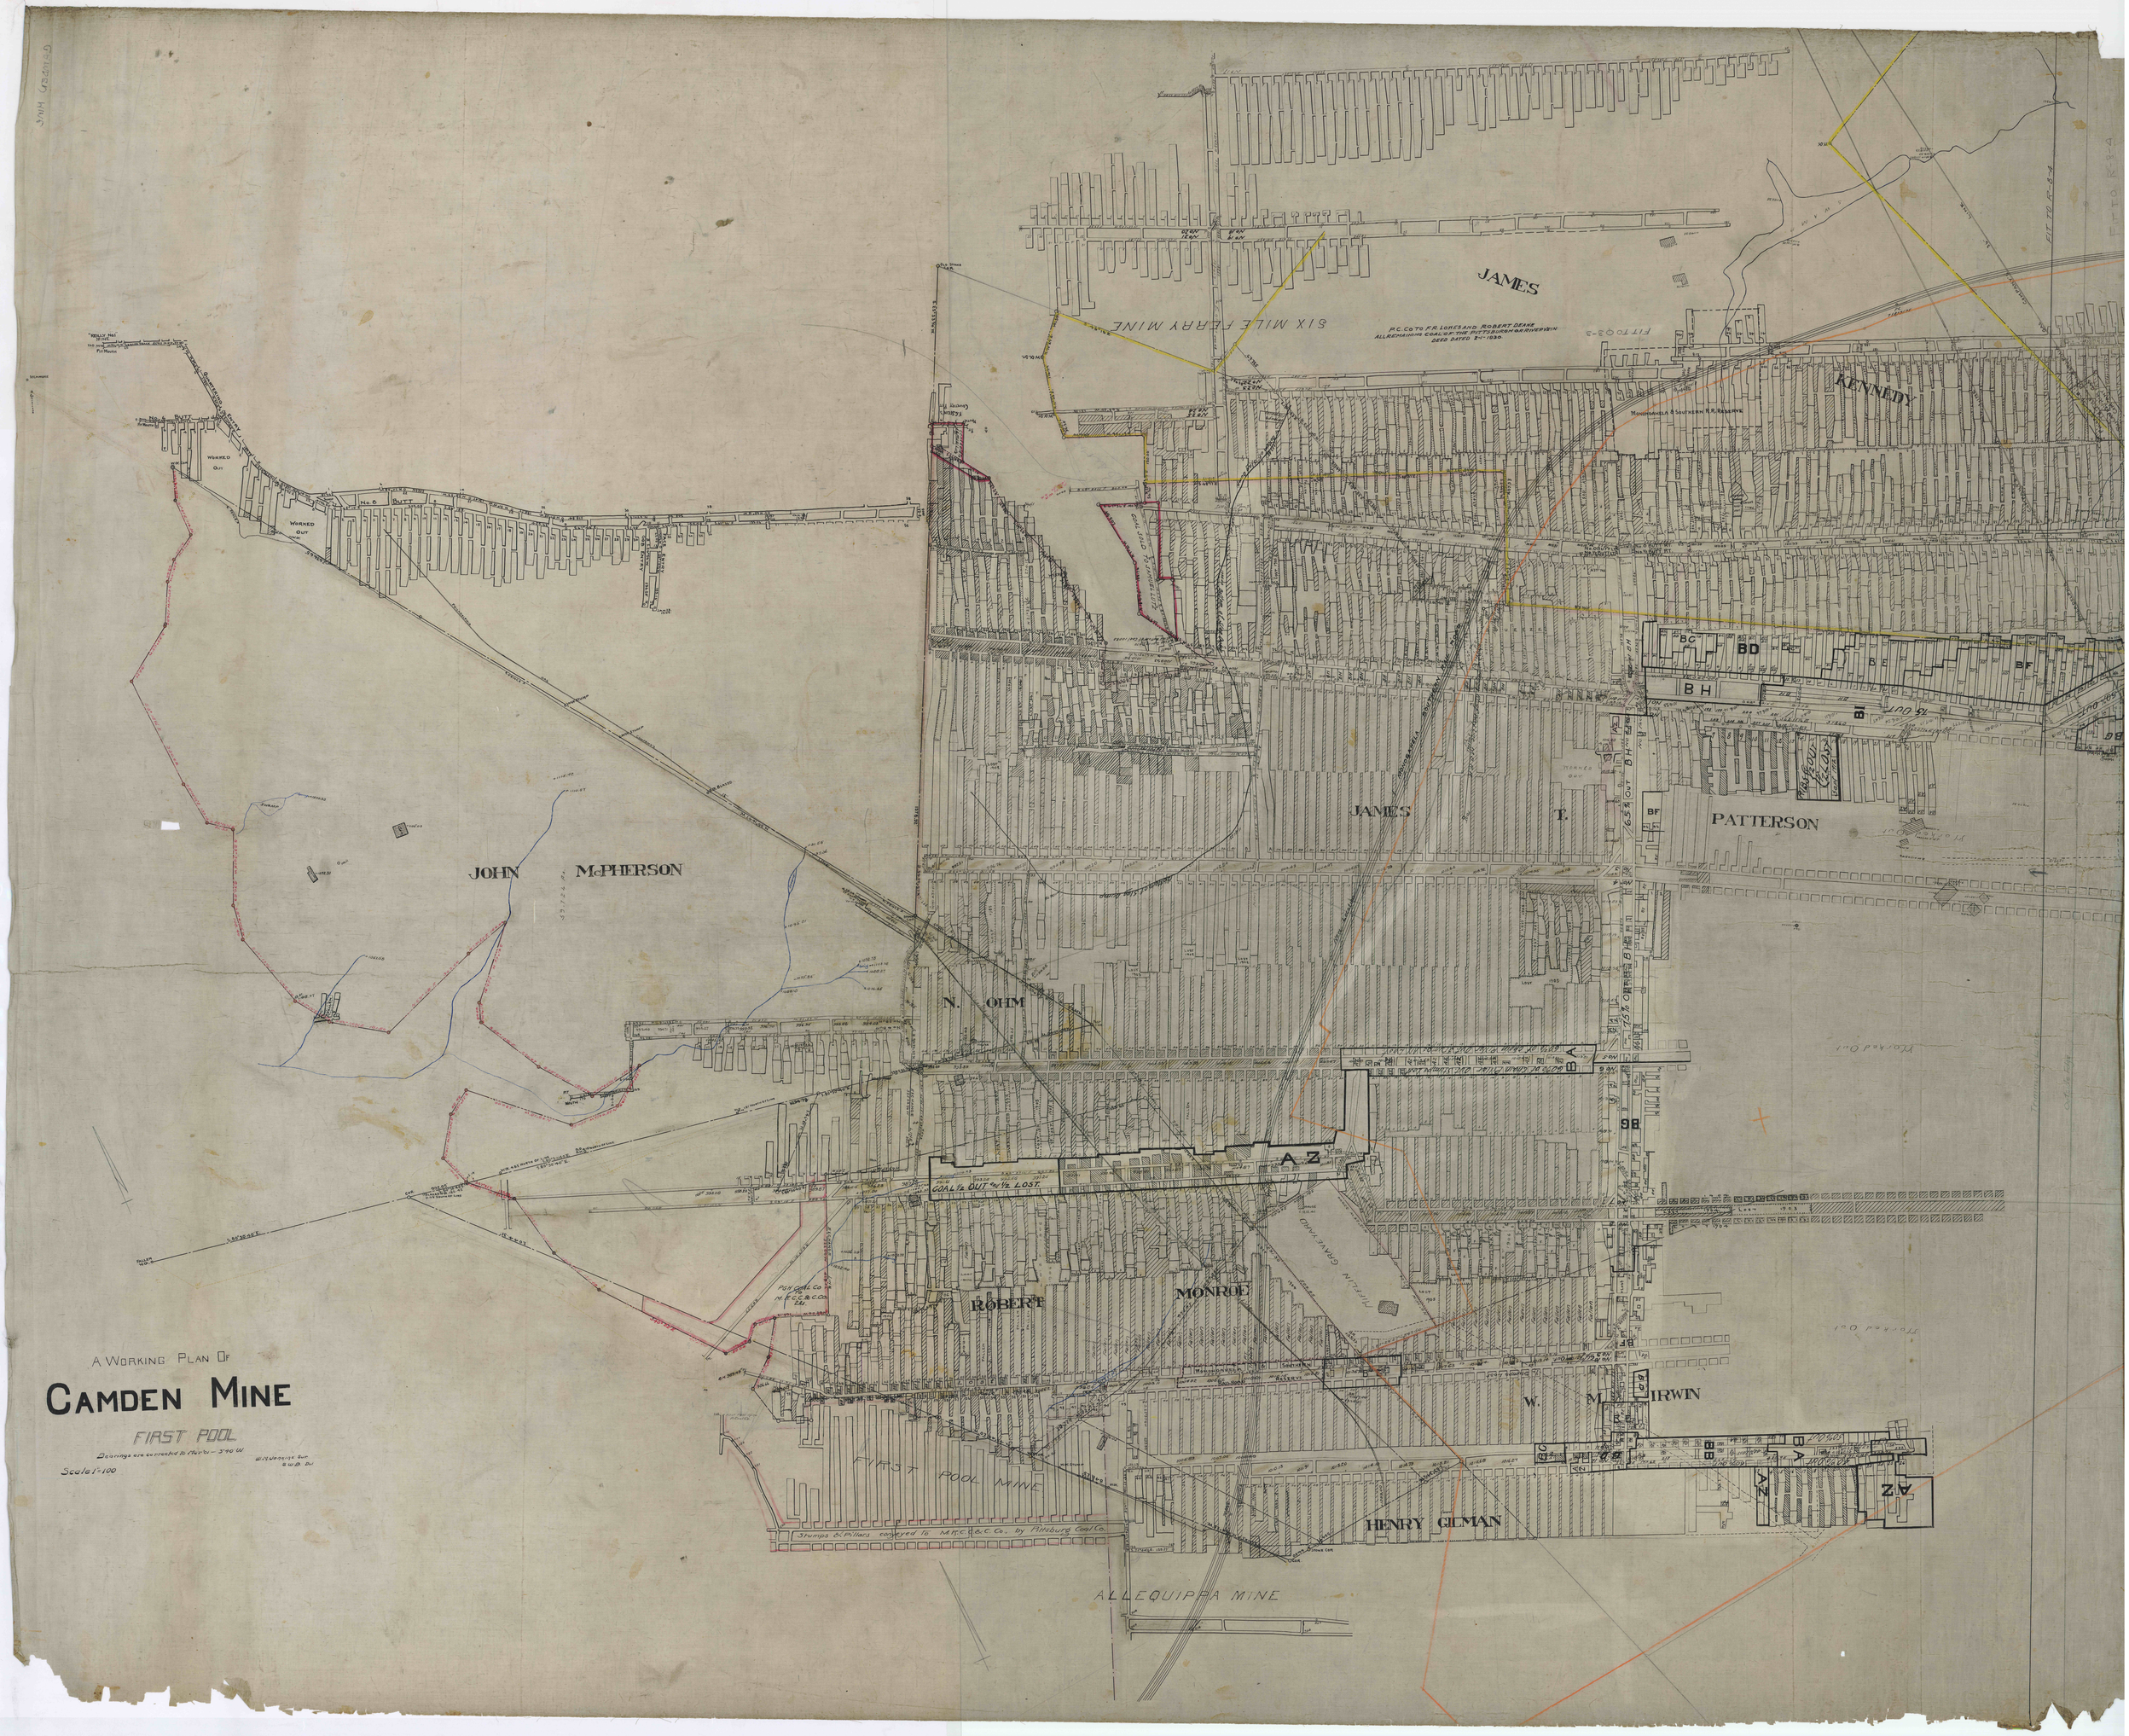
A WORKING PLAN OF
CAMDEN MINE
FIRST POOL
Scale 1"=100
JAMES
KENNEDY
SIX MILE FERRY MINE
JAMES T. PATTERSON
JOHN McPHERSON
N. OHM
ROBERT MONROE
W. M. IRWIN
HENRY GILMAN
FIRST POOL MINE
ALLEQUIPPA MINE
COAL ½ OUT and ½ LOST
Stumps & Pillars conveyed to M.R.C.C.&C.Co. by Pittsburg Coal Co.