

Map to California Mine Trac 7-1-5

KEEP WITH 12-A-16

ADDITION-A

CO

C

B

C

LILLEY

MINED OUT

Fire Area

POWER HOUSE


Material
 To St. Louis
 About 100,000 tons
 10" x 45" Bands
 10" x 30"

BROWNVILLE

Exchange Line

West 16272

Vesta Coal Co

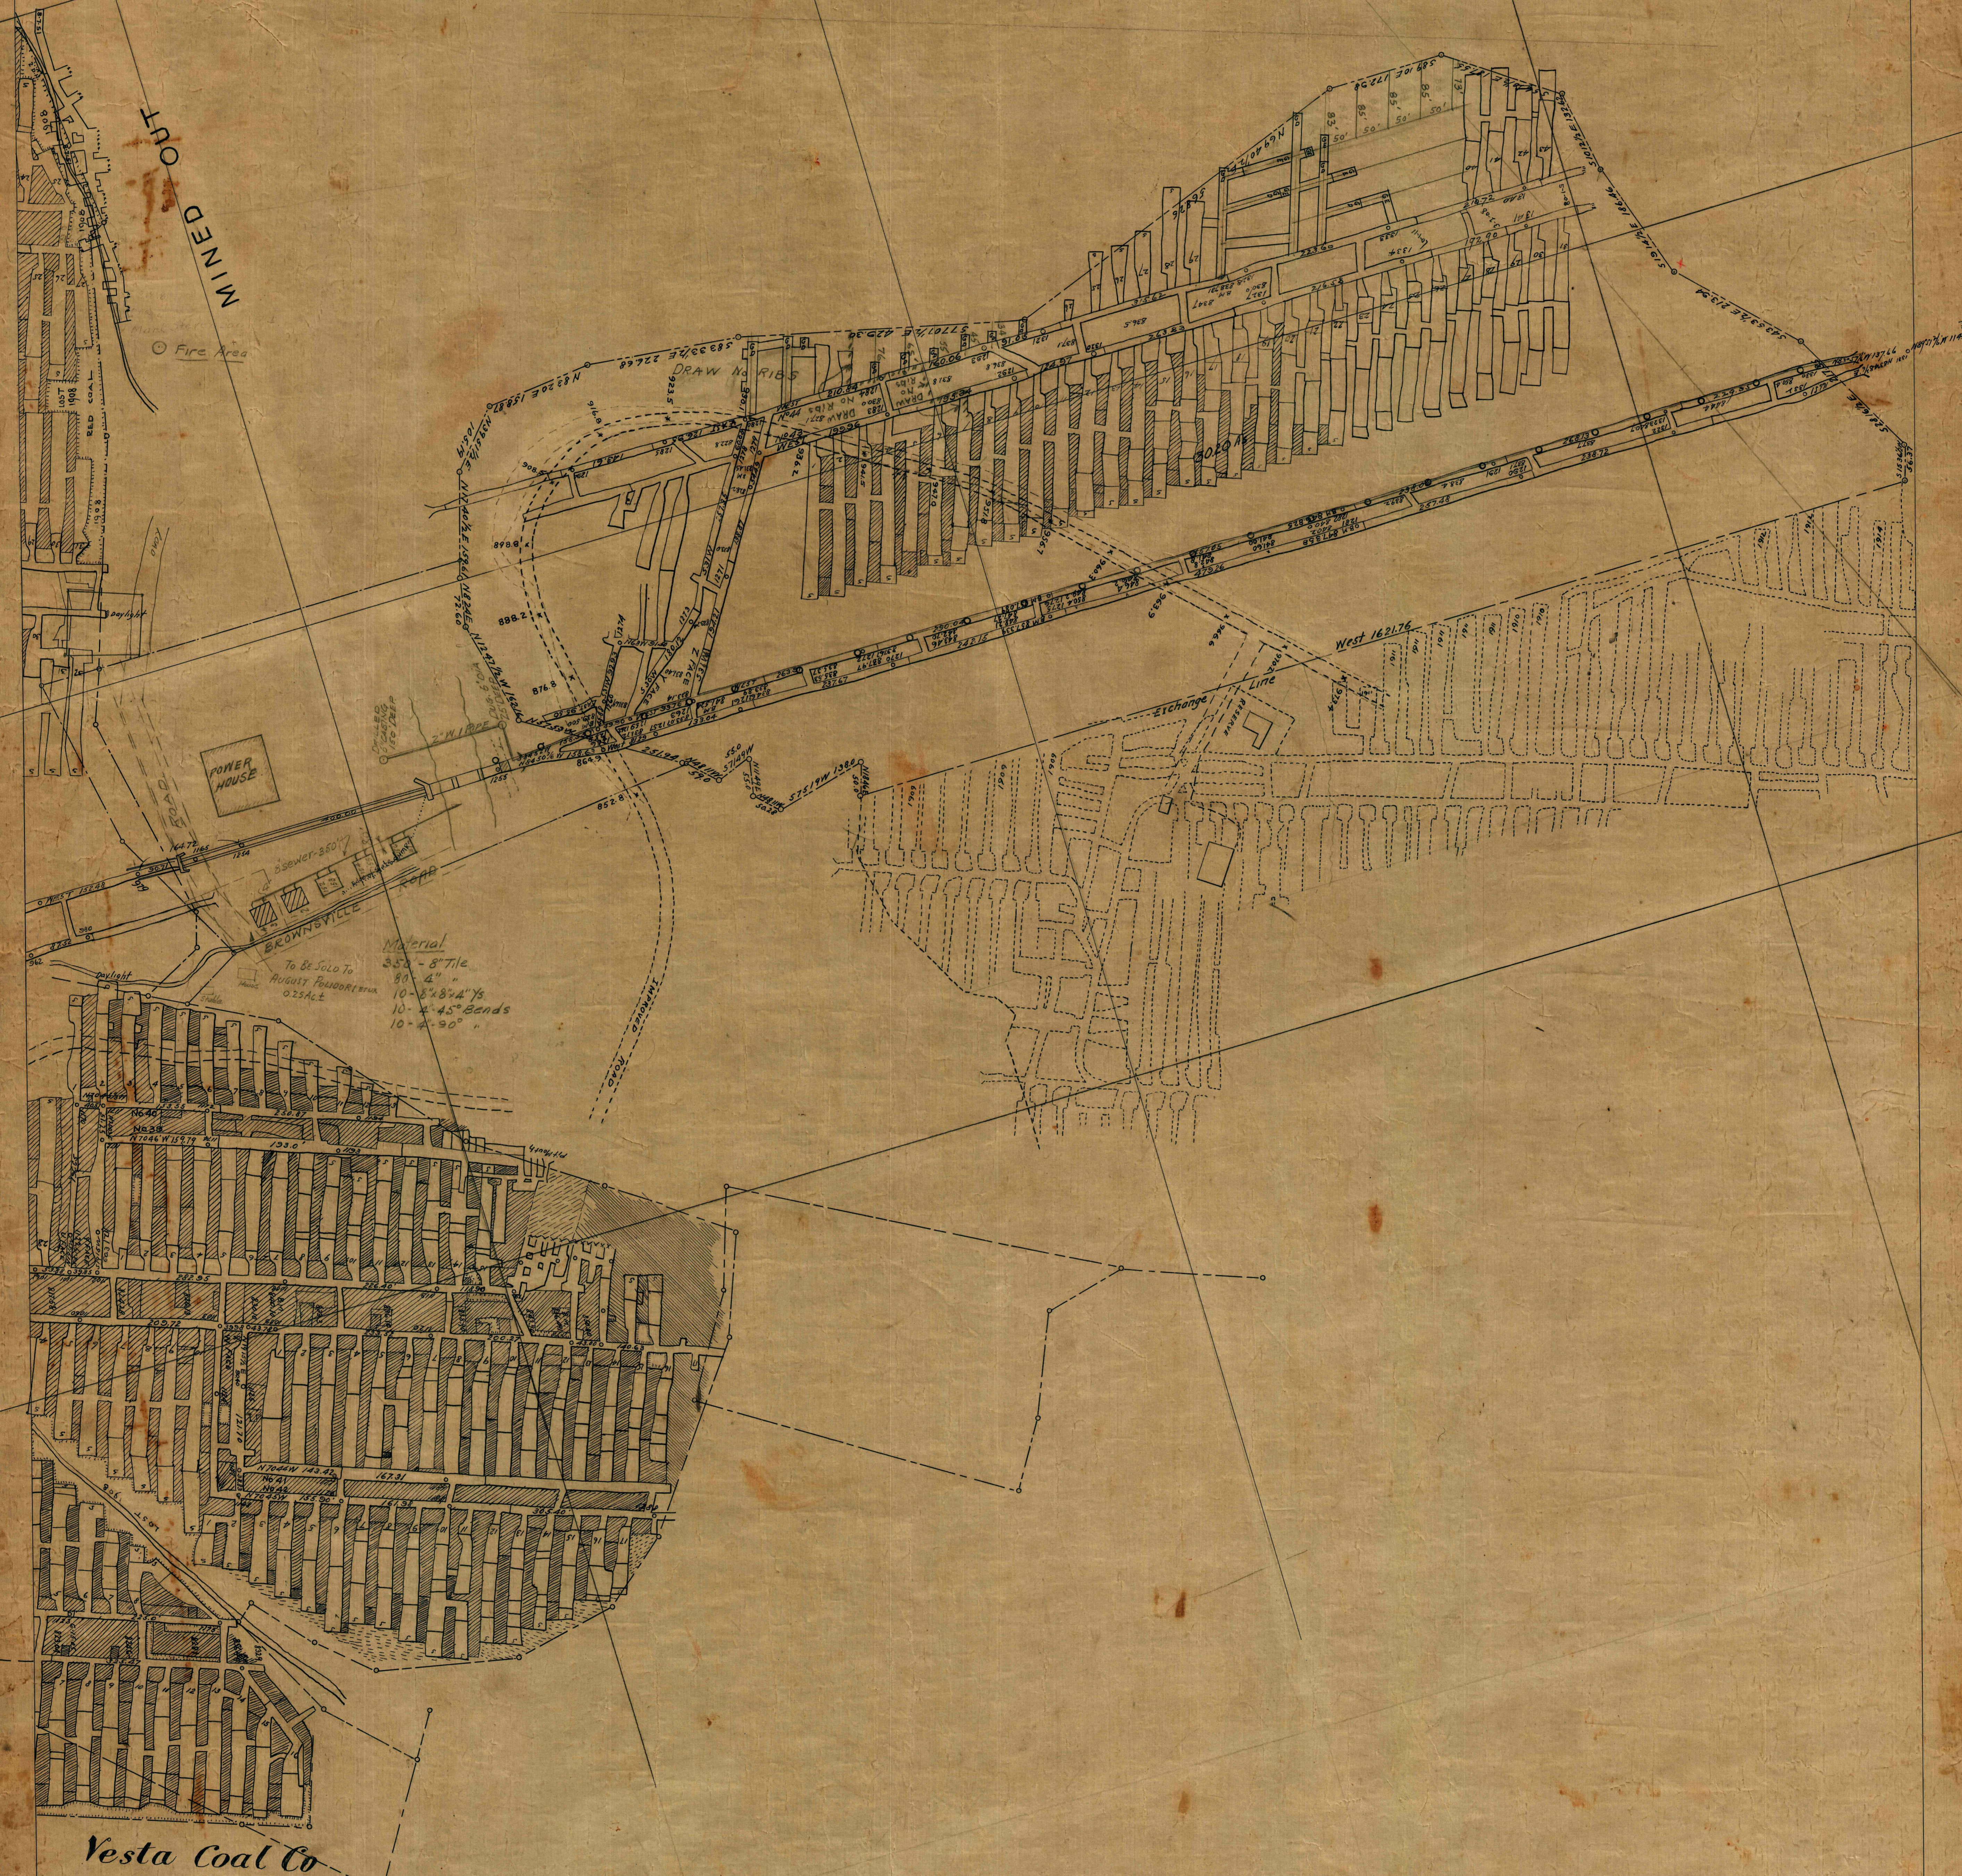

Keep with 7-1-5

434-08