


PORTION OF CRESCENT MINE.

T-1-5

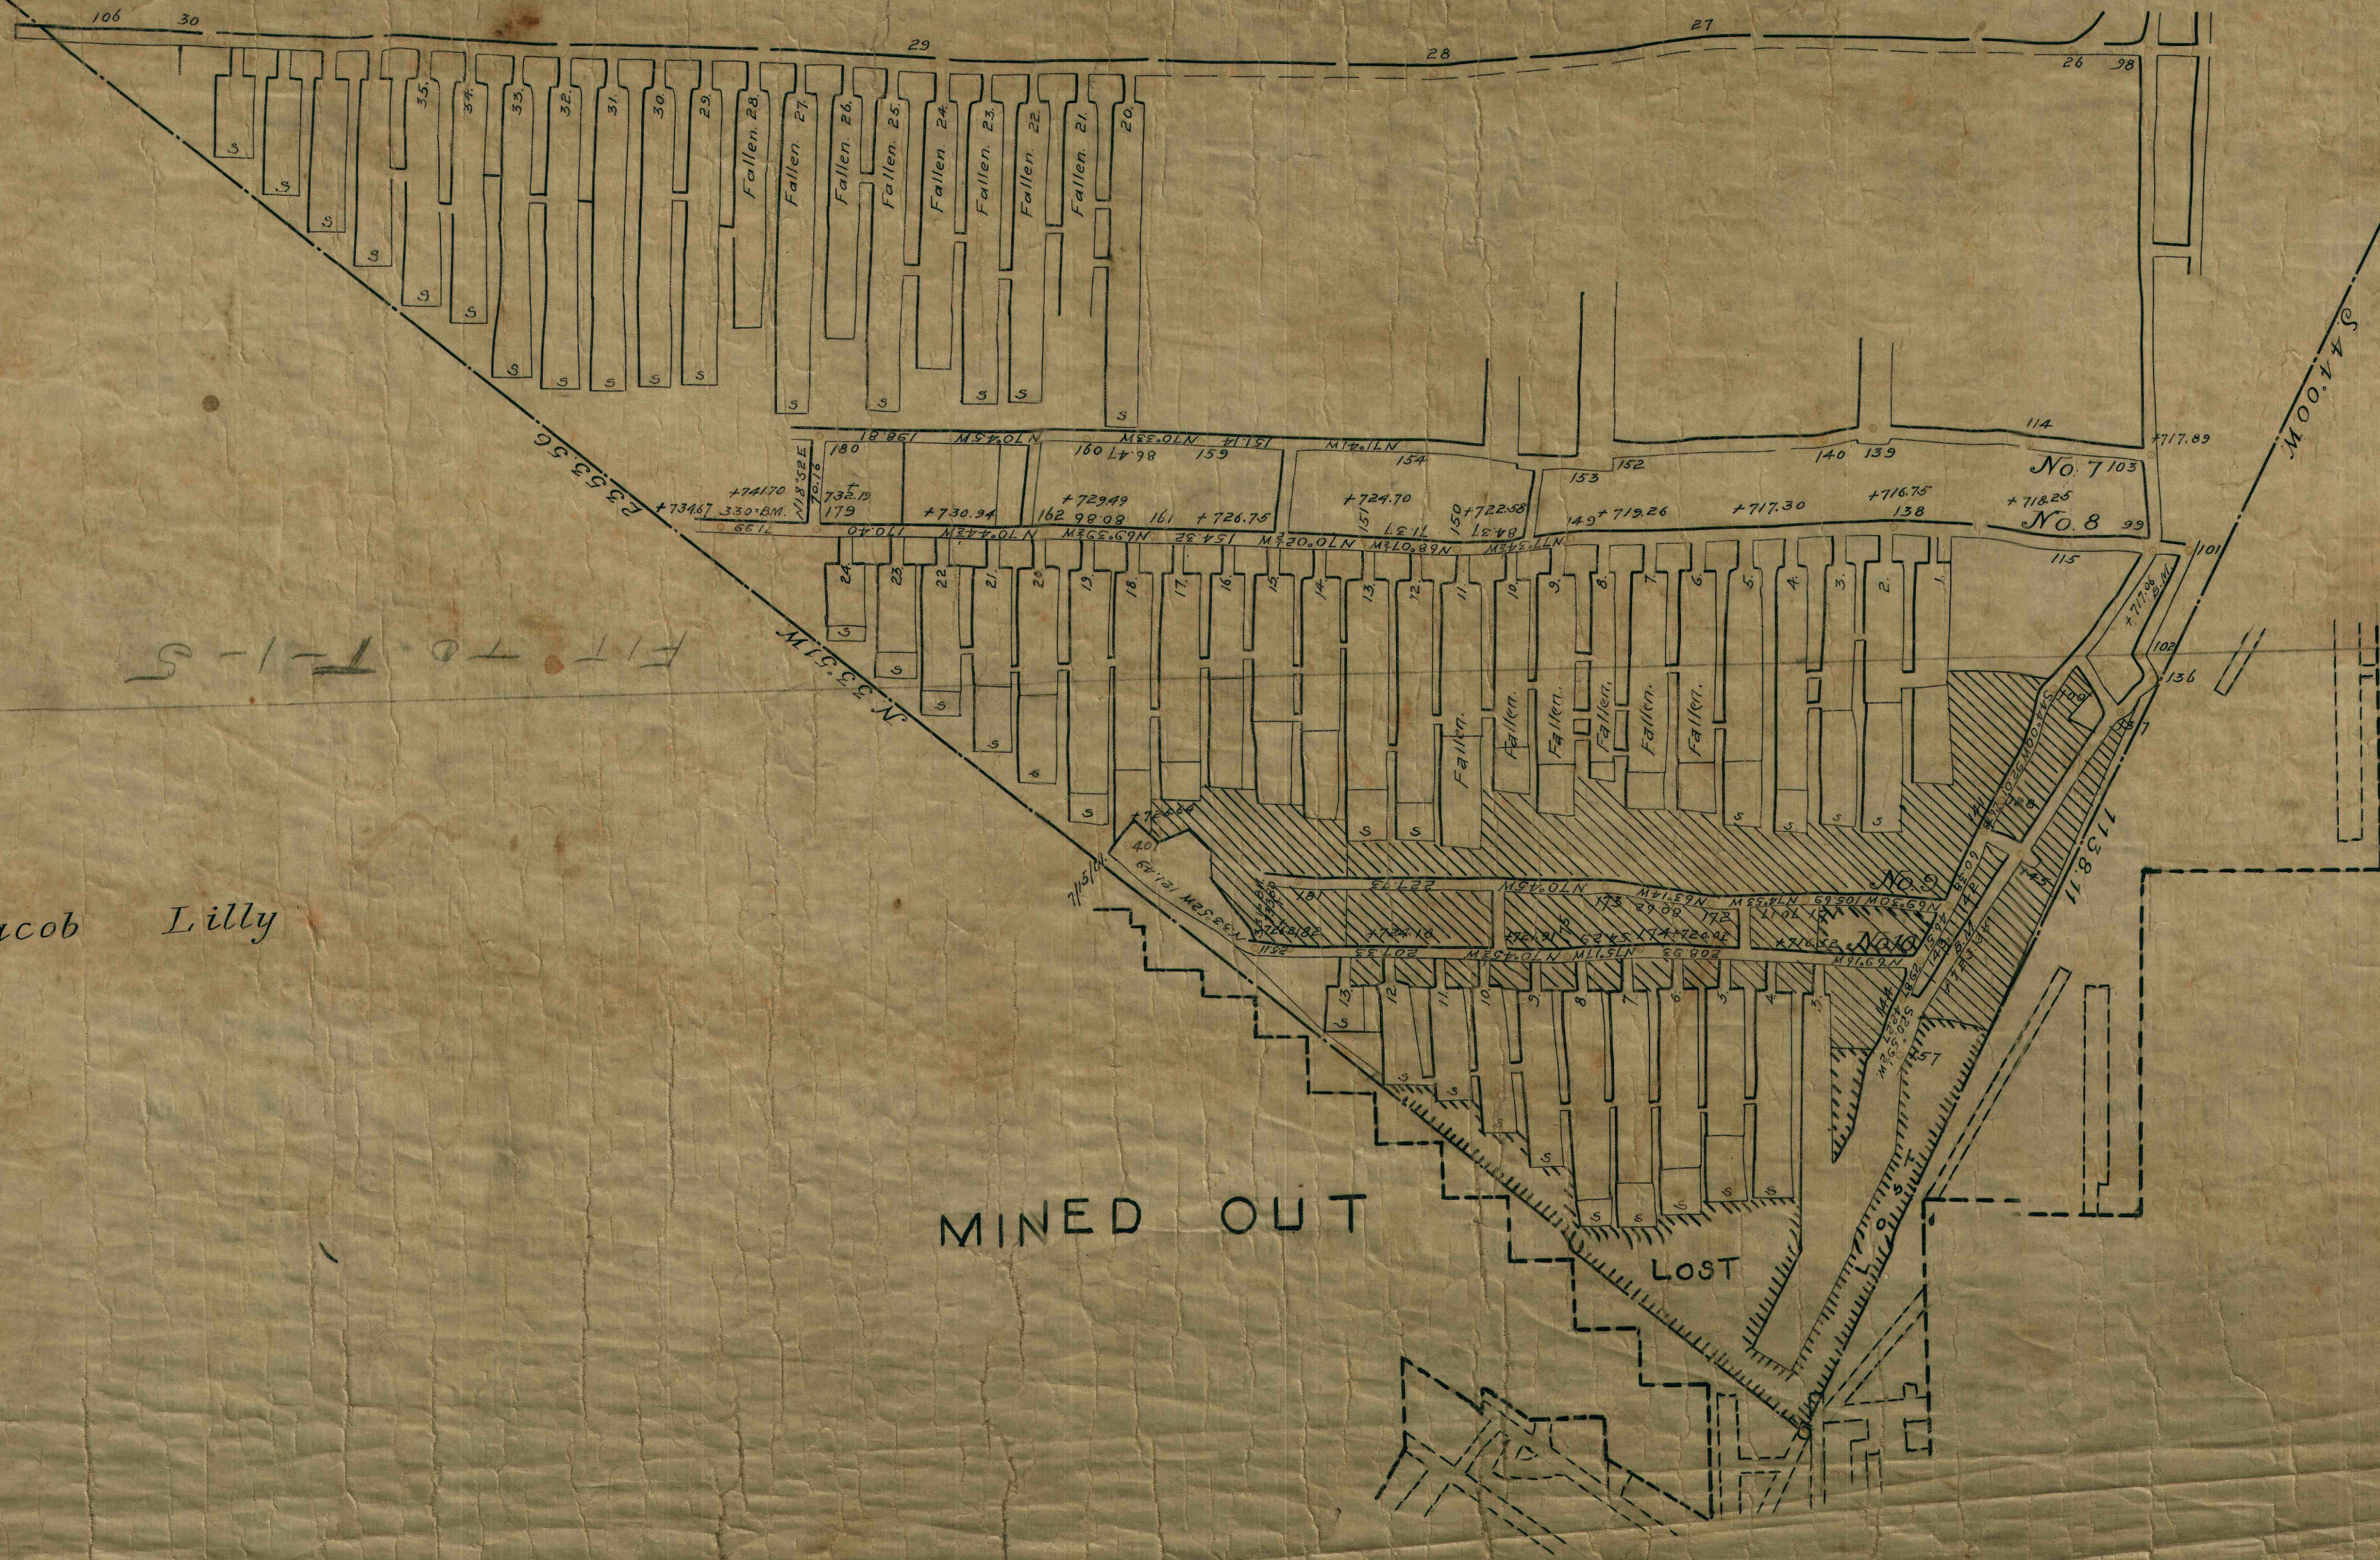

Jacob Lilly

FIT TO T-1-5

MINED OUT

LOST

ADDITION TO T-1-5

ADDITION TO B T-1-5