


H.C. FRICK COKE CO.
MAMMOTH MINE

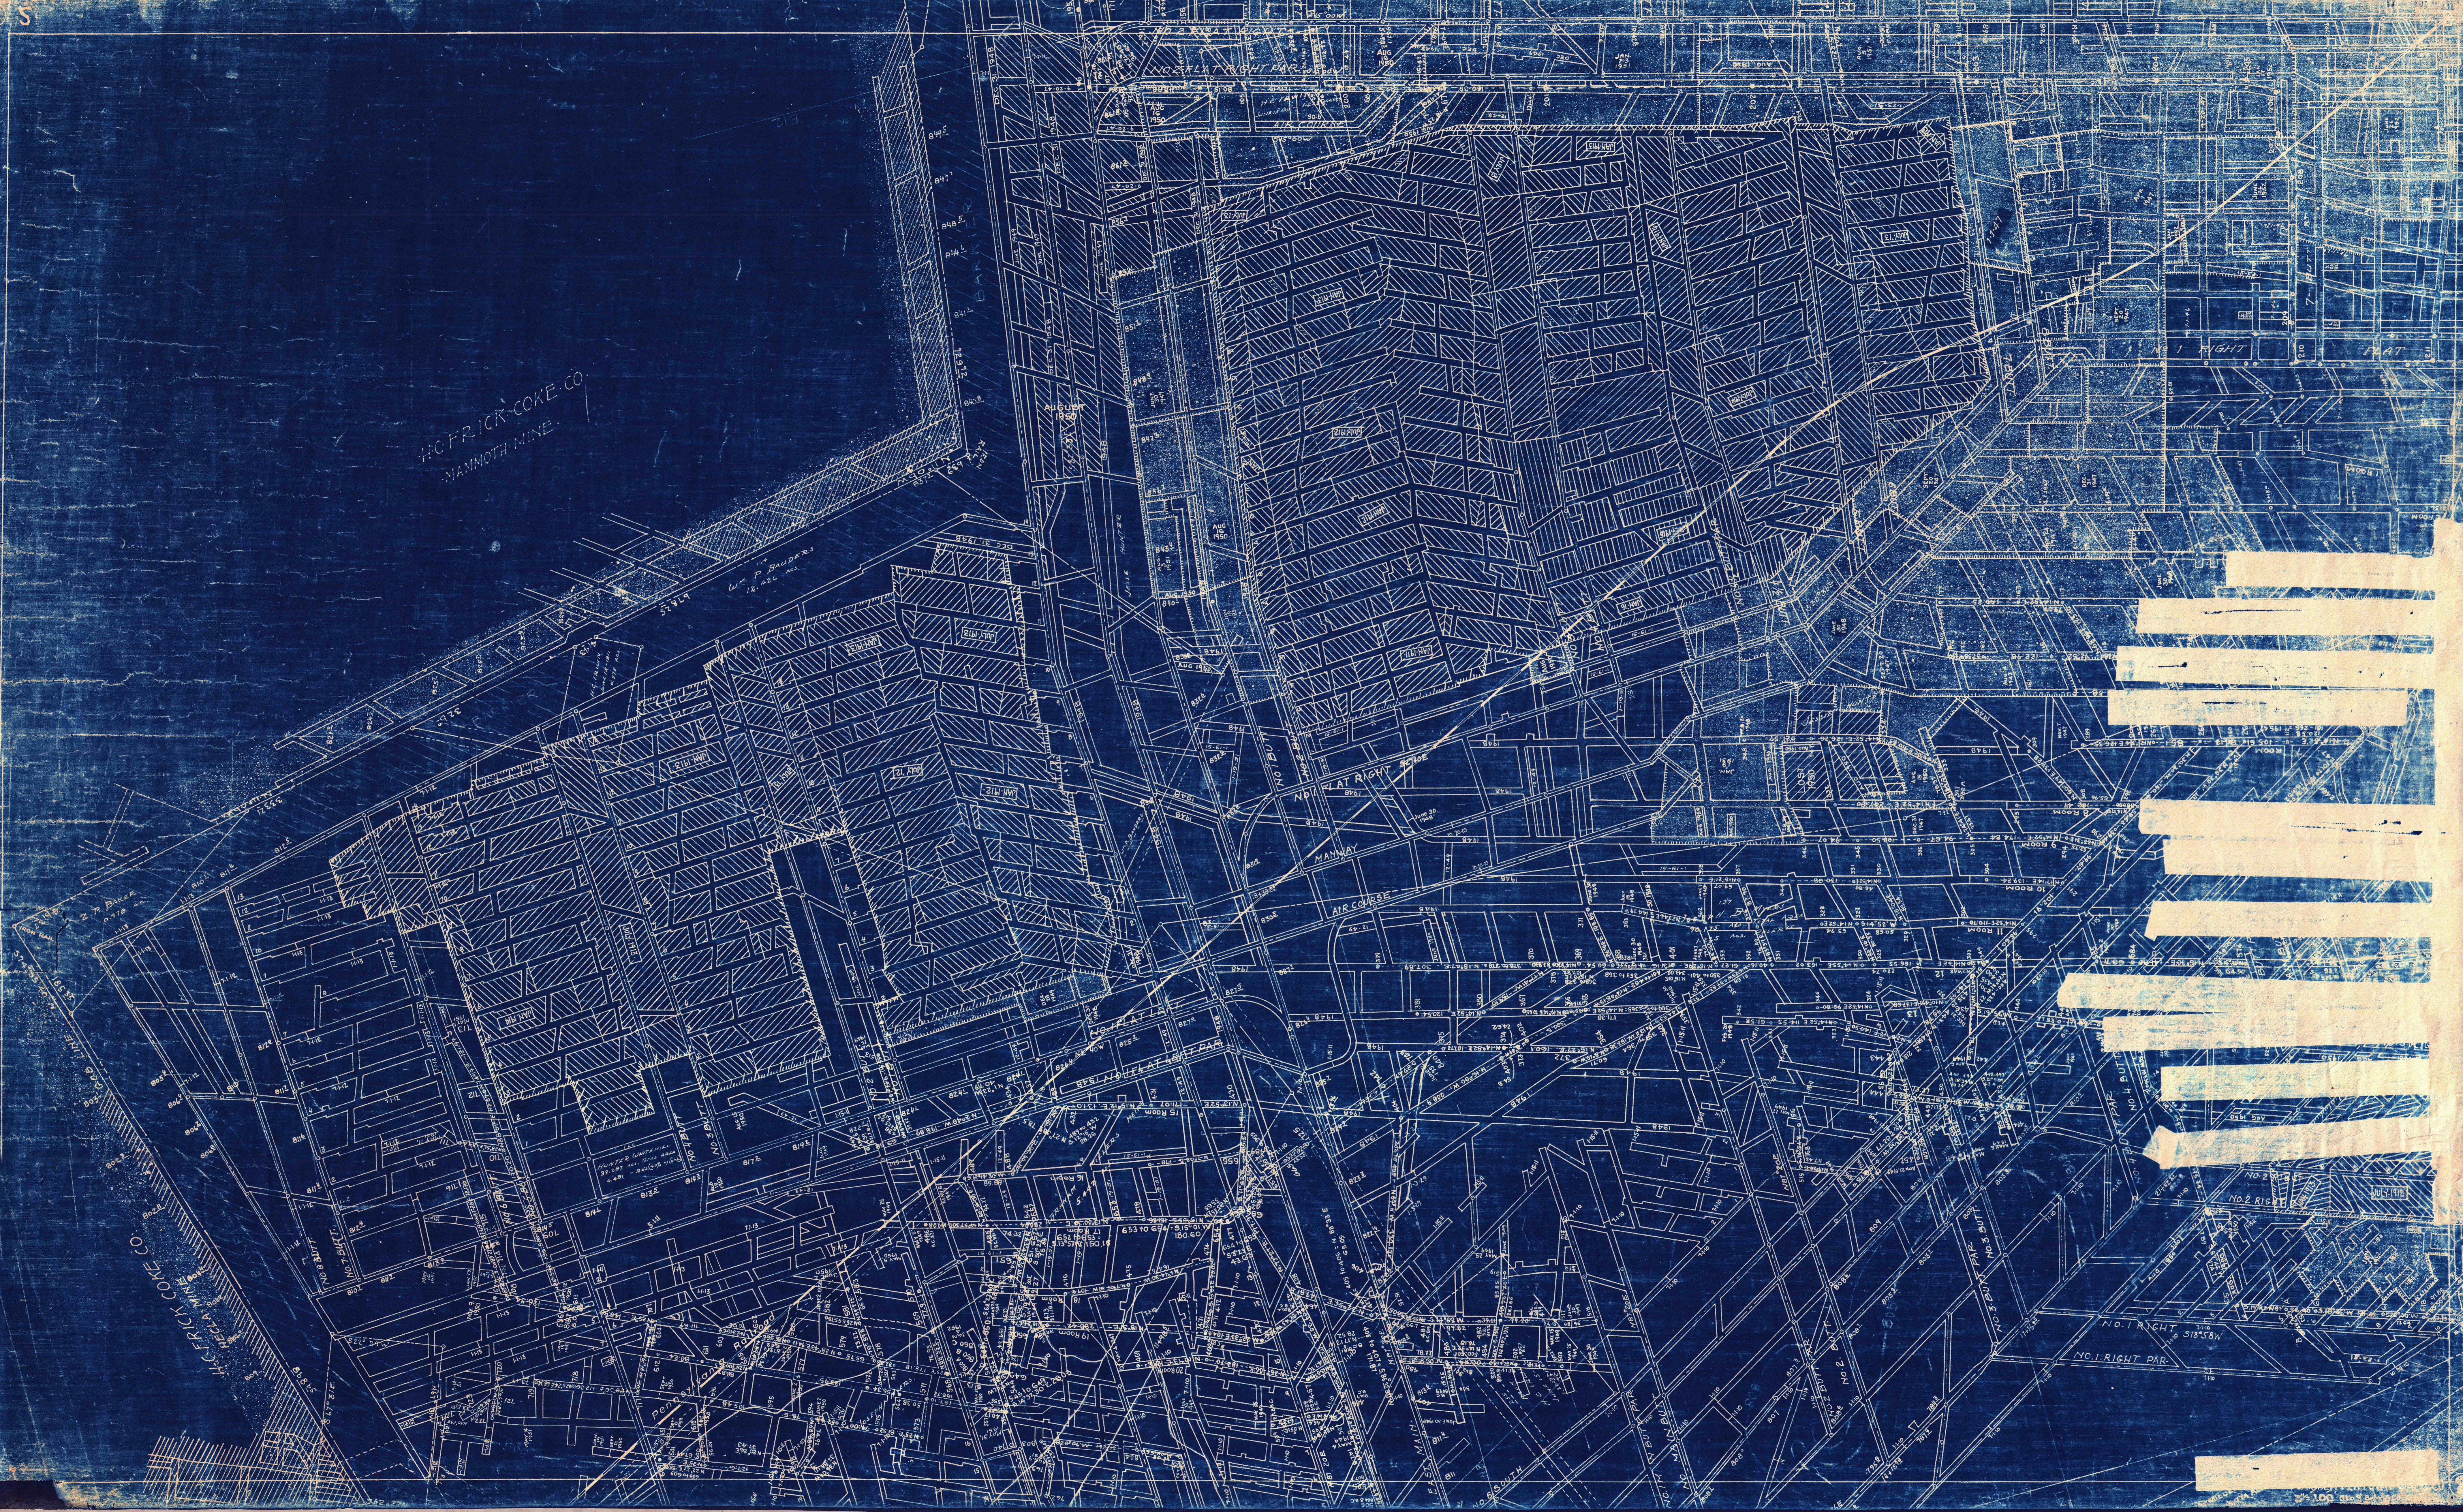


