


Addition to Cincinnati Mine
 Scale 1" = 100'
 Keep with T-1-2

Proposed
 Gas Well
 River View
 Oil & Gas

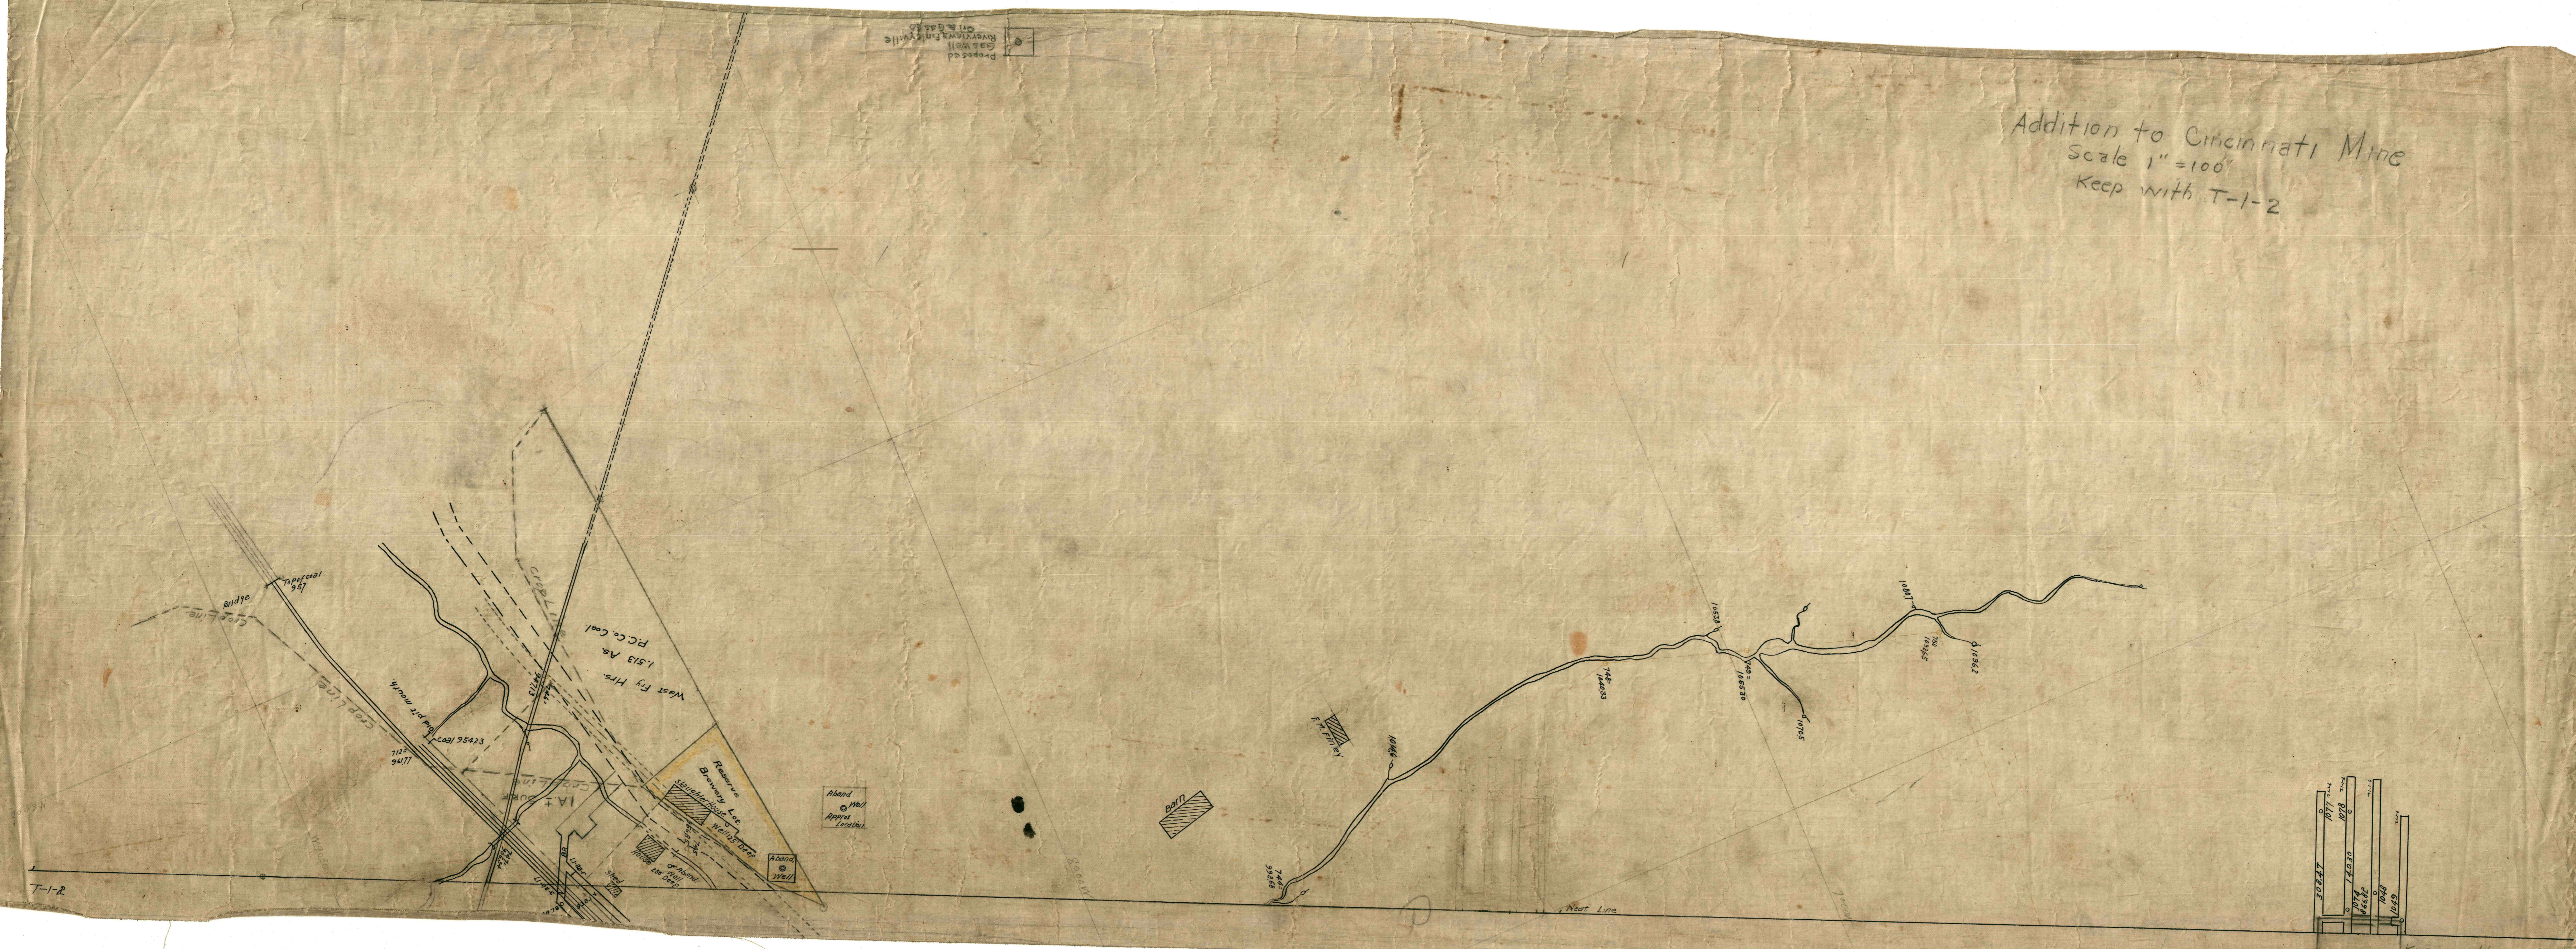

104017	104015	104016	744 99008	744 104033	749 104030

Keep with T-1-2