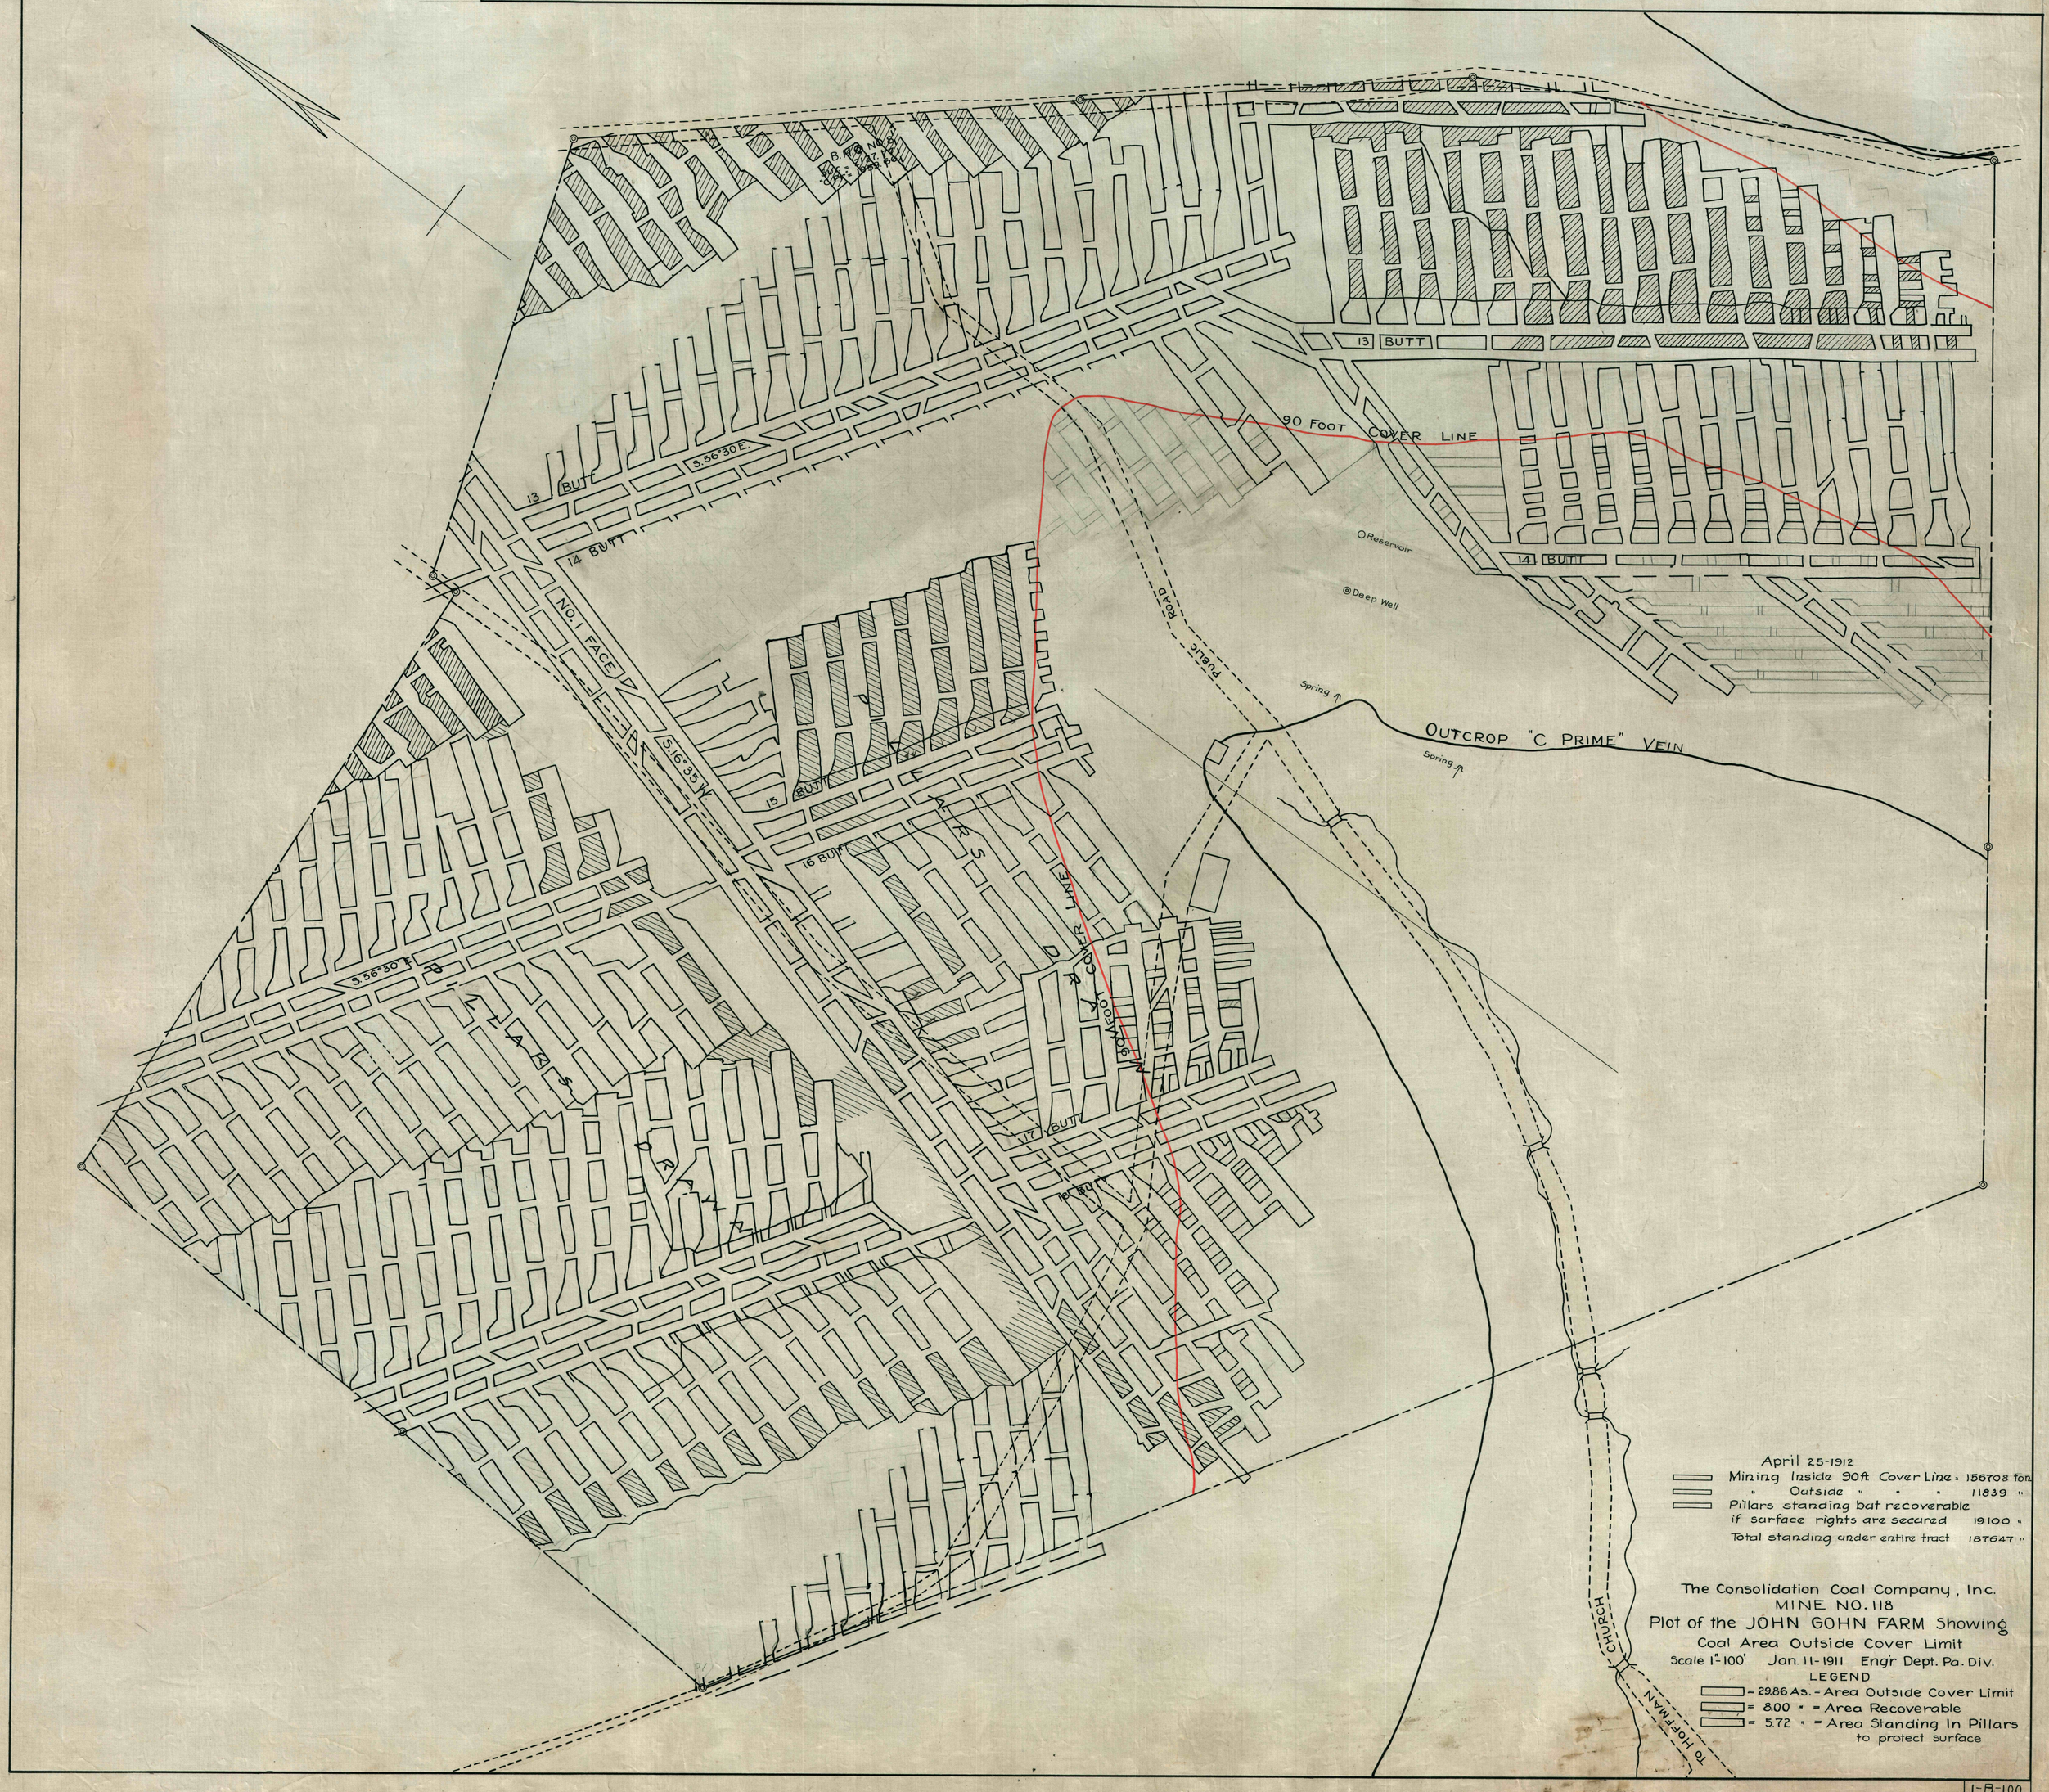

13 BUTT
14 BUTT
90 FOOT COVER LINE
S.56°30'E.
NO. 1 FACE
S.16°35'W.
15 BUTT
16 BUTT
17 BUTT
18 BUTT
PILLARS DRAWN
PILLARS DRAWN
Reservoir
Deep Well
PUBLIC ROAD
Spring
OUTCROP "C PRIME" VEIN
CHURCH
TO HOFFMAN
April 25-1912
Mining Inside 90ft. Cover Line = 156708 ton
" Outside " " " 11839 "
Pillars standing but recoverable
if surface rights are secured 19100 "
Total standing under entire tract 187647 "
The Consolidation Coal Company, Inc.
MINE NO. 118
Plot of the JOHN GOHN FARM Showing
Coal Area Outside Cover Limit
Scale 1"=100' Jan. 11-1911 Eng'r Dept. Pa. Div.
LEGEND
= 29.86 As. = Area Outside Cover Limit
= 8.00 " = Area Recoverable
= 5.72 " = Area Standing In Pillars
to protect surface
1-B-100