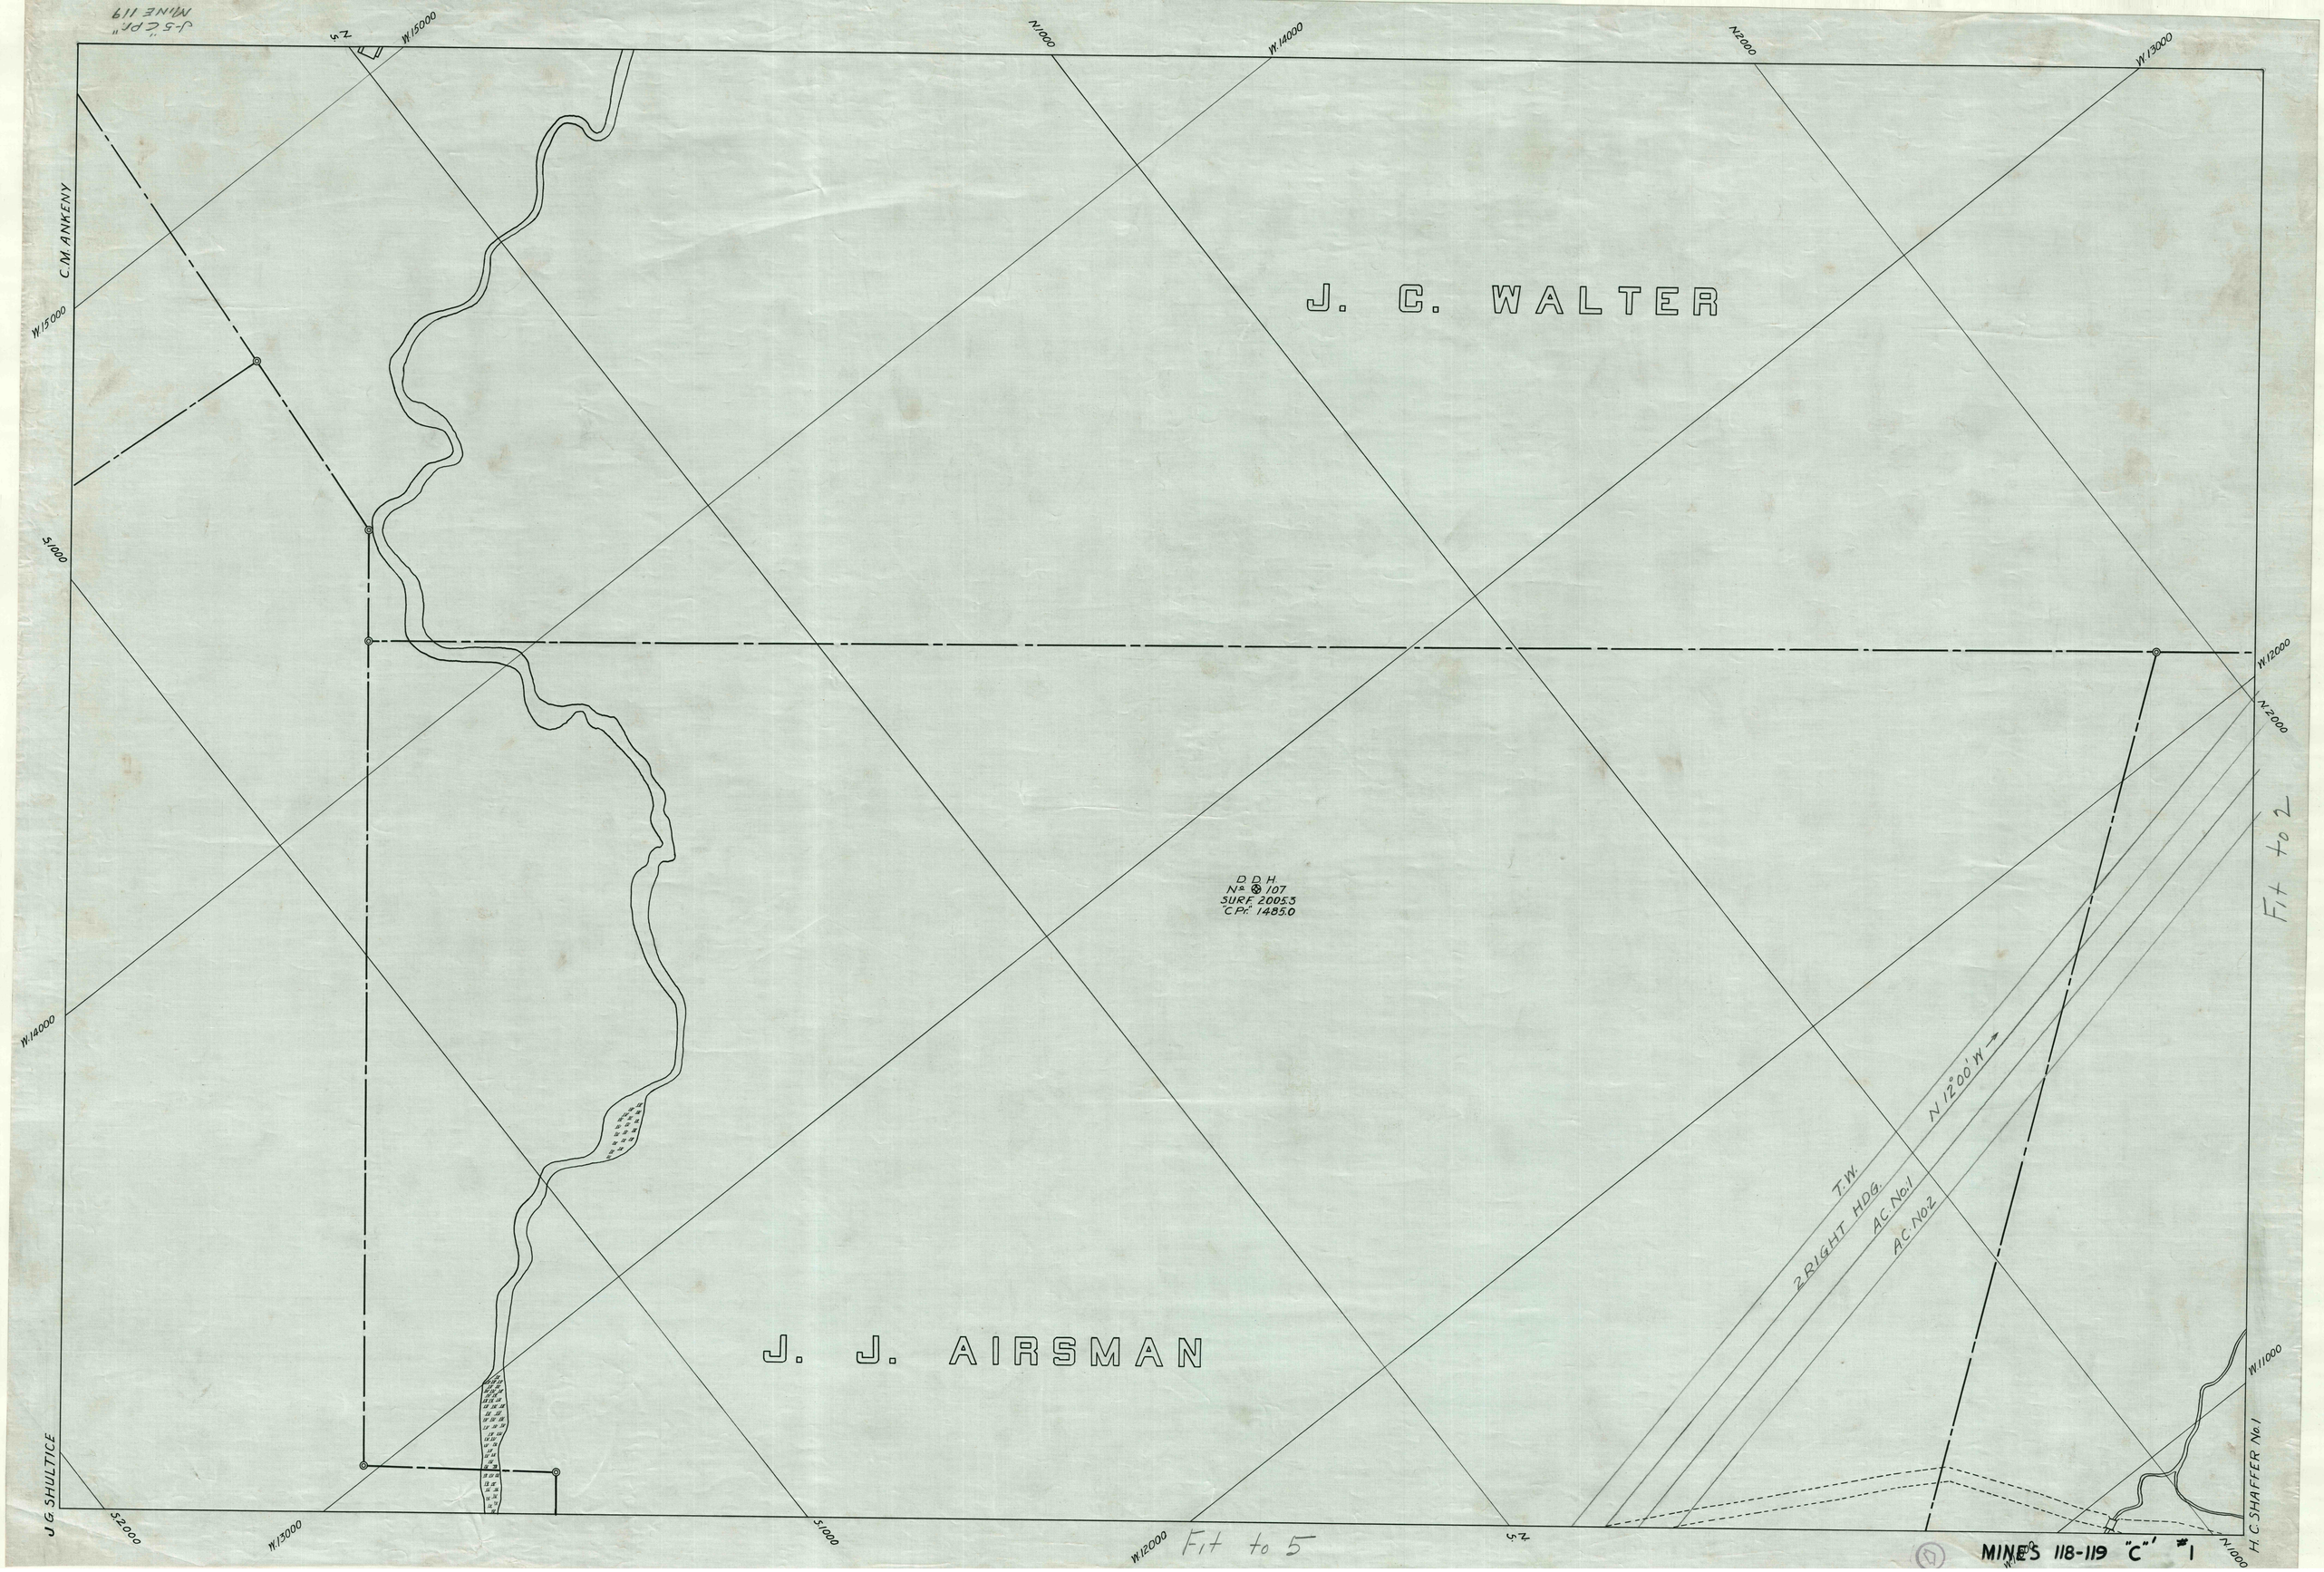
J. C. WALTER
J. J. AIRSMAN
C.M. ANKENY
J.G. SHULTICE
H.C. SHAFFER No.1
D.D.H.
No. 107
SURF. 2005.3
"C.Pr." 1485.0
T.W.
2 RIGHT HDG.
AC. No.1
AC. No.2
N 12°00' W
W.15000
W.14000
W.13000
W.12000
W.11000
N.1000
N.2000
S.1000
S.2000
Fit to 2
Fit to 5
MINES 118-119 "C" #1