


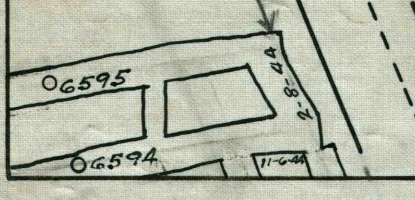

Fit to 2

LINCOLN



Fit to 1

MINES 118-119 'C' #3