


Fit to 2

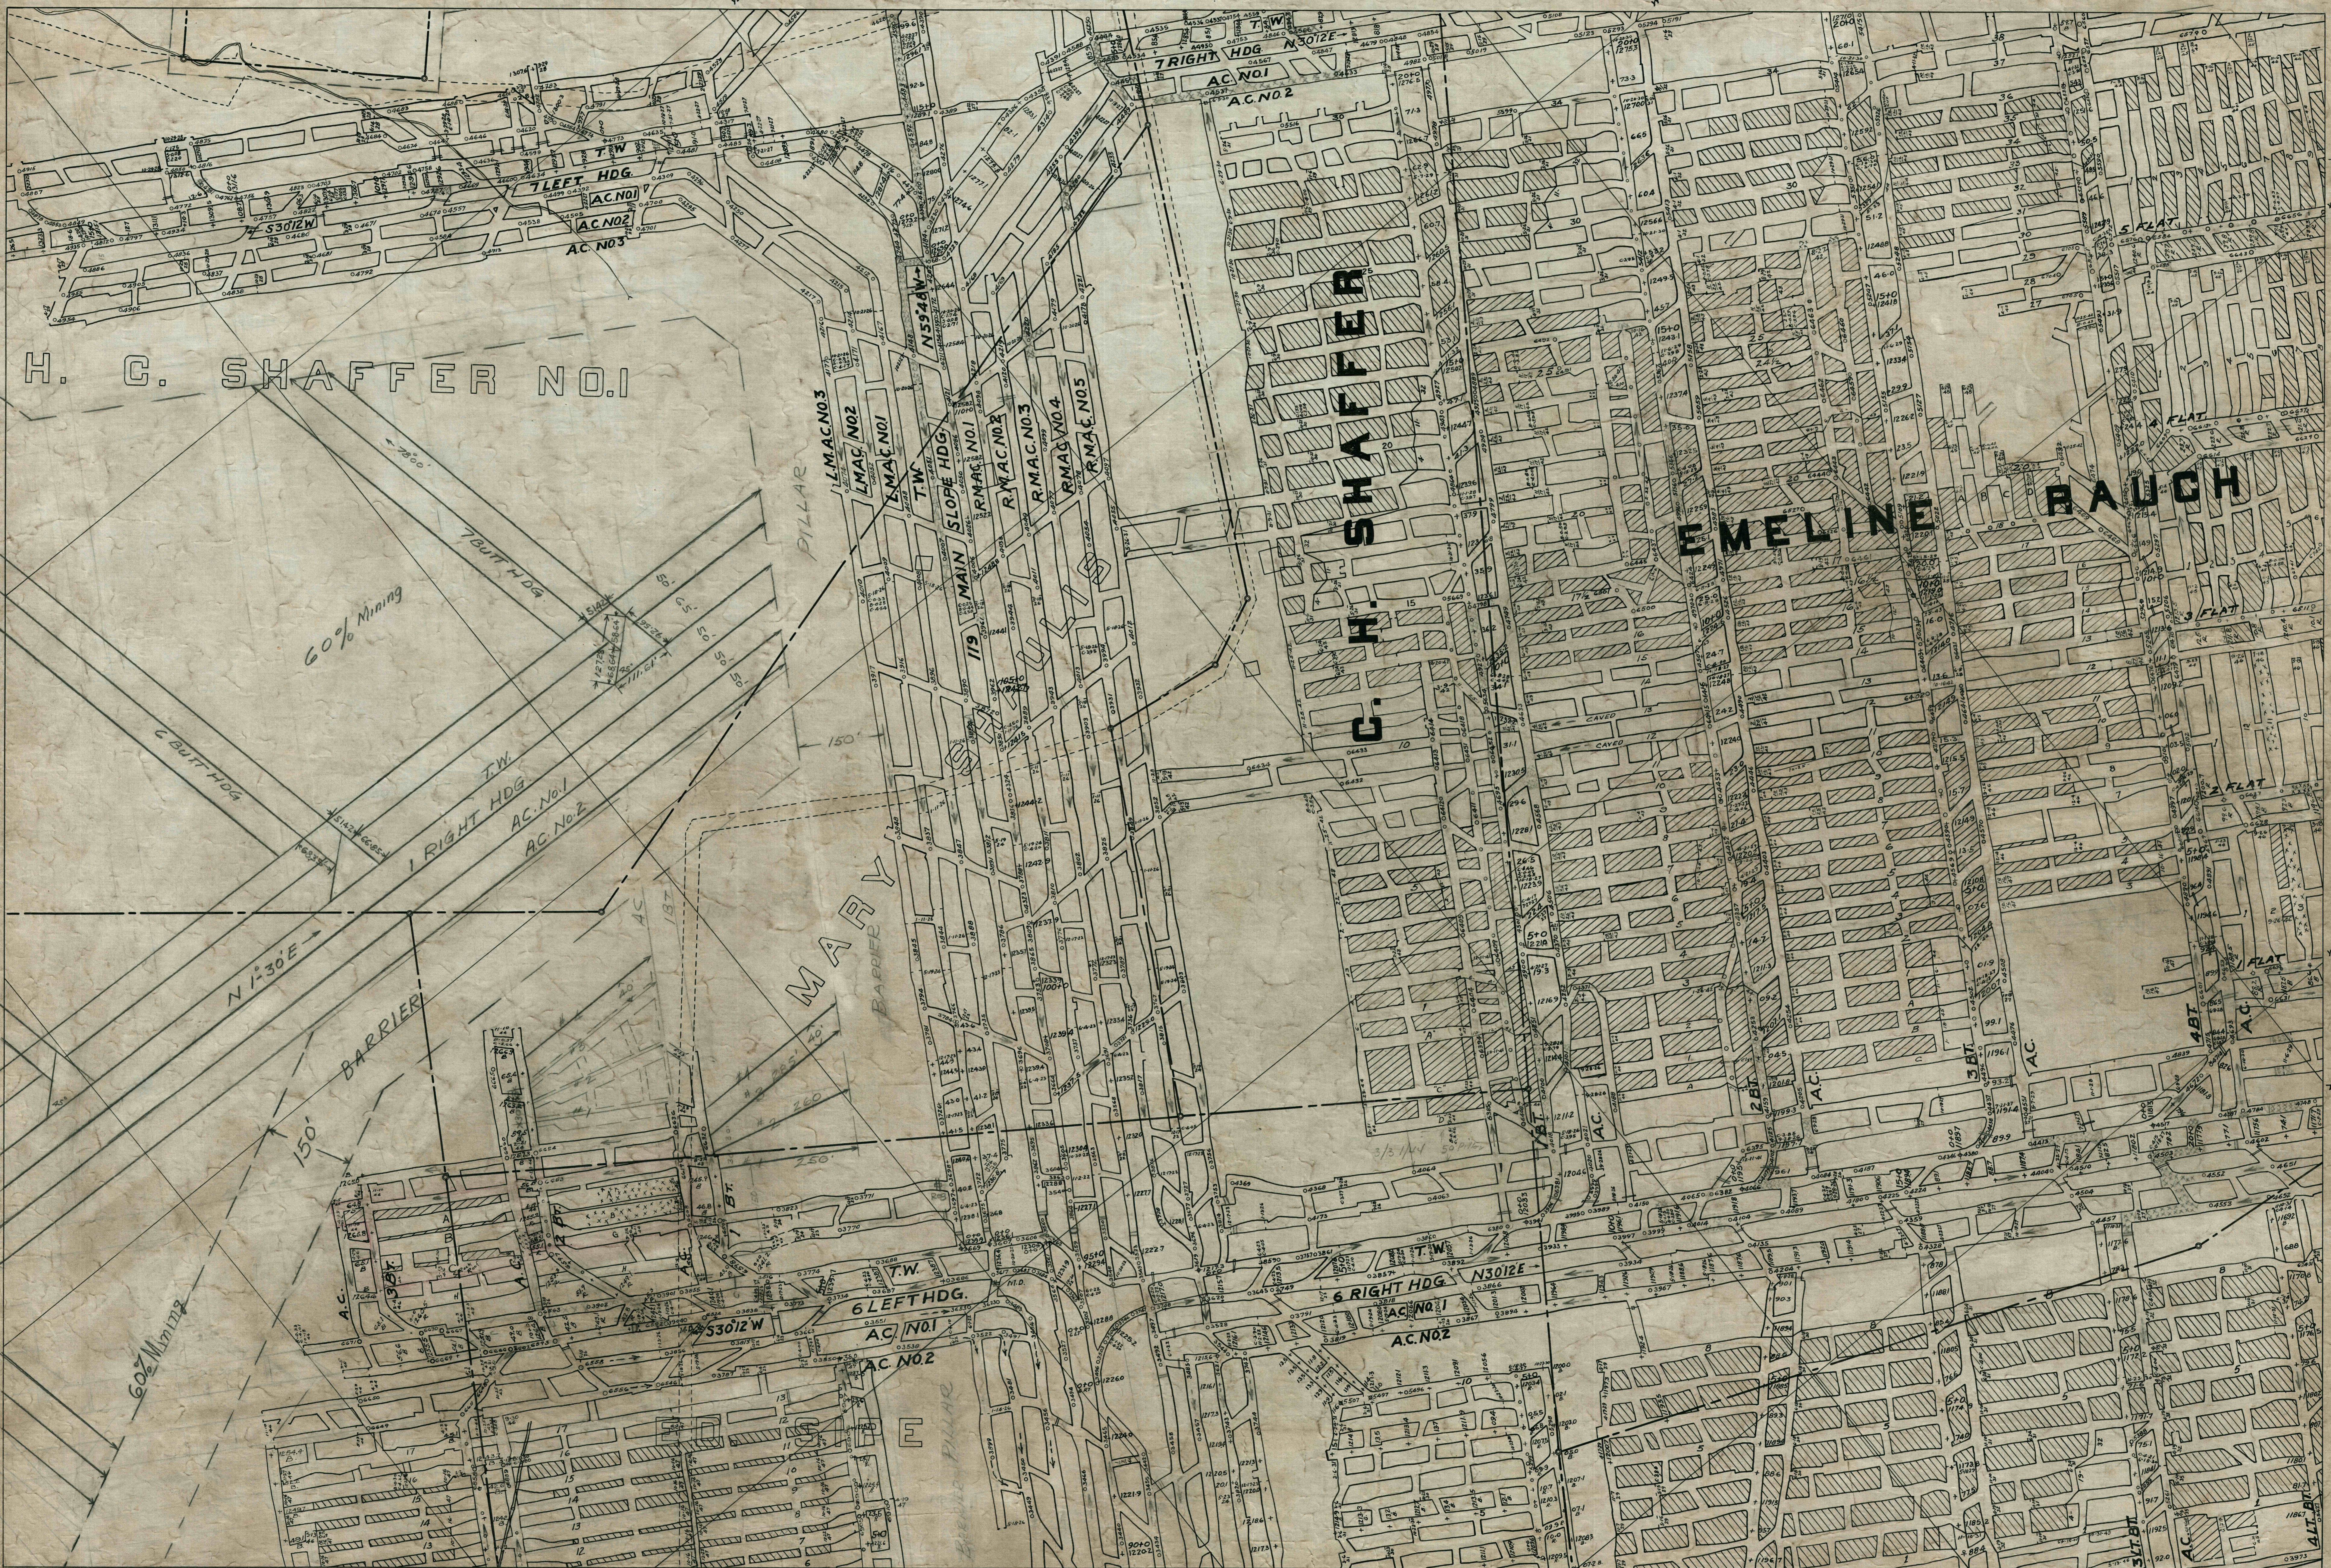

Fit to 5

Fit to 7

Fit to 10

MINES 118-119 "C" 6