

First Pump Hole - Peerless Surface Pump

Elev. Pump Base 1836  
 " Surface 1830  
 " Top of Coal 1699  
 Hole Depth 131  
 " Bottom Coal 1695  
 Pipe Depth 141


Pump will be 140'-3" from base to bot. of strainer

Note:  
 Pump Holes to be located  
 within radius of 150 feet  
 of Sugar tree marker  
 for Station 13007.

First Pump  
 Peerless, 12 M.A., 3 stage  
 950 GPM  
 45 HP Motor  
 12" Bowl dia.

Tract No. 145 - John Weighley  
 Norman Critchfield, Surface.

Profile for 10" Sewer Tile Drain  
 as staked 7-20-48.

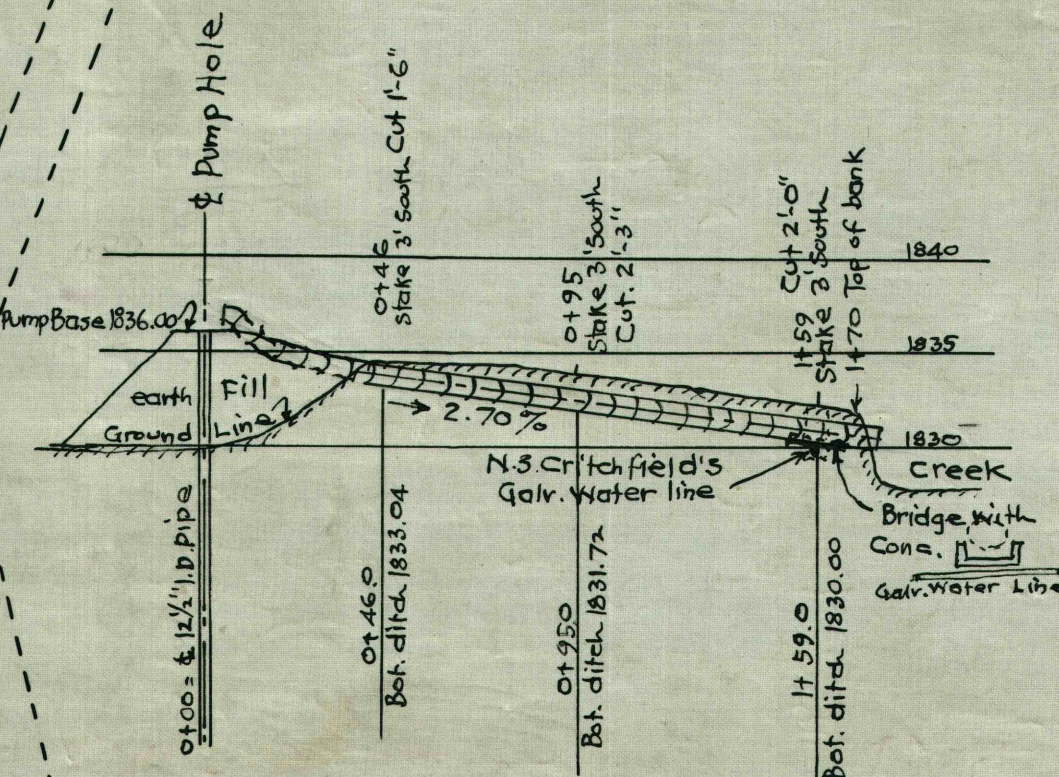

Pittsburgh Consolidation Coal Co.  
 Mine No. 119 - Jenners, Pa.  
**SURFACE TURBINE PUMP STATION**  
 OVER 18 DIP SUMP.  
 Scale 1"=100' 12-2-1946 Engr. Dept. Acosta, Pa.  
 7-20-48

Survey Vol. 1373.

1-J-57

