


532-D-1

1-G-232H

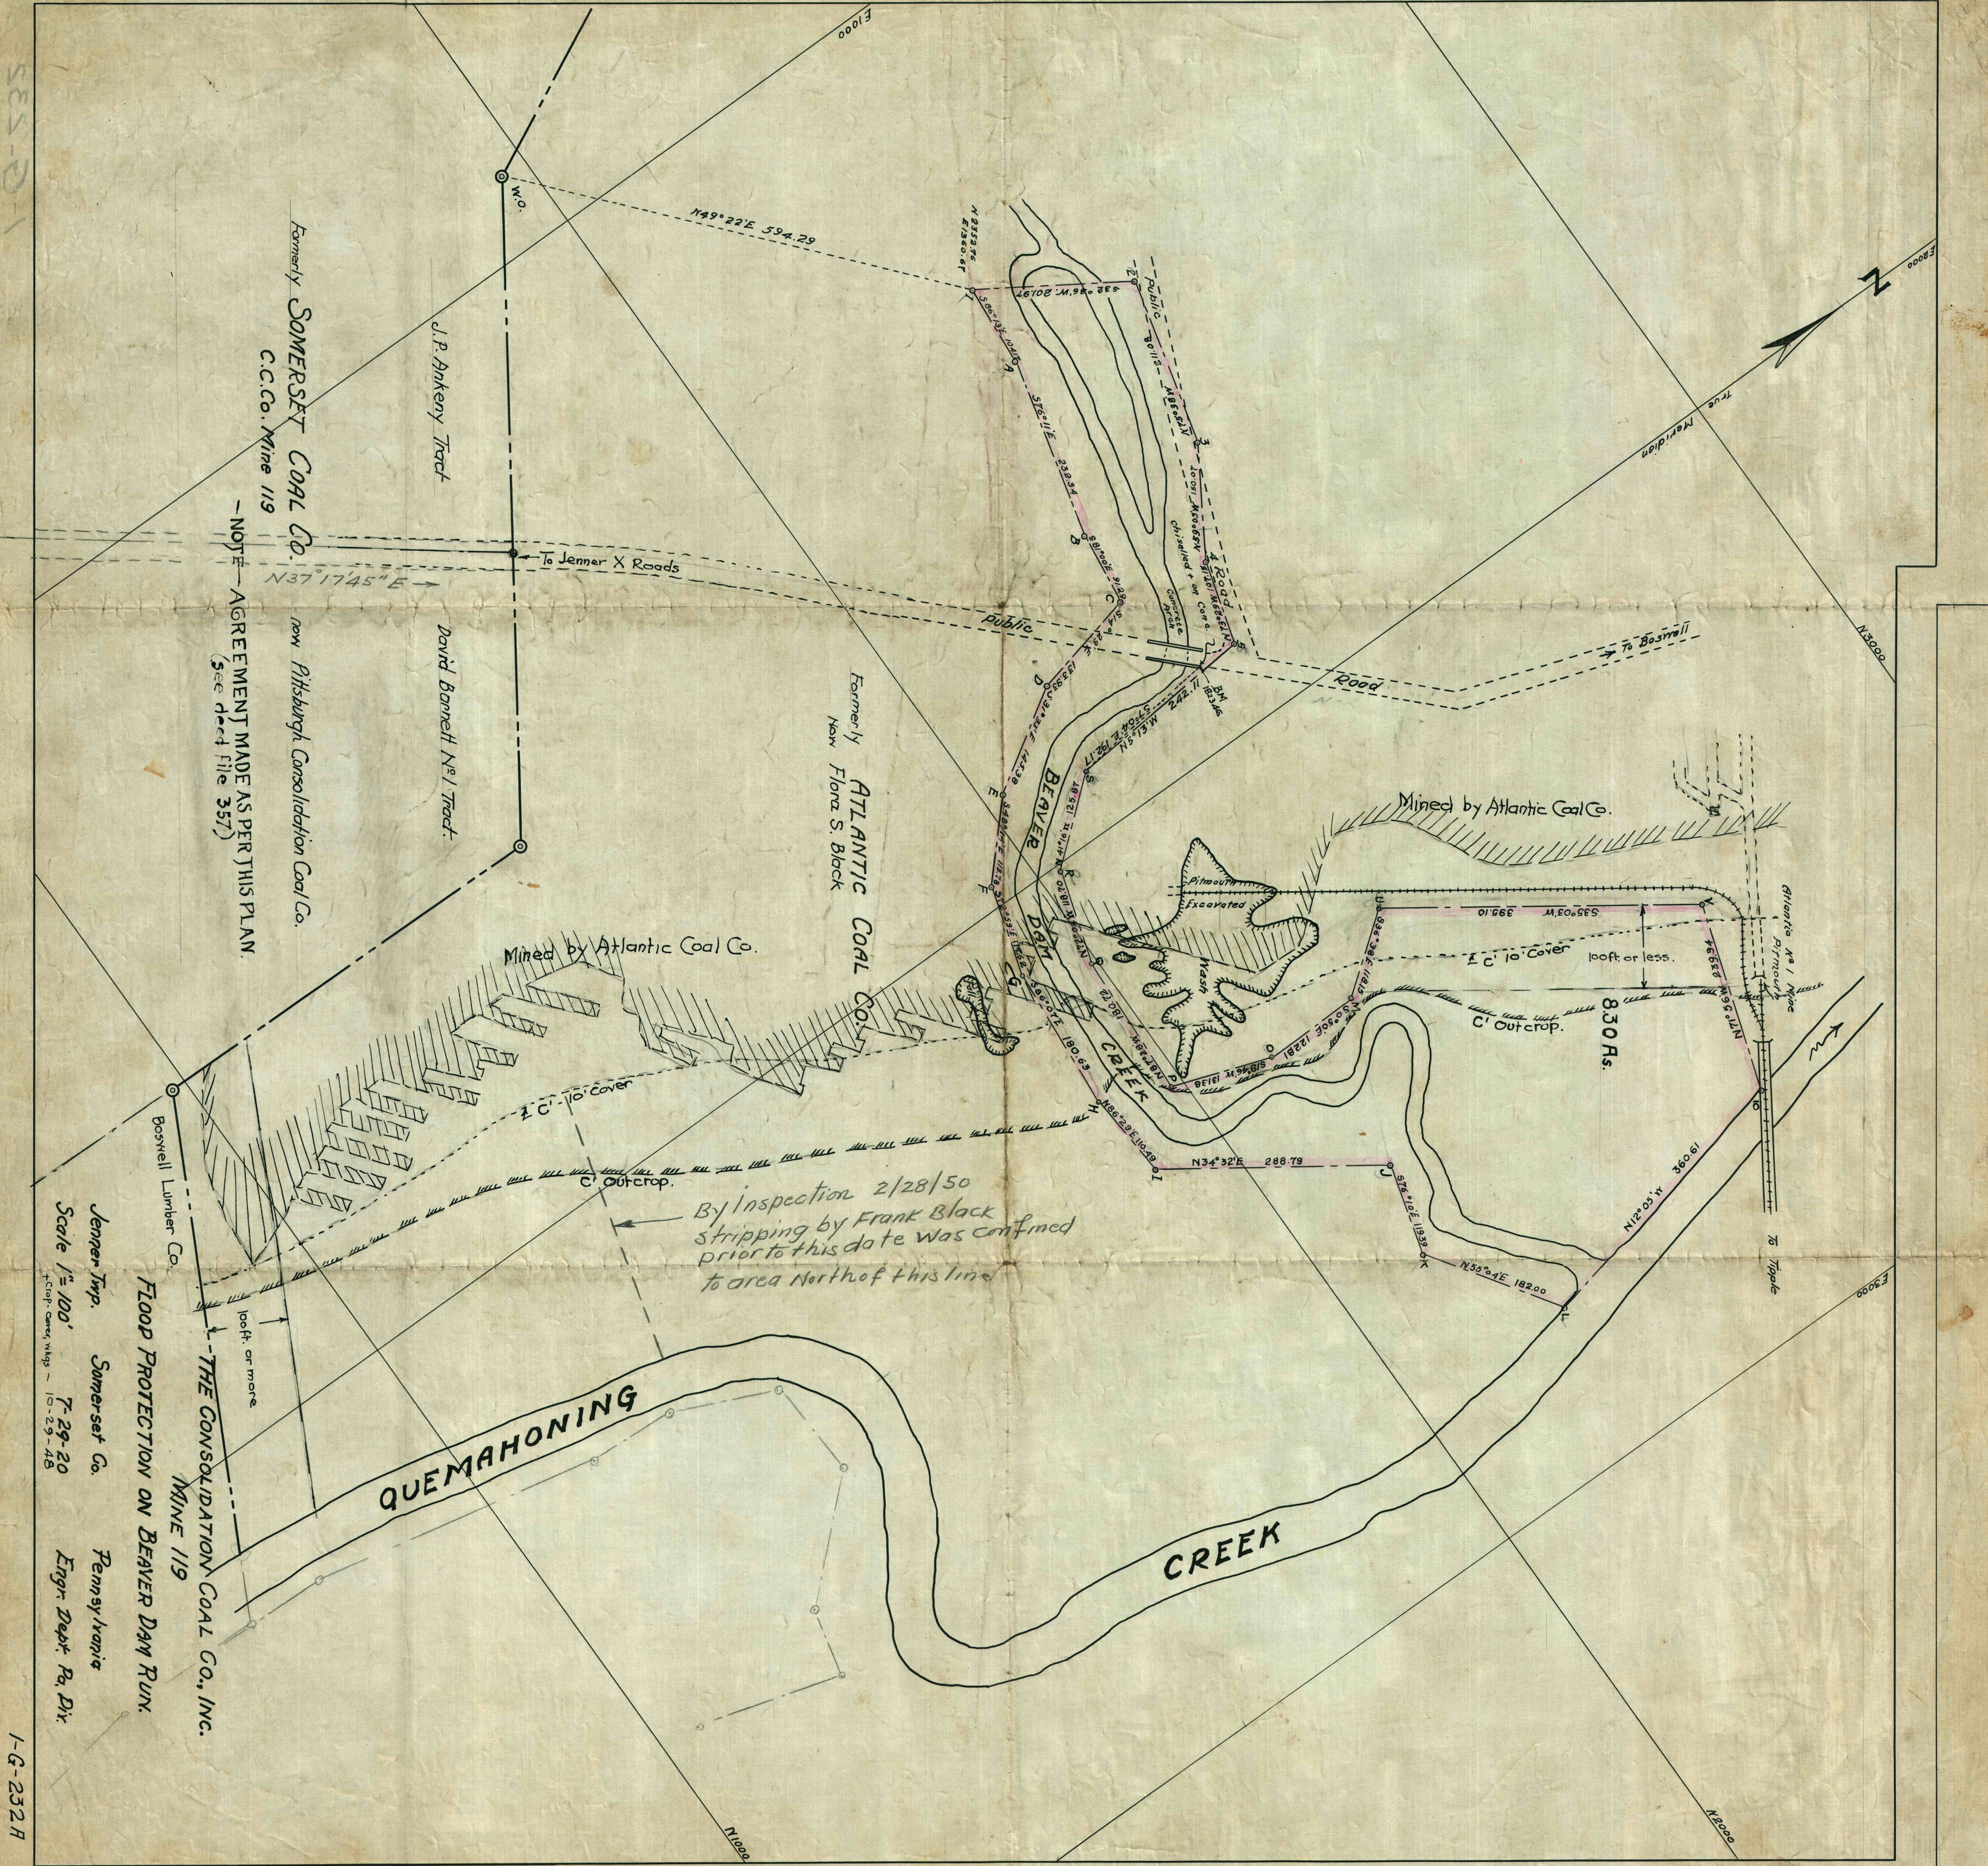

Formerly **SOMERSET COAL CO.**
 C.C. Co. Mine 119
 - NOTE - AGREEMENT MADE AS PER THIS PLAN.
 (See deed file 357)
 now **Pittsburgh Consolidation Coal Co.**

Formerly **ATLANTIC COAL CO.**
 Now **Flora S. Black**

By inspection 2/28/50
 stripping by Frank Black
 prior to this date was confined
 to area North of this line

QUEMAHONING CREEK

FLOOD PROTECTION ON BEAVER DAM RUN
 MINE 119
THE CONSOLIDATION COAL CO., INC.

Jenner Twp. Somerset Co. Pennsylvania
 Scale 1" = 100'
 T-29-20
 Engr. Dept. Pa. Div.

1-G-232H