

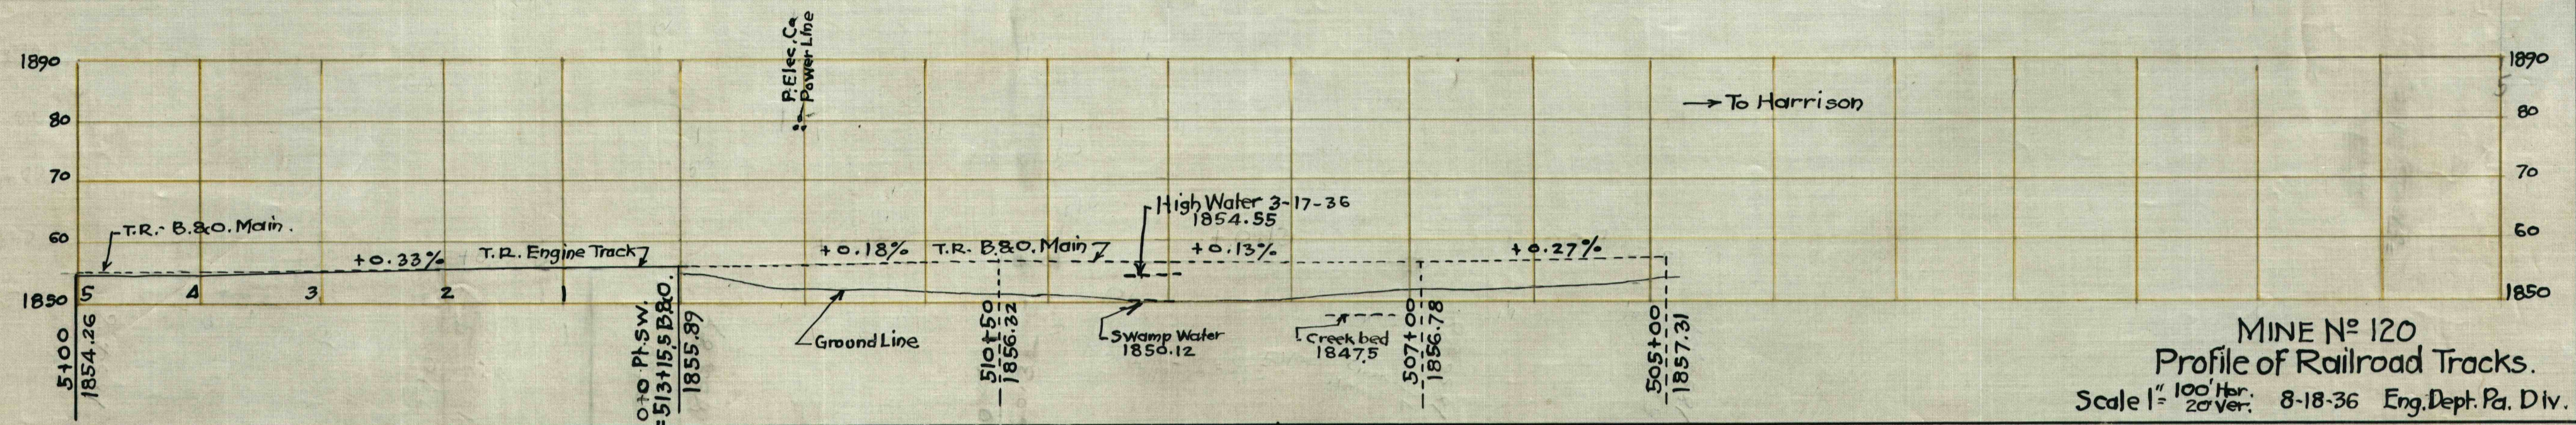


Mine 120

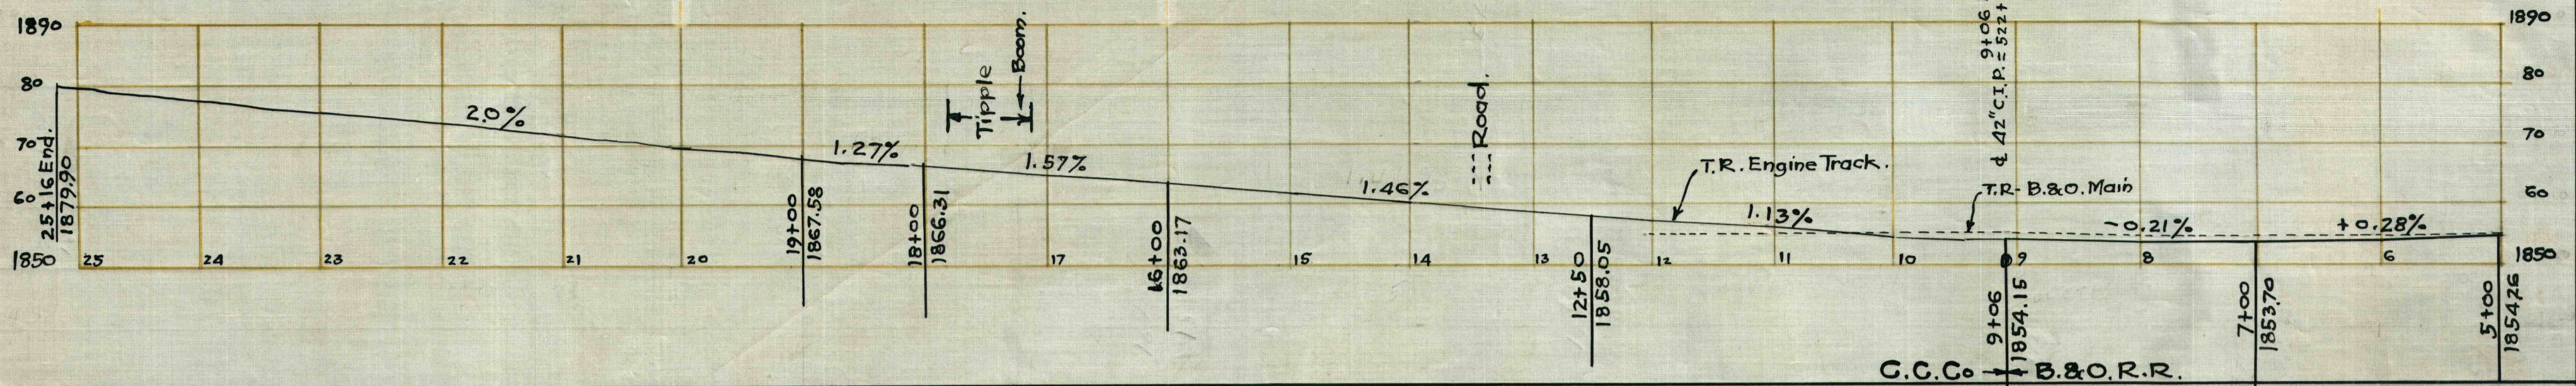

MINE No 120  
Profile of Railroad Tracks.  
Scale 1" = 100' Hor. 20' Ver. 8-18-36 Eng. Dept. Pa. Div.

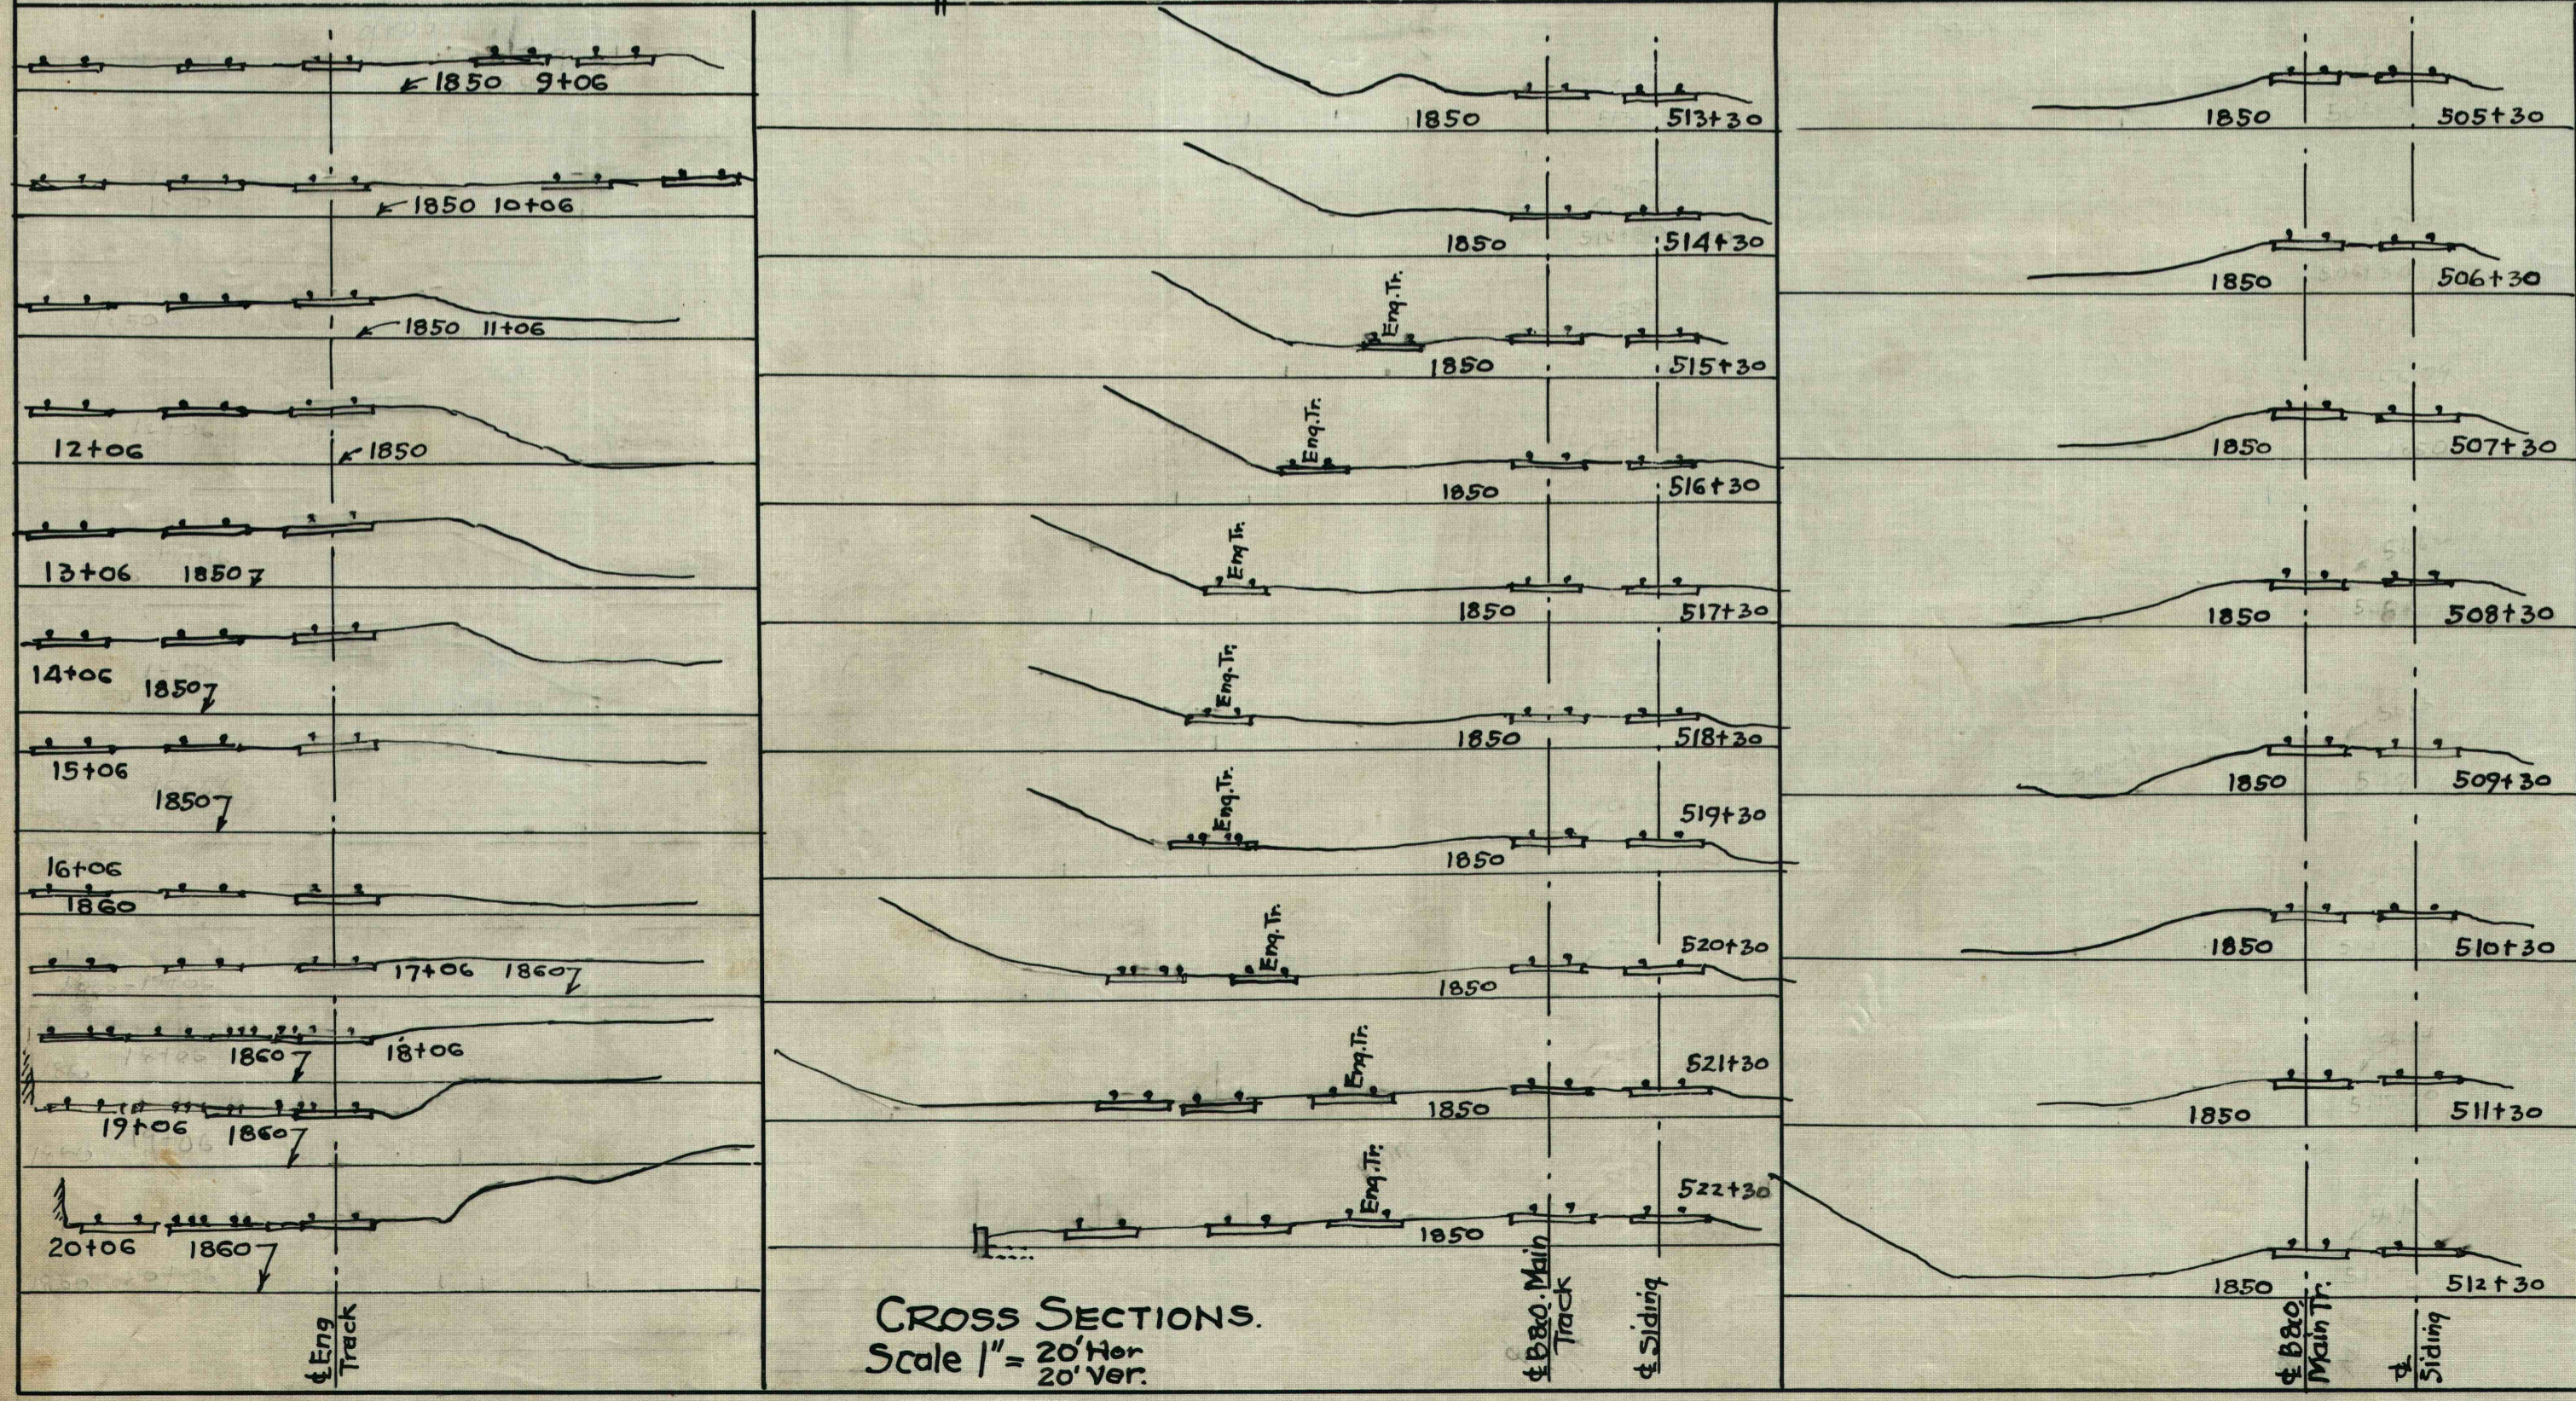

CROSS SECTIONS.  
Scale 1" = 20' Hor. 20' Ver.

Consolidation Coal Co.  
Mines 120-121 - Acosta, Pa.  
**RAILROAD PROFILE & SECTIONS.**  
Scale as noted 8-18-36 Engr. Dept. Pa. Div  
Levels - Vol. 826 p. 22-26  
1-J-30