


A.J. ANKENY

Fit to 5

JOHN KLINE

W. 121

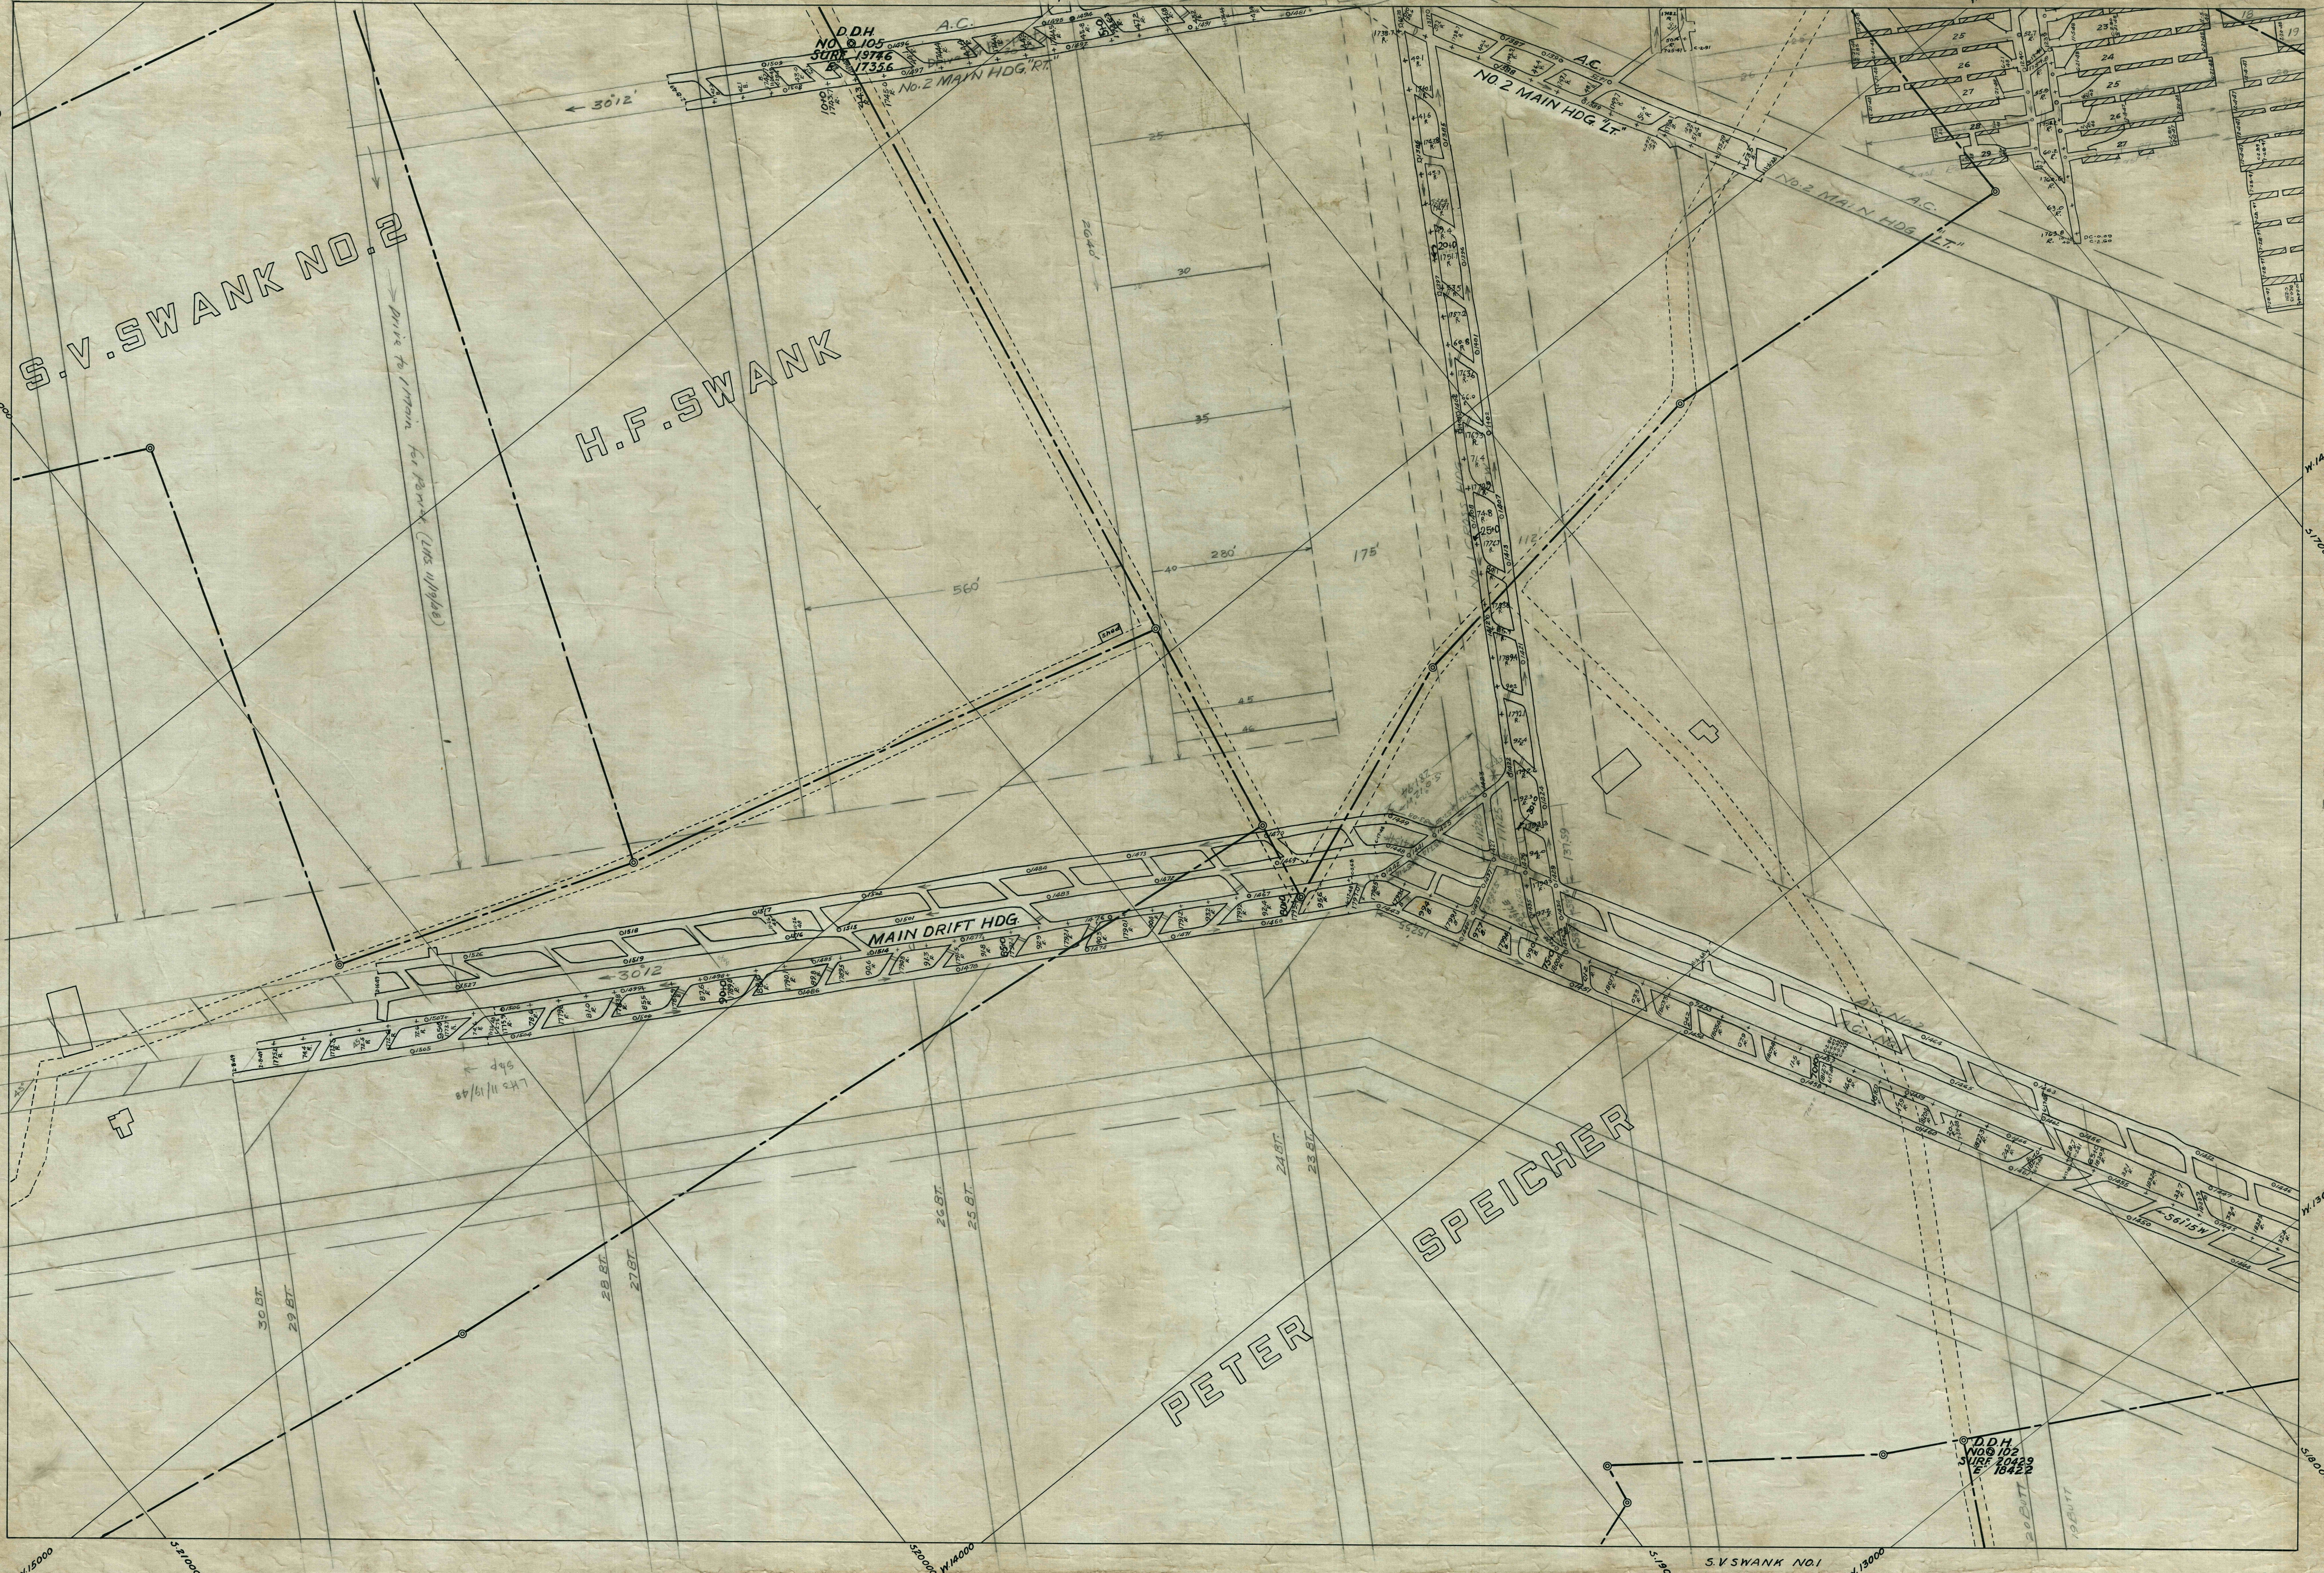

Fit to 3

Fit to 12

PETER

SPEICHER

MINE 121 E #6

Fit to 7

S.V. SWANK NO. 1