


Fit to #17

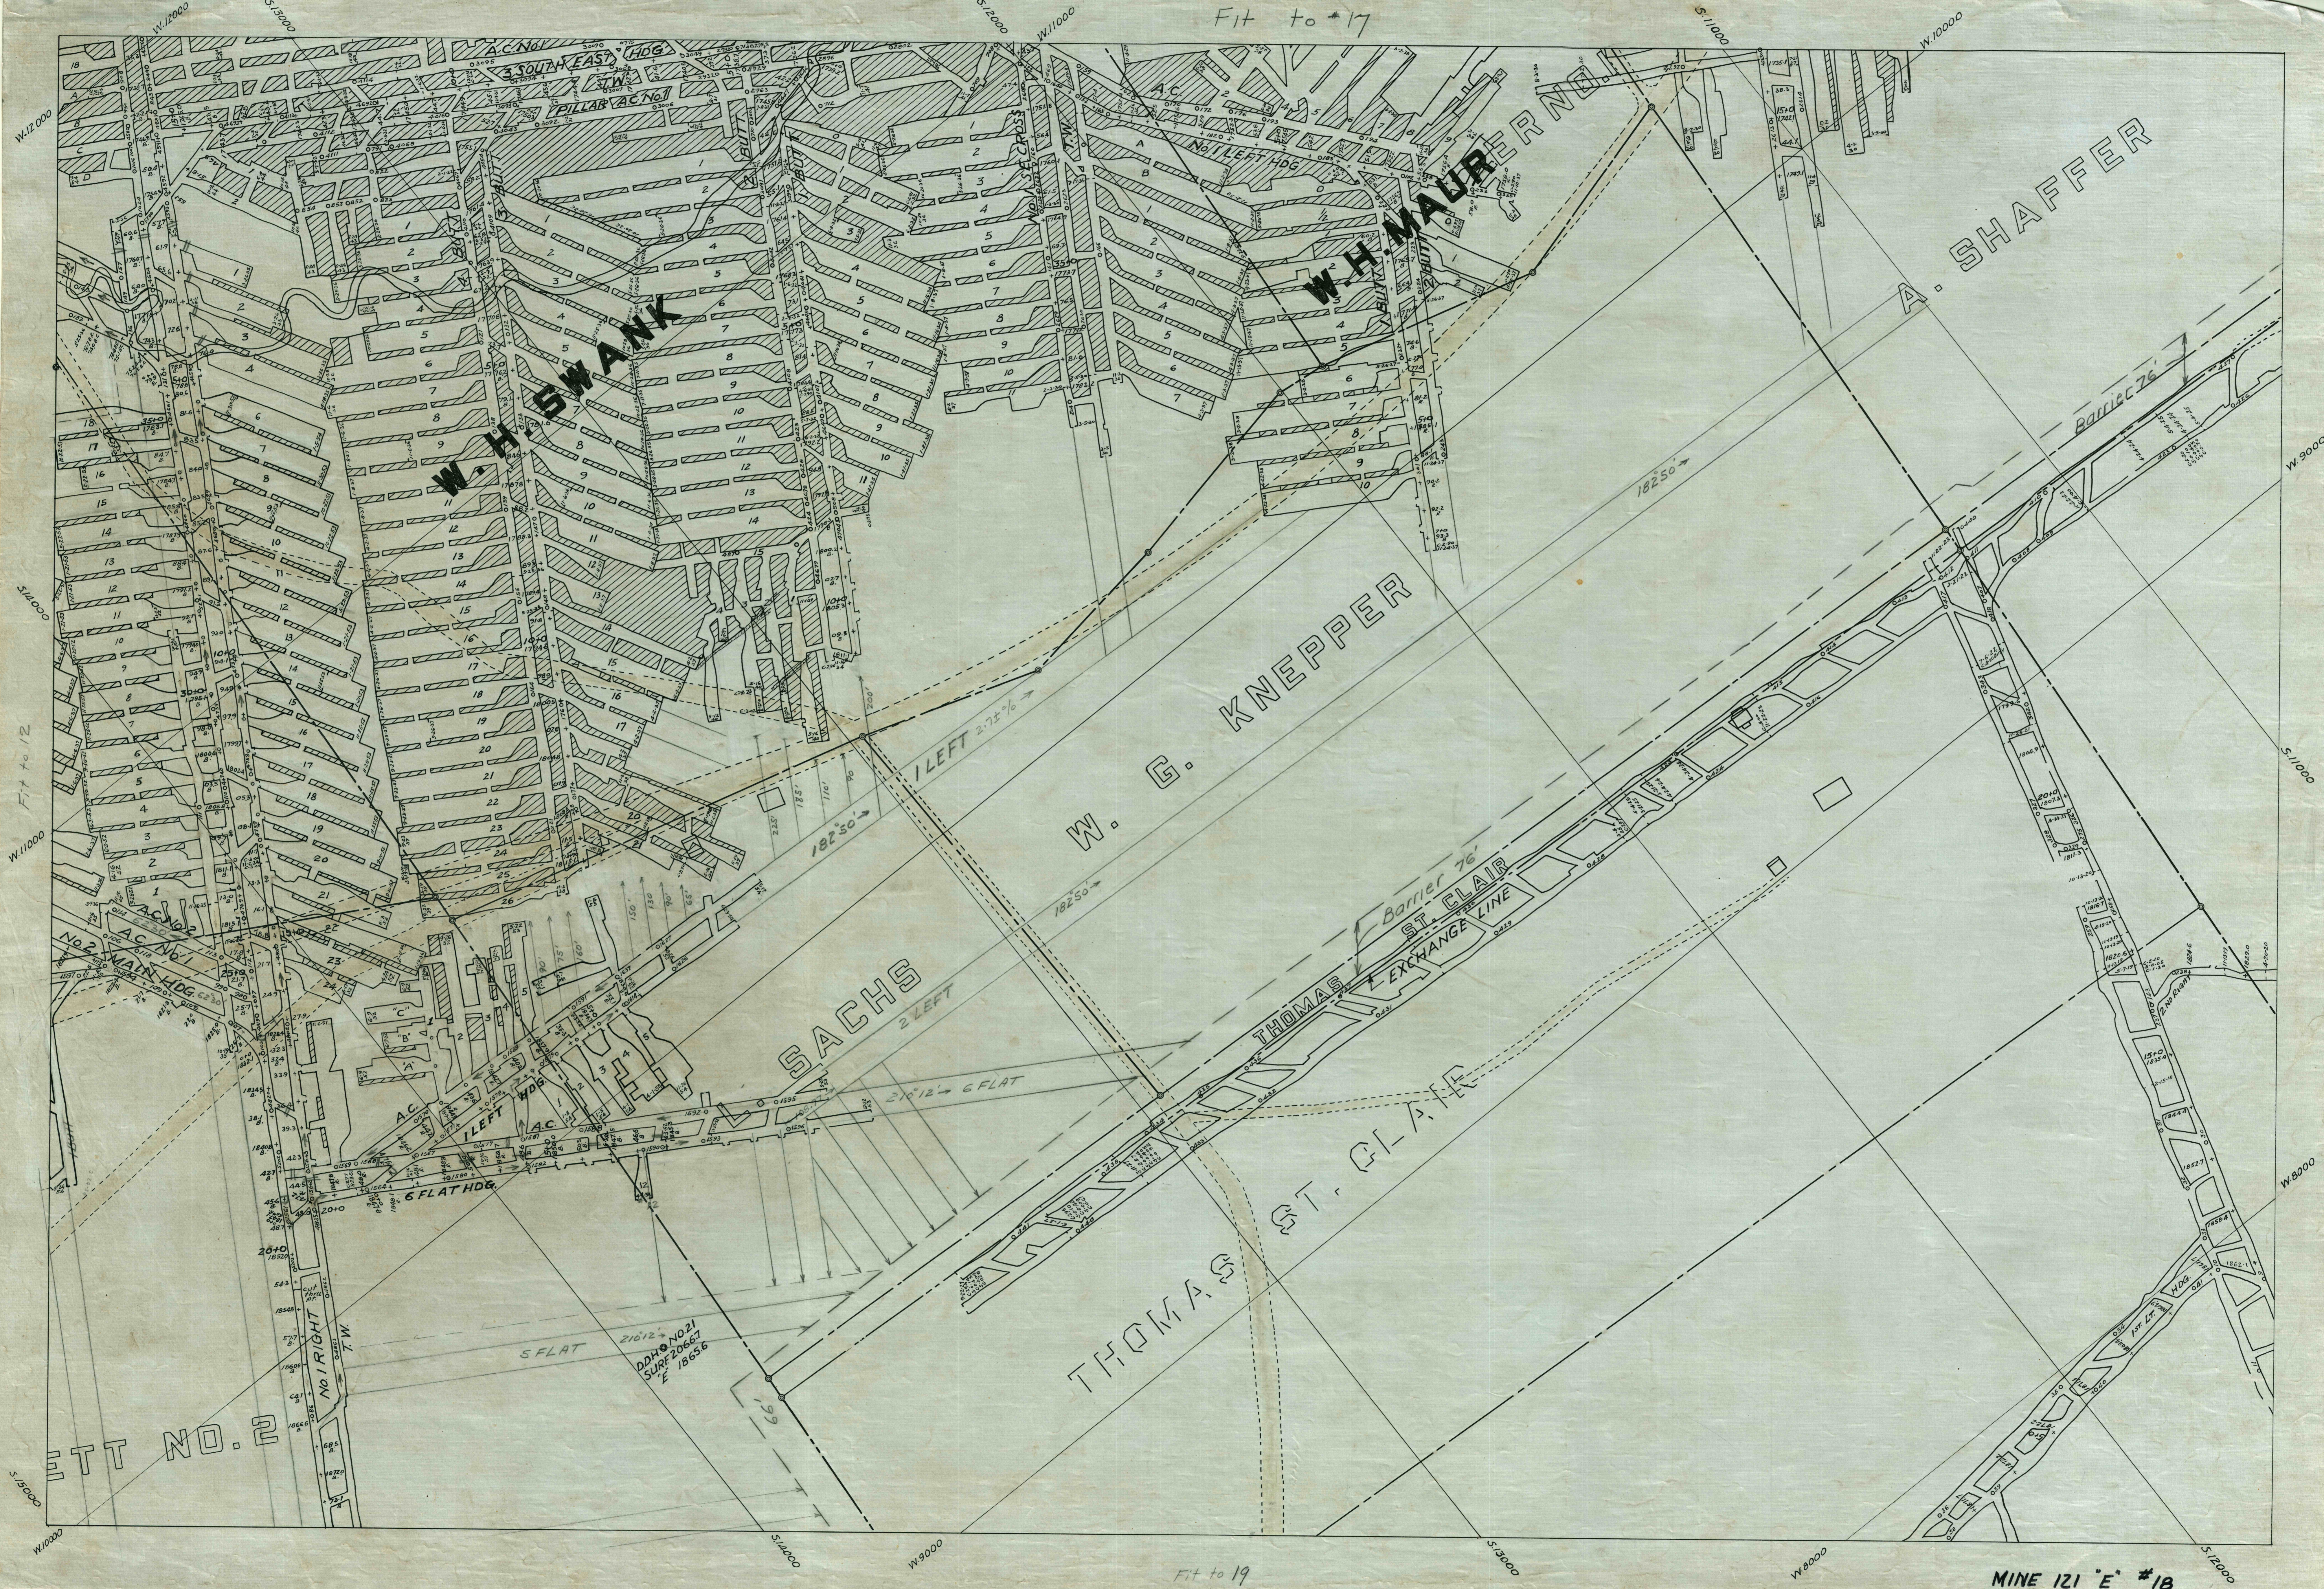

MINE 121 'E' #18