

I. PAUL

J. M. COVER

I. KIMMEL


J. I. ANKENY

BEAM ESTATE

J. A. FREDLINE

Sold to DB Zimmerman
E. HEIPLE No. 1

* Special Samples
Taken April 1930.

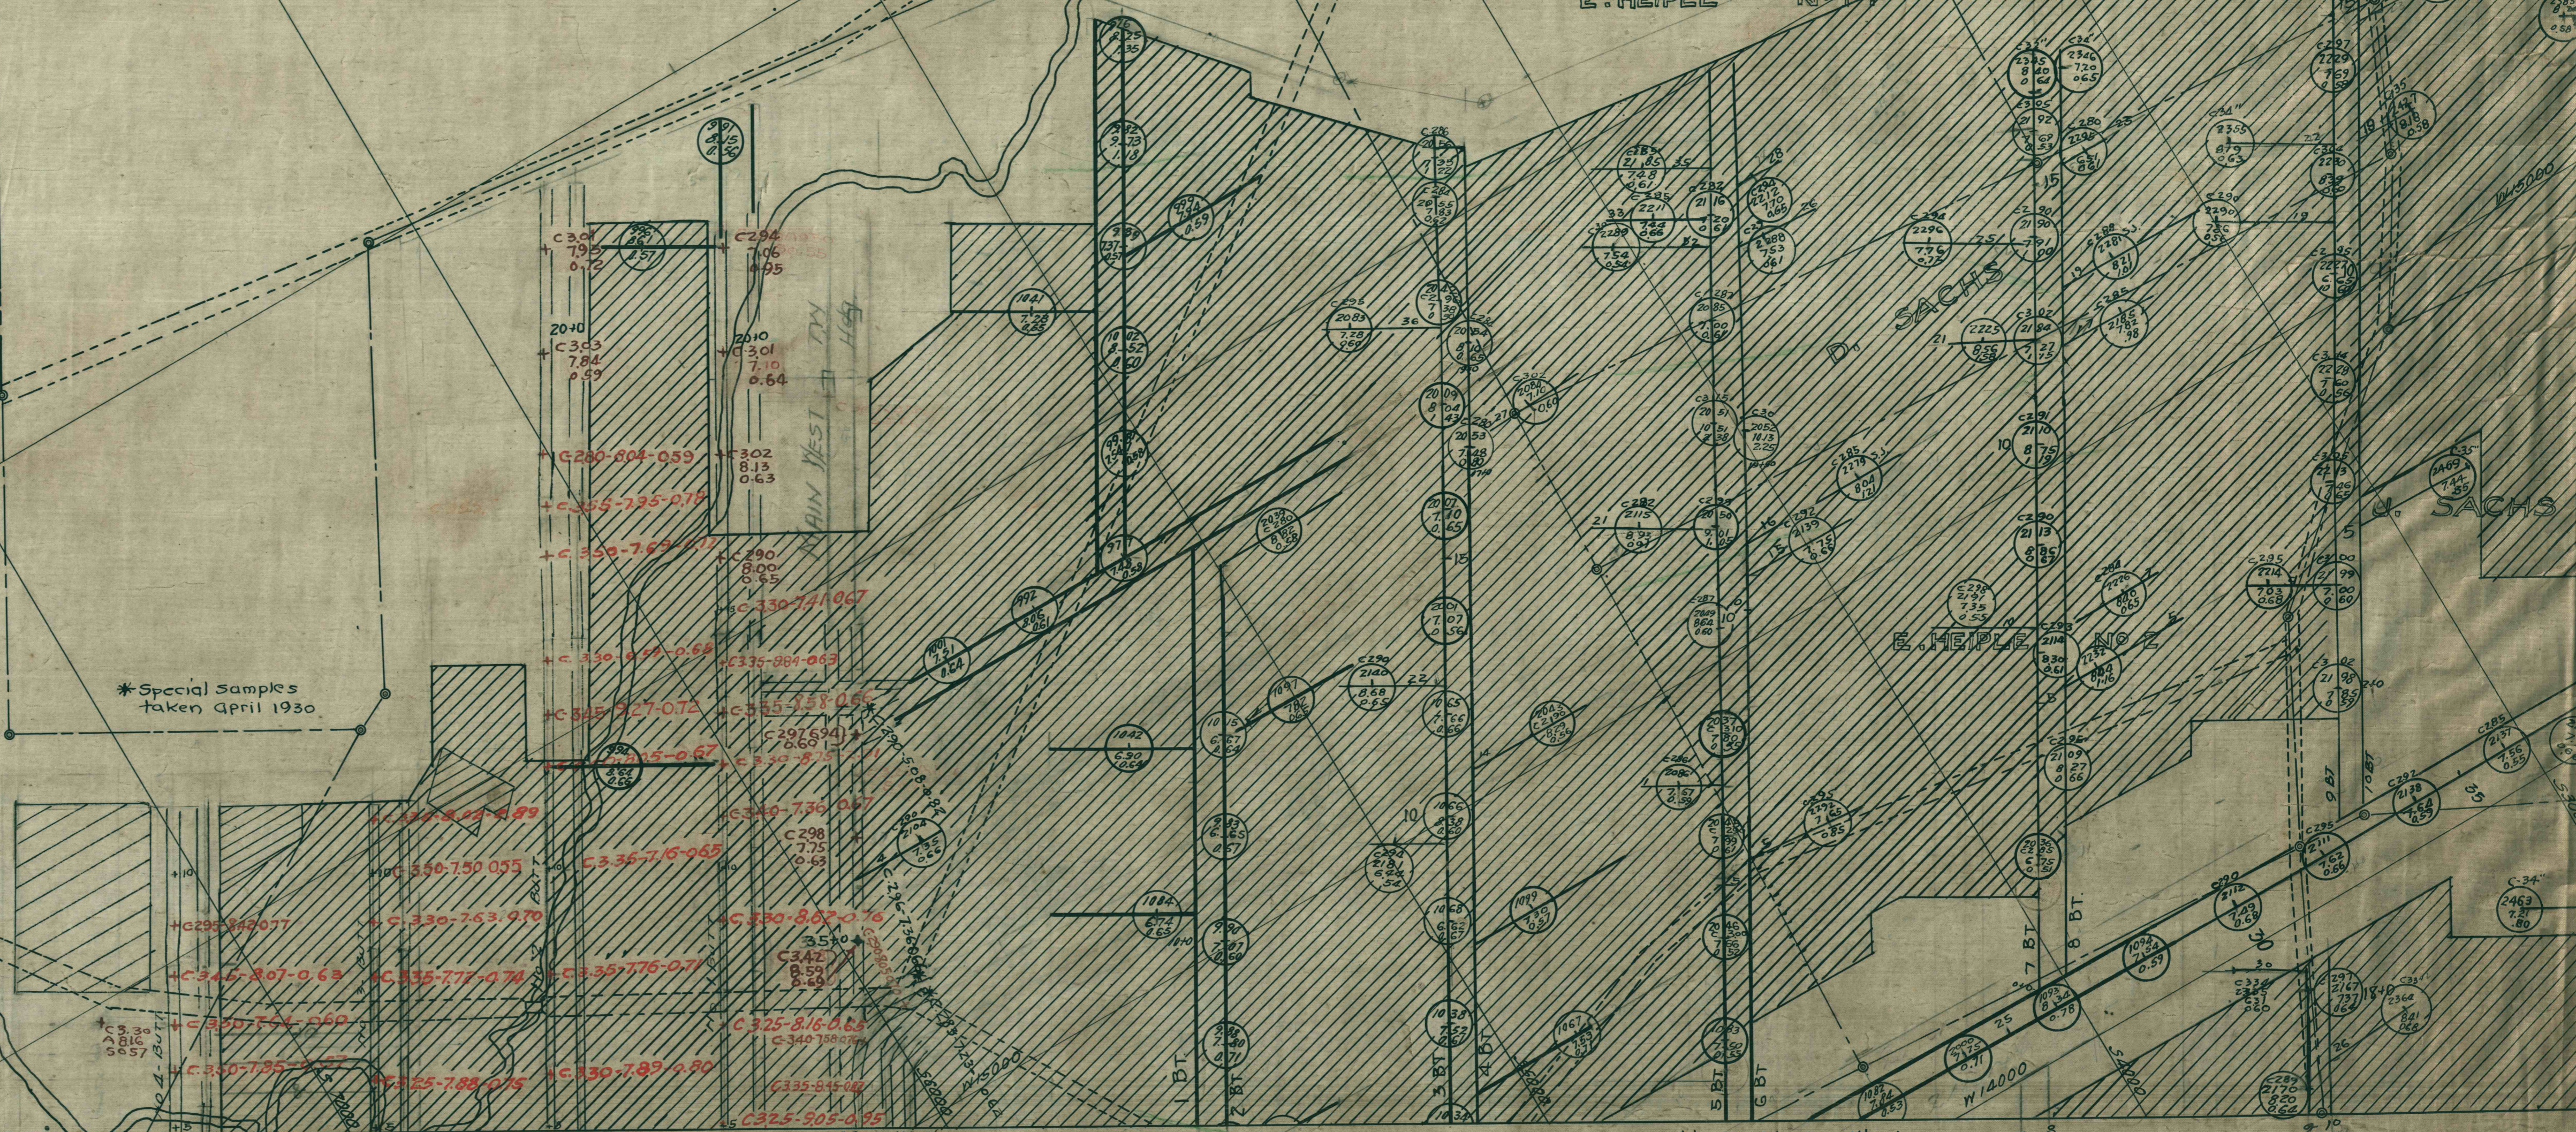

No 2 South West
West Side Mine No 123

No 2 North West