


34 p. 150
30 p. 150

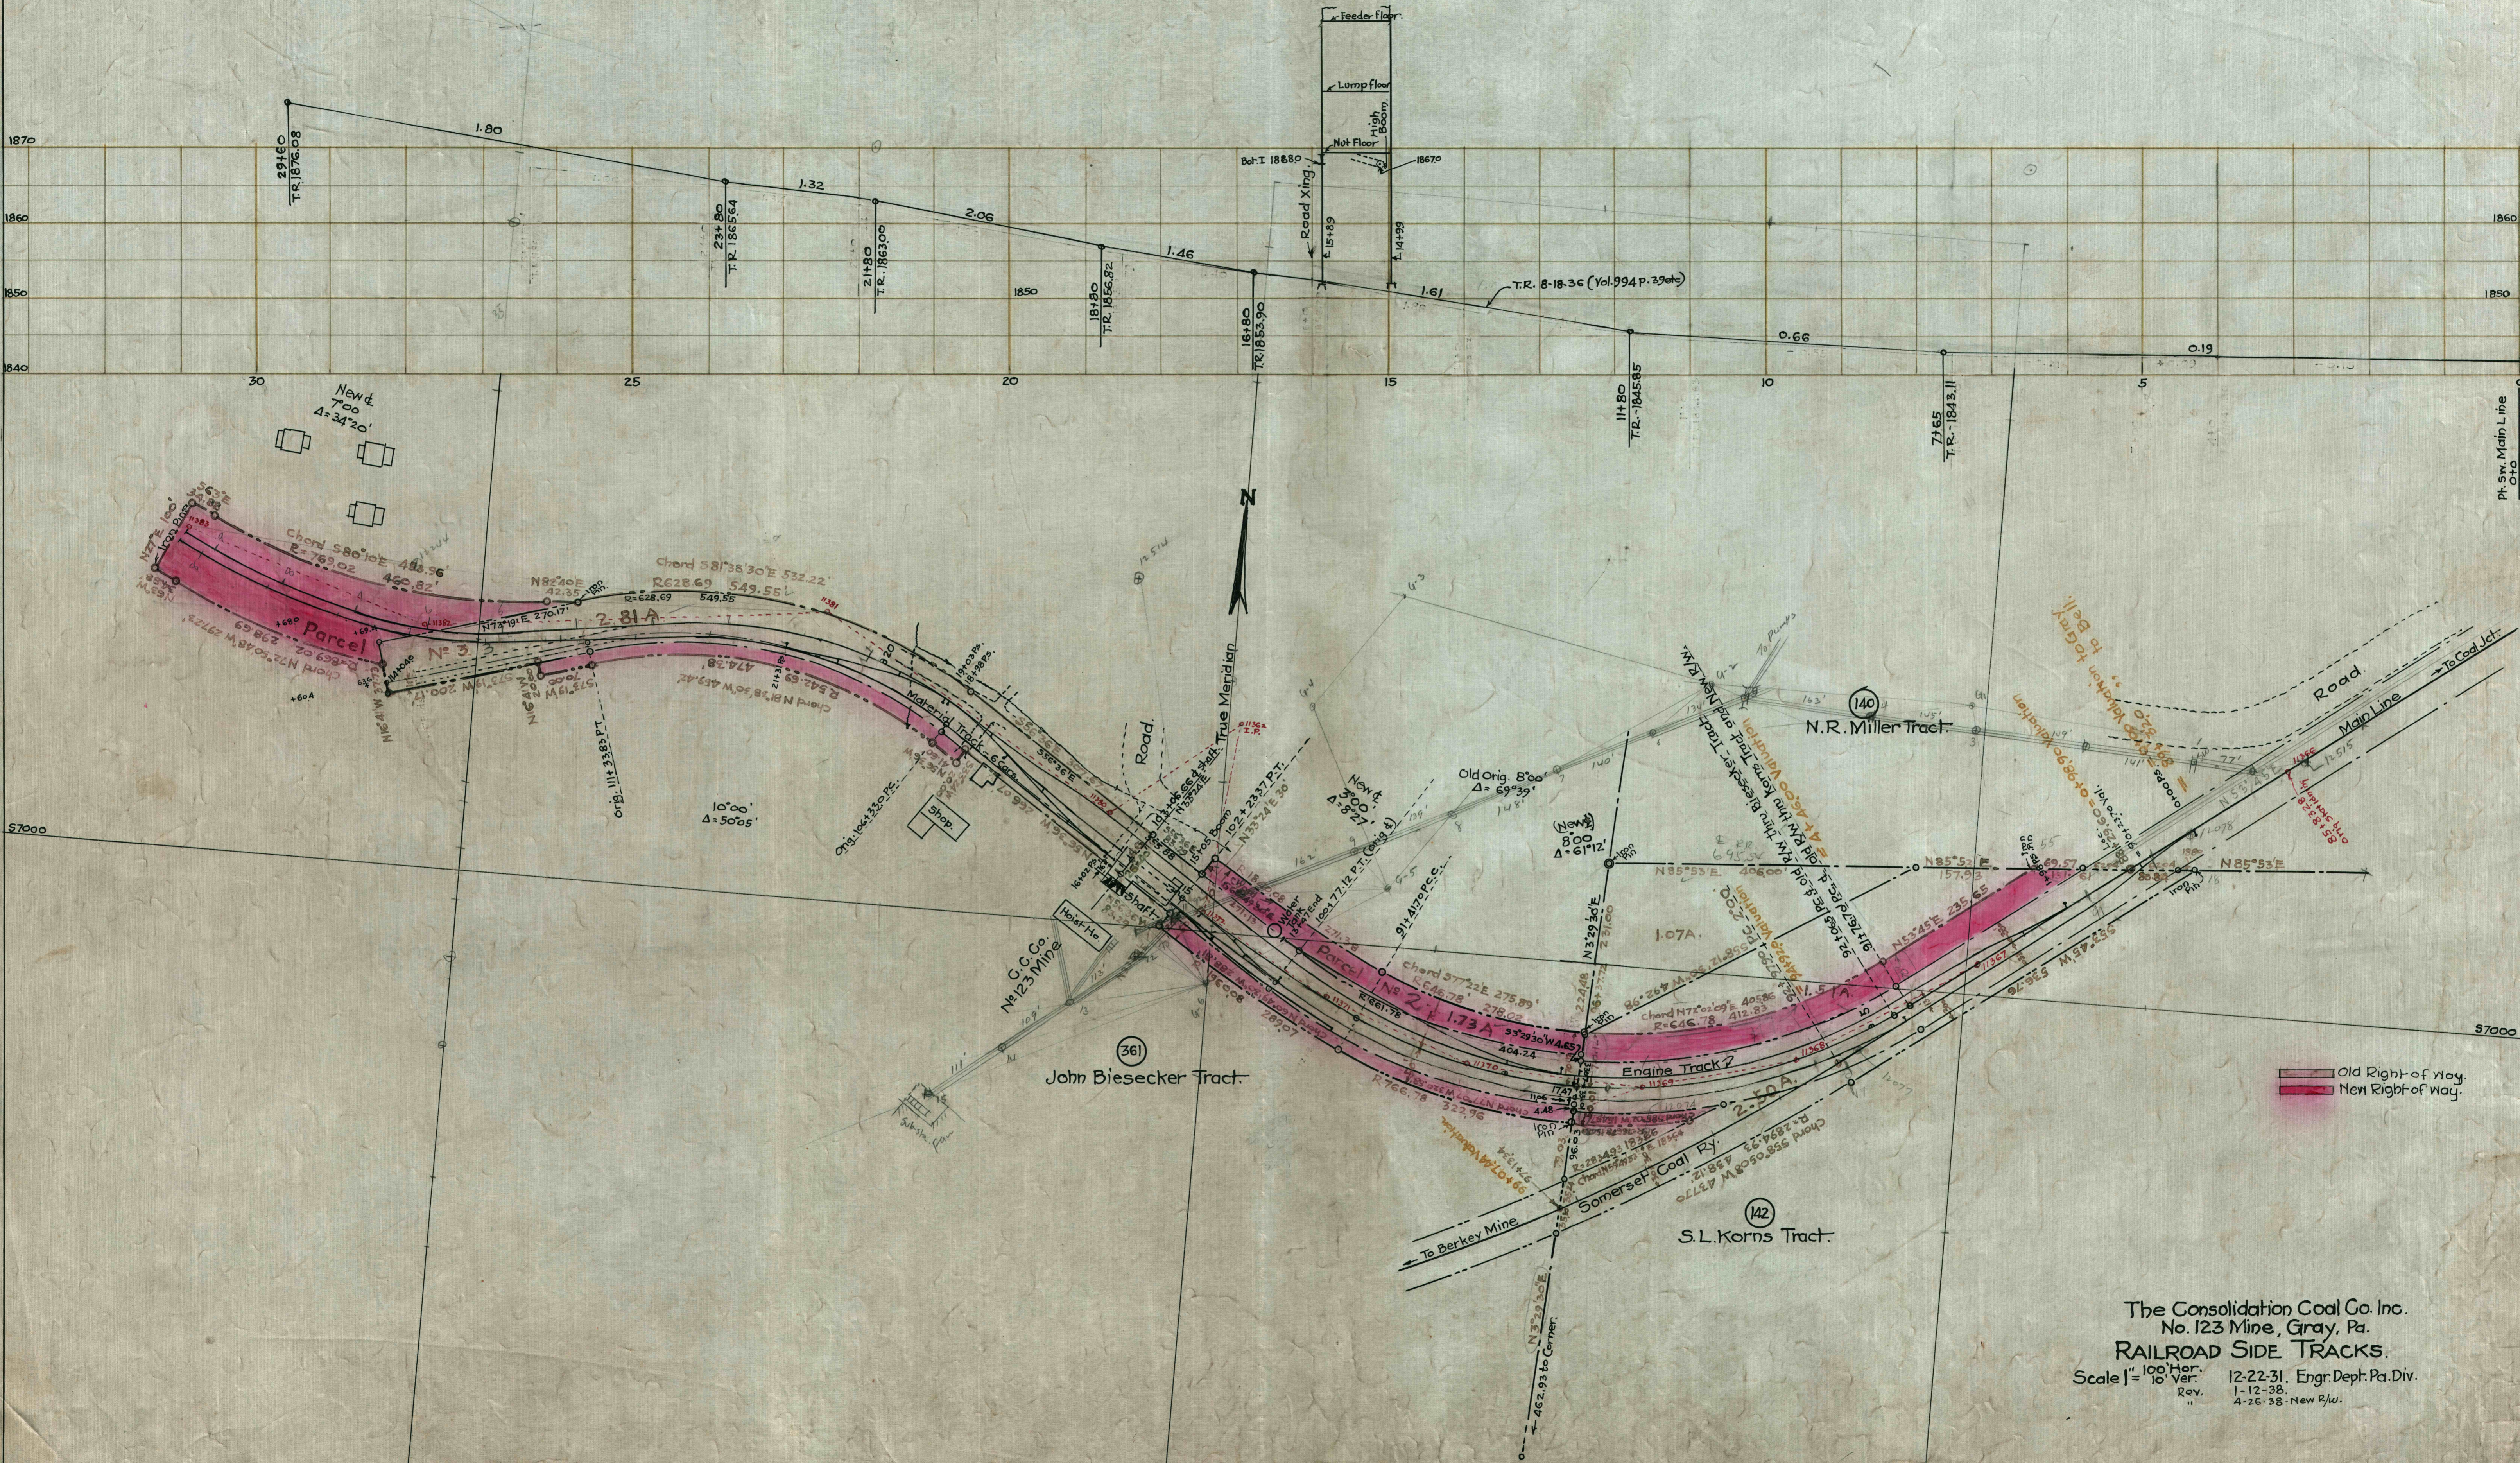

The Consolidation Coal Co. Inc.
 No. 123 Mine, Gray, Pa.
RAILROAD SIDE TRACKS.
 Scale 1" = 100' Hor. 12-22-31, Engr. Dept. Pa. Div.
 Rev. 1-12-38.
 Rev. 4-26-38 - New R/W.

Note: See I-K-21 for 20' scale Topographic.
 Surveys, Vol. 1213 p. 59-67
 See Calc. Area sheets for Right of Way.