


Fit to 10

Fit to 12

Fit to 22

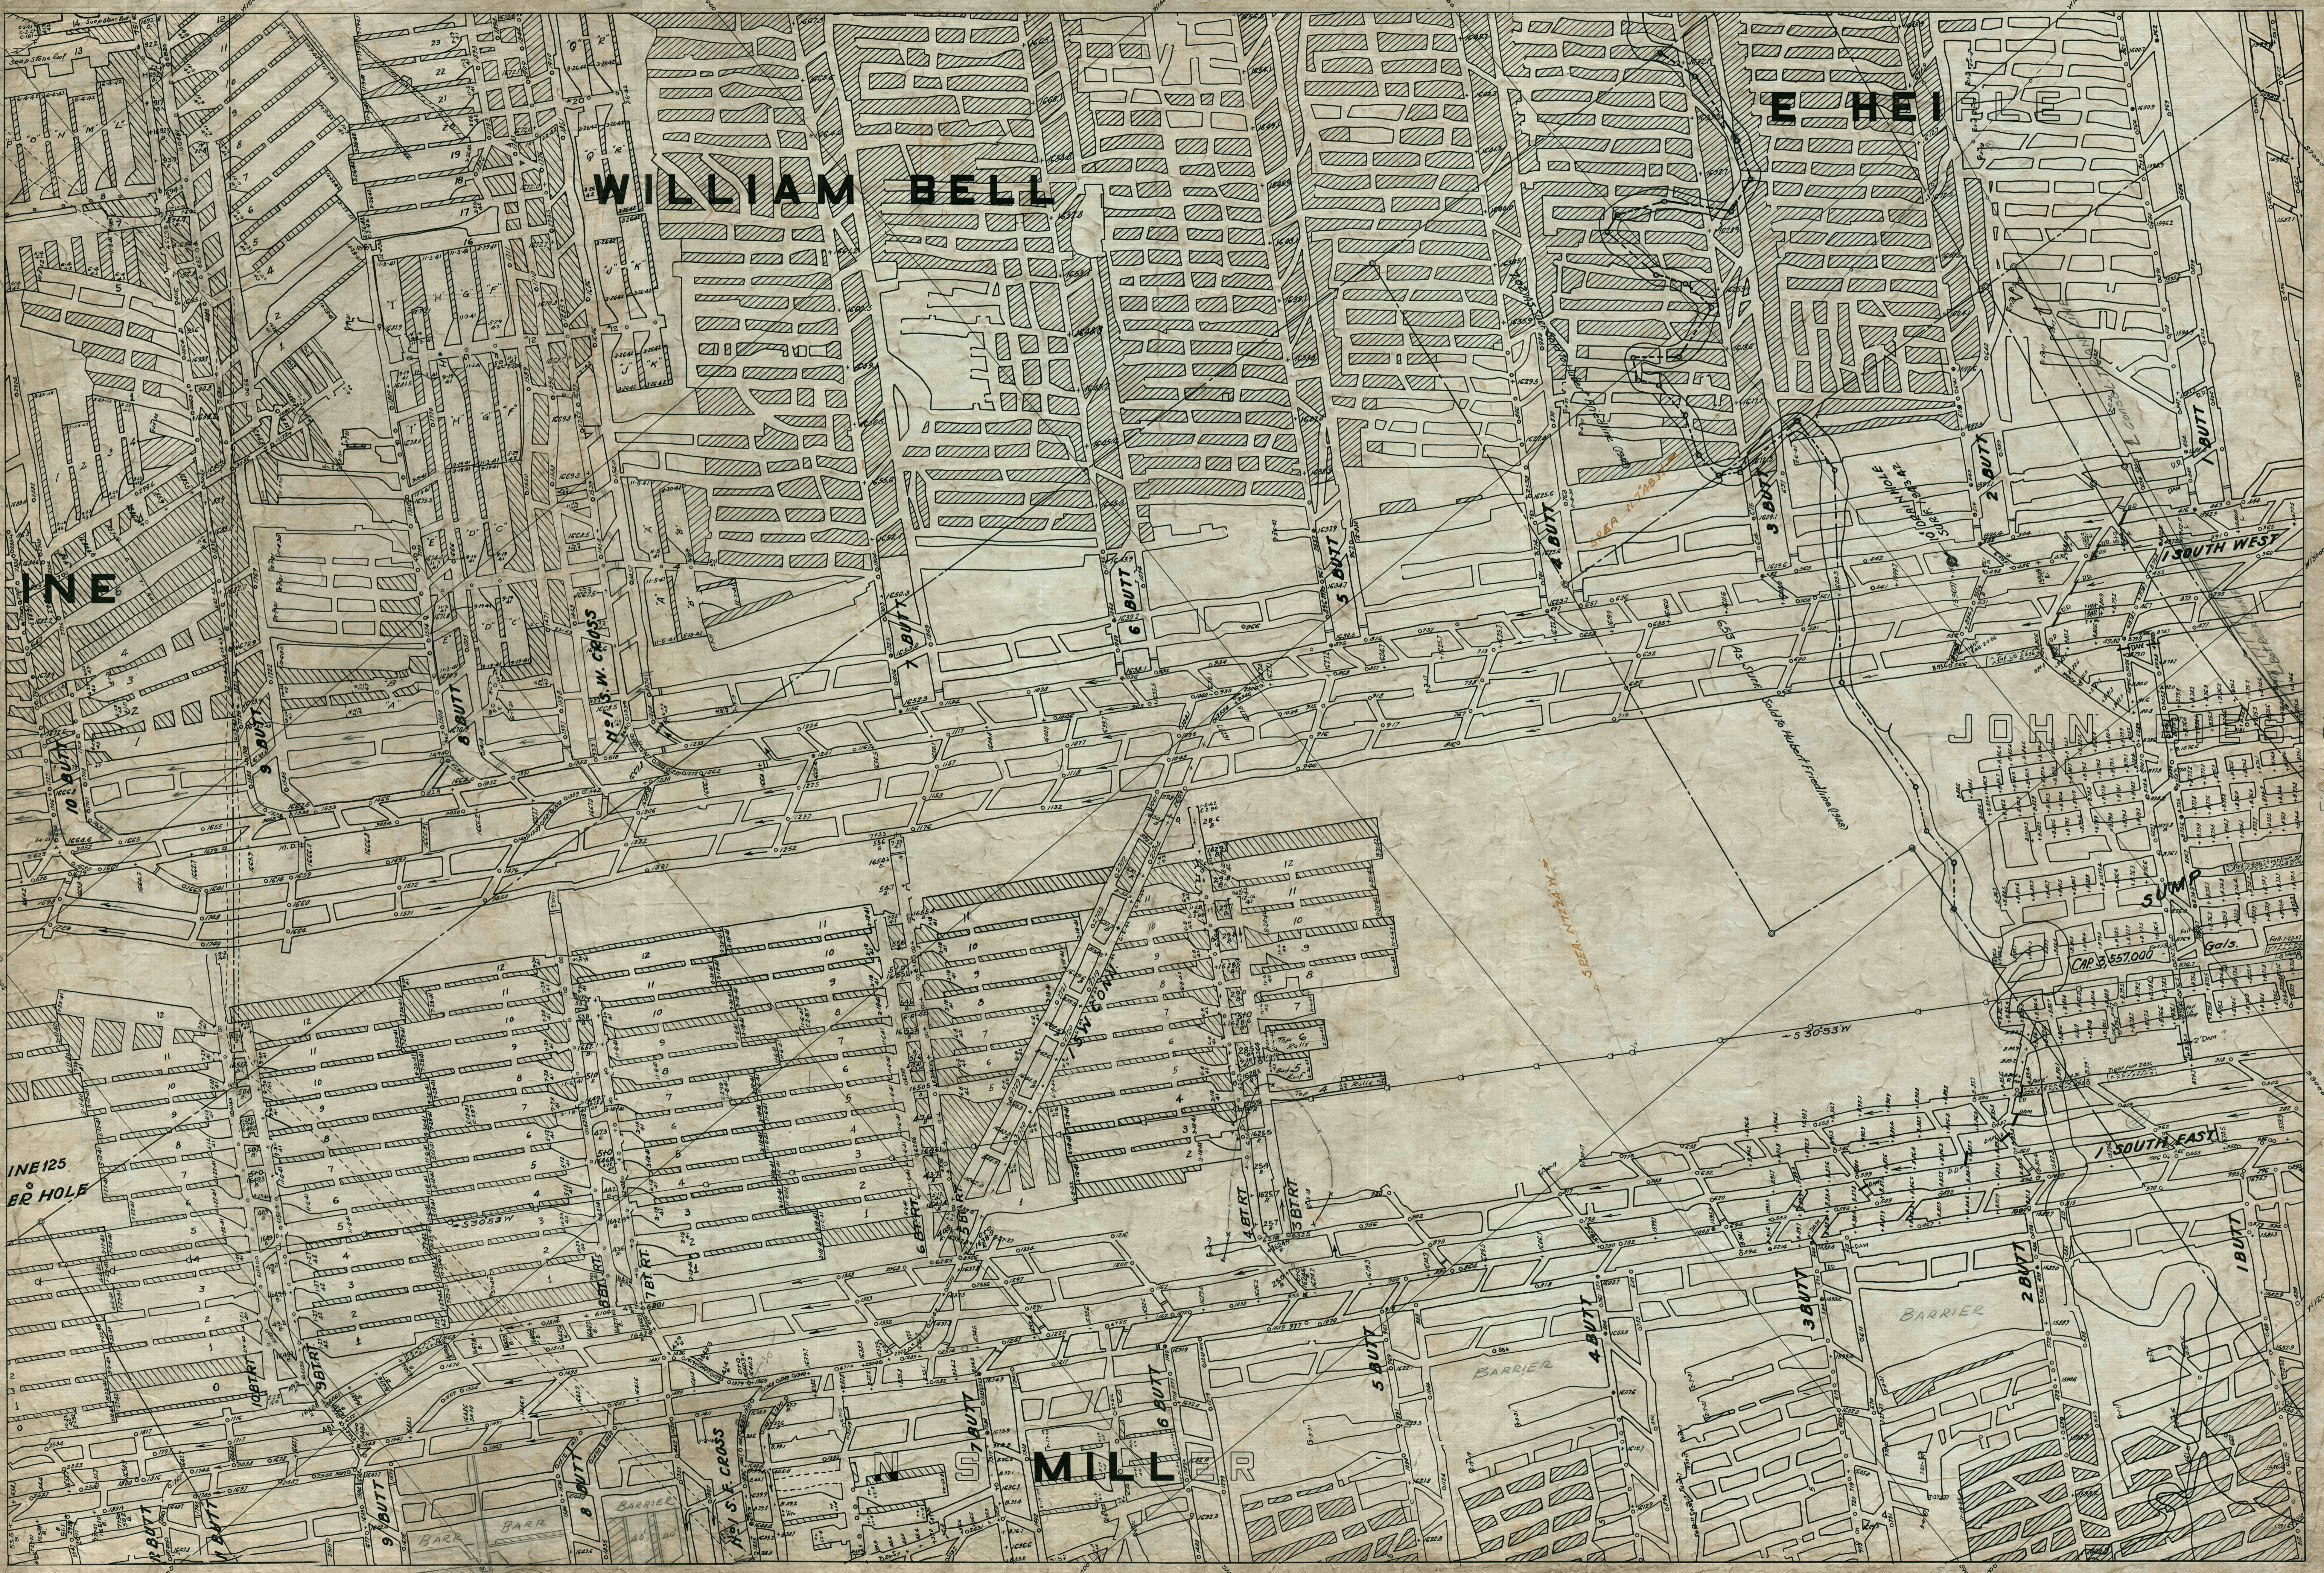

INE 125  
ER HOLE

WILLIAM BELL

EHEI

INE

JOHN

MILL

CHP 557,000  
Gals.

1 SOUTH EAST

MINE 123 "E" #16

Fit to 17