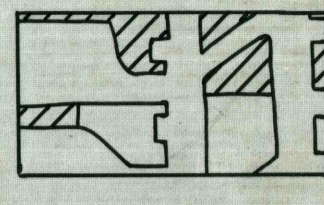


LEGEND:-


 MINED PRIOR TO 7-1-12

 NONE
PROPOSED MINING FOR NEXT 6 MONTHS

ROADS
Elev. 1860 etc. = ELEVATION OF SURFACE
LEVEL DATUM IS U.S.G.S.
CONTOURS ARE OF BOTTOM OF AFT "C prime" SEAM COAL

UNLESS OTHERWISE NOTED, MINING SHOWN IS IN PROPERTY OWNED AND OPERATED BY CONSOL. COAL CO., SOMERSET, PA.

D. W. Curtis
MINING ENGINEER

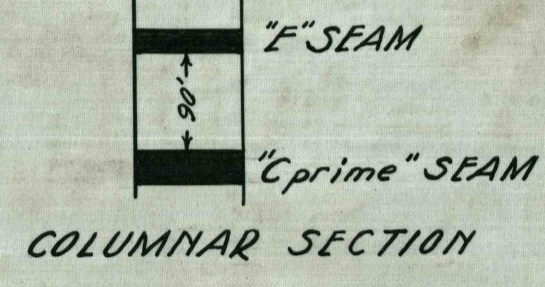

CONSOLIDATION COAL CO.
"C prime" SEAM COAL MINING OPERATION
ALONG ROUTE NO 269
SCALE 1"=100' APRIL 1938 ENG. DEPT. SOMERSET, PA.