



LEGEND:-

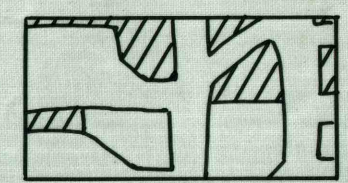

MINED PRIOR TO 6-30-38

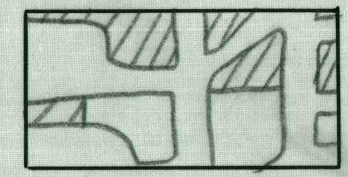

PROPOSED MINING FOR NEXT 6 MONTHS


ROADS

Elev. 1960 etc. = ELEVATION OF SURFACE

LEVEL DATUM IS U.S.G.S.


CONTOURS ARE OF BOTTOM OF 4 FT. "C_{pr}" SEAM COAL

UNLESS OTHERWISE NOTED, MINING SHOWN IS IN PROPERTY OWNED AND OPERATED BY CONSOL. COAL CO., SOMERSET, PA.

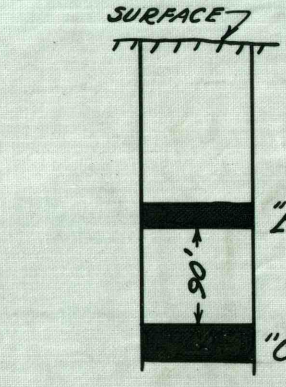

COLUMNAR SECTION

F. Marten
MINING ENGINEER

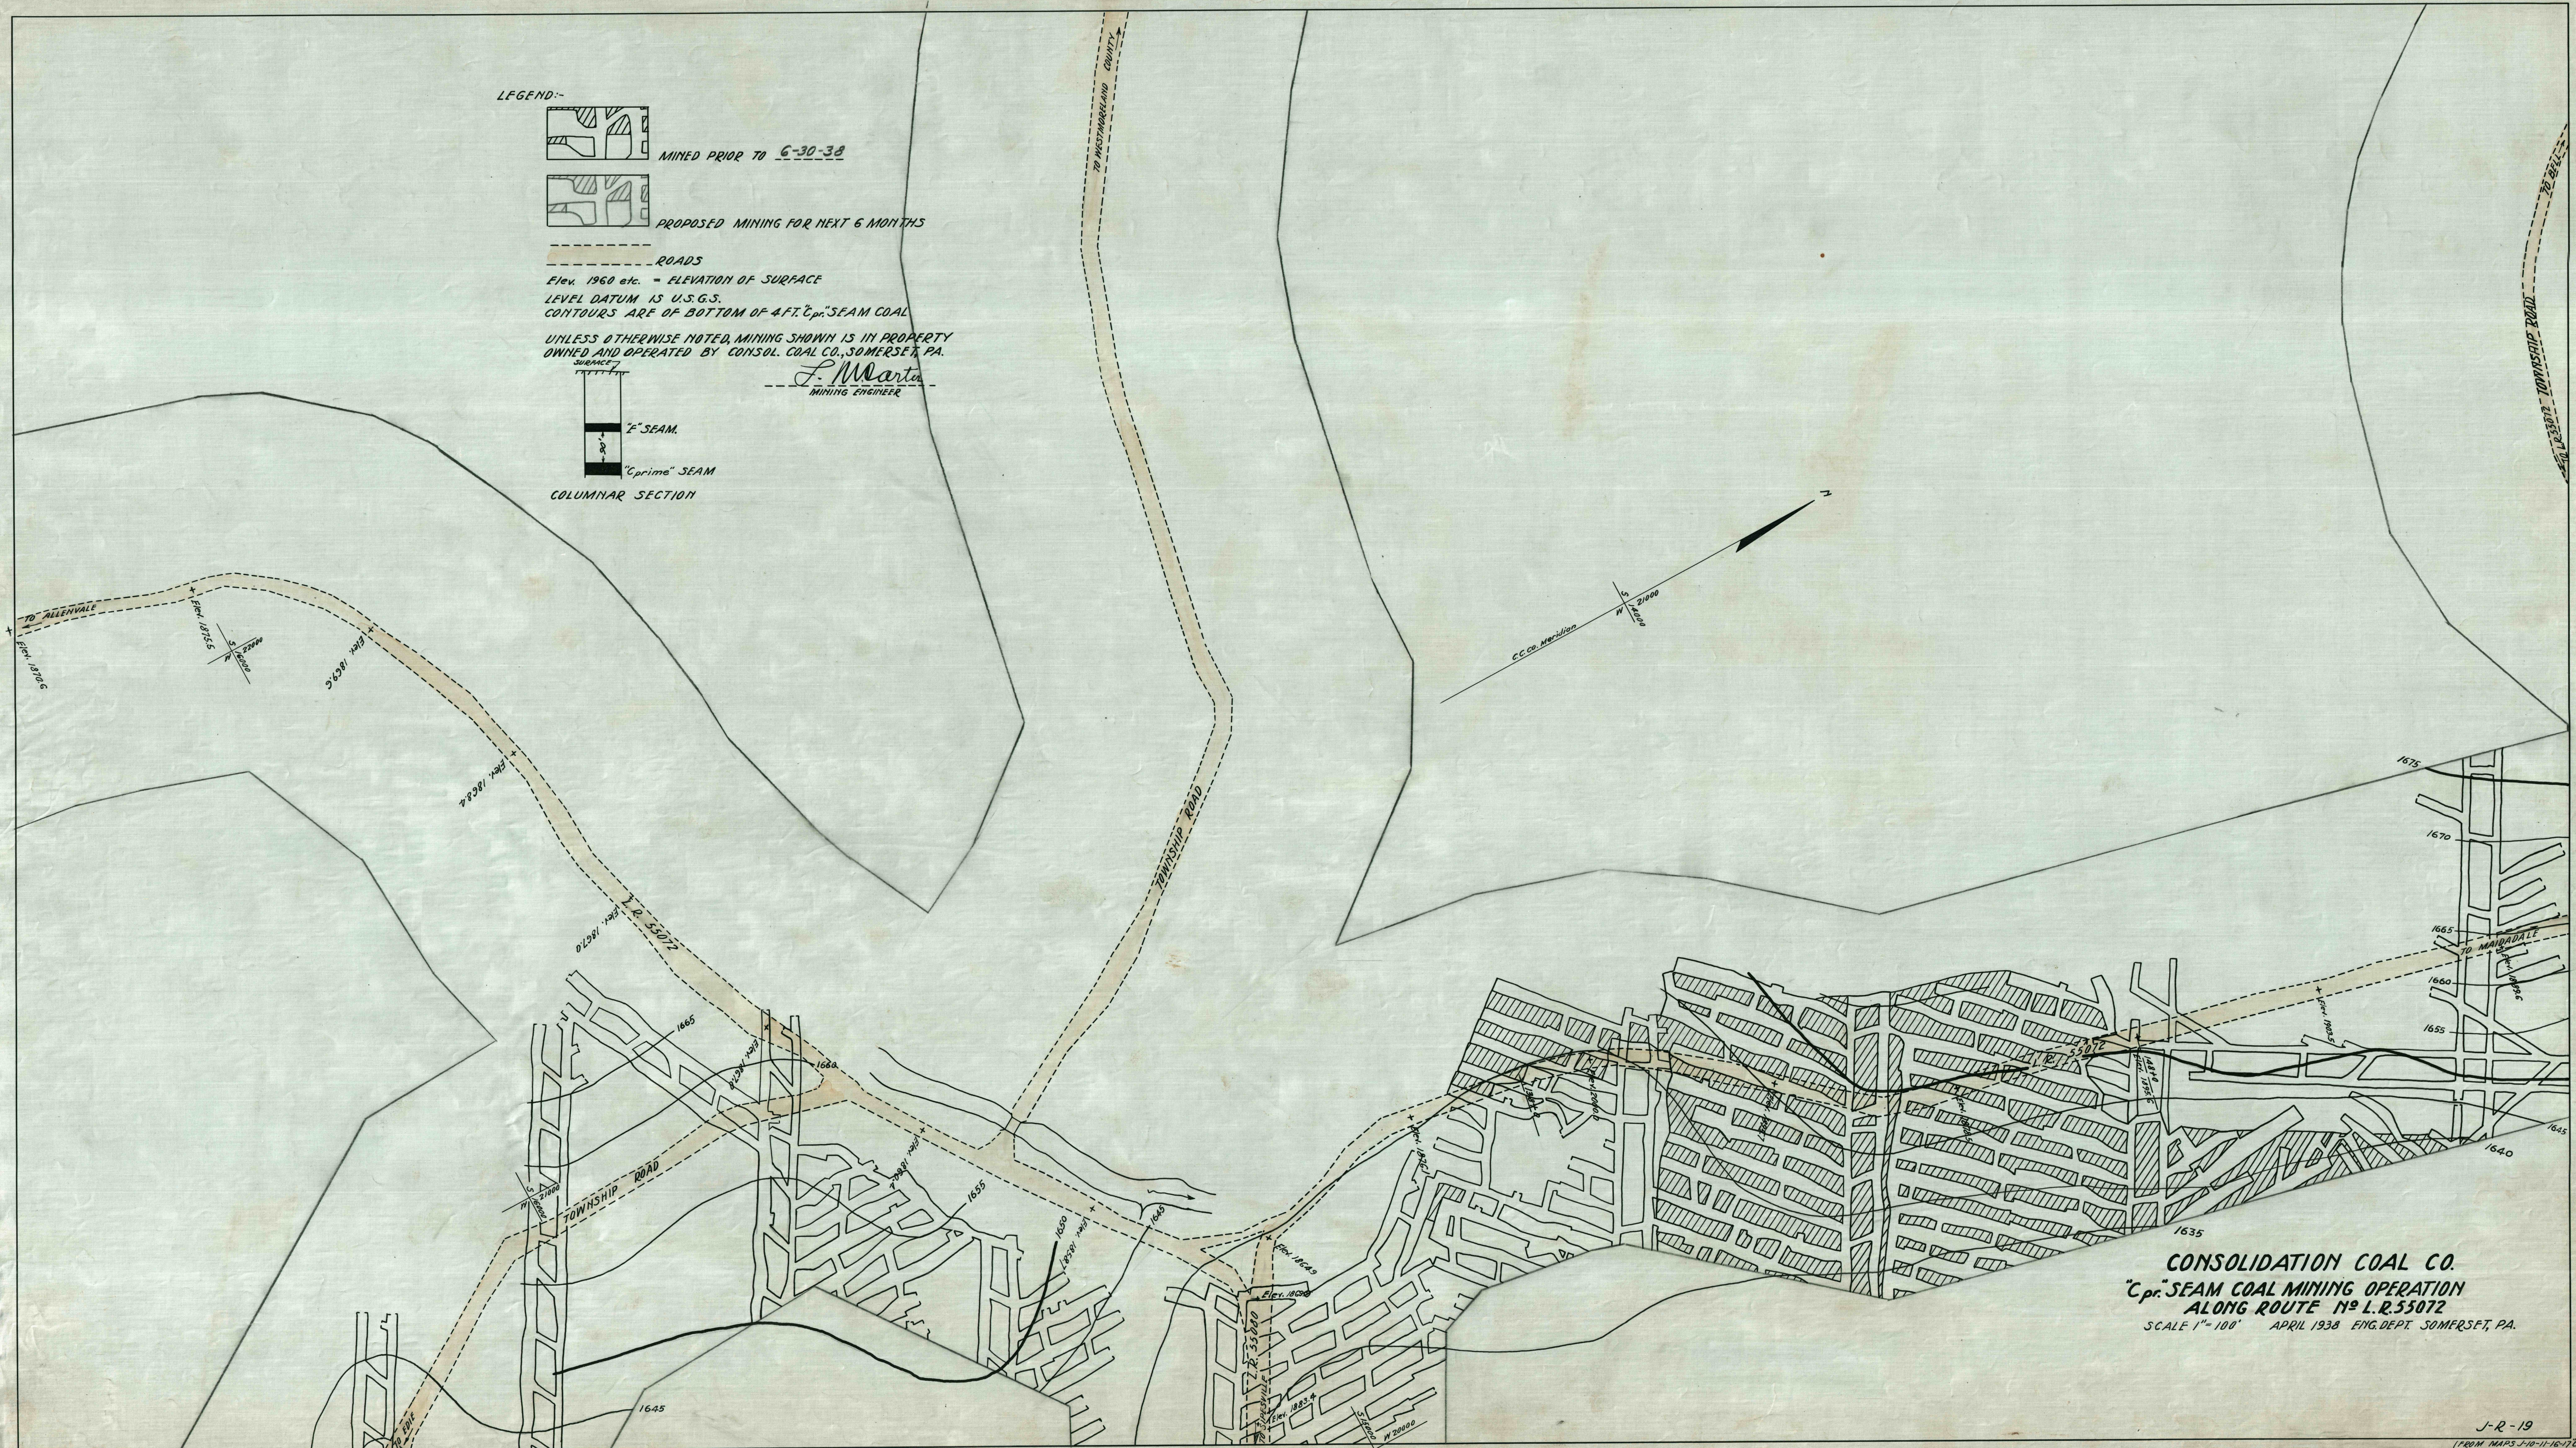

CONSOLIDATION COAL CO.
"C_{pr}" SEAM COAL MINING OPERATION
ALONG ROUTE NO L.R. 55072
 SCALE 1" = 100' APRIL 1938 ENG. DEPT. SOMERSET, PA.