

ELI A. WILLIAMS
10.00 AC.
P.C. CO. SURF.

RECONVEYED TO P.C.C.O. BY
LEONARD GOLDSTEIN
0.833 AC. 8-8-52
713 2184

RECONVEYED TO P.C.C.O. BY
ERNEST TYLER ET AL TRUSTEES
MEN'S COMMUNITY CLUB 3-10-52

P.C.C.O. TO
J. C. BLACK & WINSTON CLEMENT
0.974 AC. 12-27-48

P.C.C.O. TO
WILLIAM HANDY
1.672 AC. 12-23-48


ANDERSON JEFFRIES
115.35 AC.
P.C. CO. SURF.

P.C.C.O. TO
ERNEST TYLER et al
6.258 AC. 12-23-48

P.C.C.O. TO
FRED ASTLE et al
17.936 AC. 3-10-48
(4301)

Hold for Crescent
Garb Dump

PIKE RUN
VESTA COAL CO.

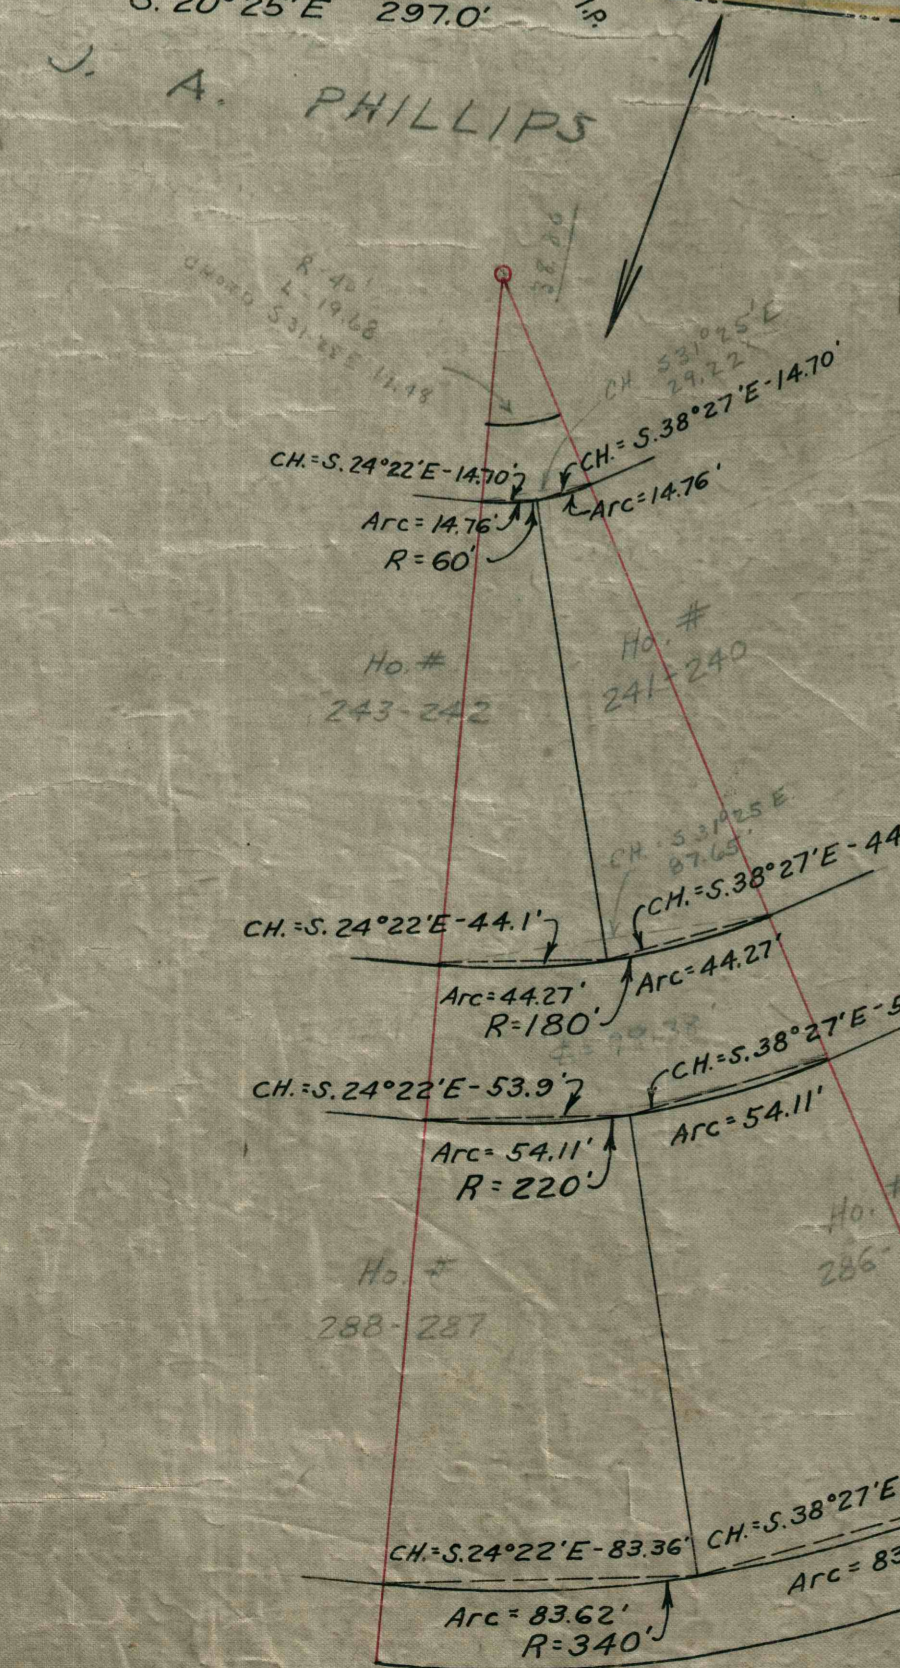

PITTSBURGH COAL CO.
PROPOSED PLAN OF LOTS
AT
~CRESCENT MINE~
ON THE ANDERSON JEFFRIES TRACT
SCALE 1"=100'
NOV. 3, 1927

Right of way for water lines
shown. P.C.C.O. to 5-29-46
Subdiv. - See Agreement 5-29-46

Tab. J-3615
A-10377
For Recorded Plan See A-10355