


FILE 78 54.21

2

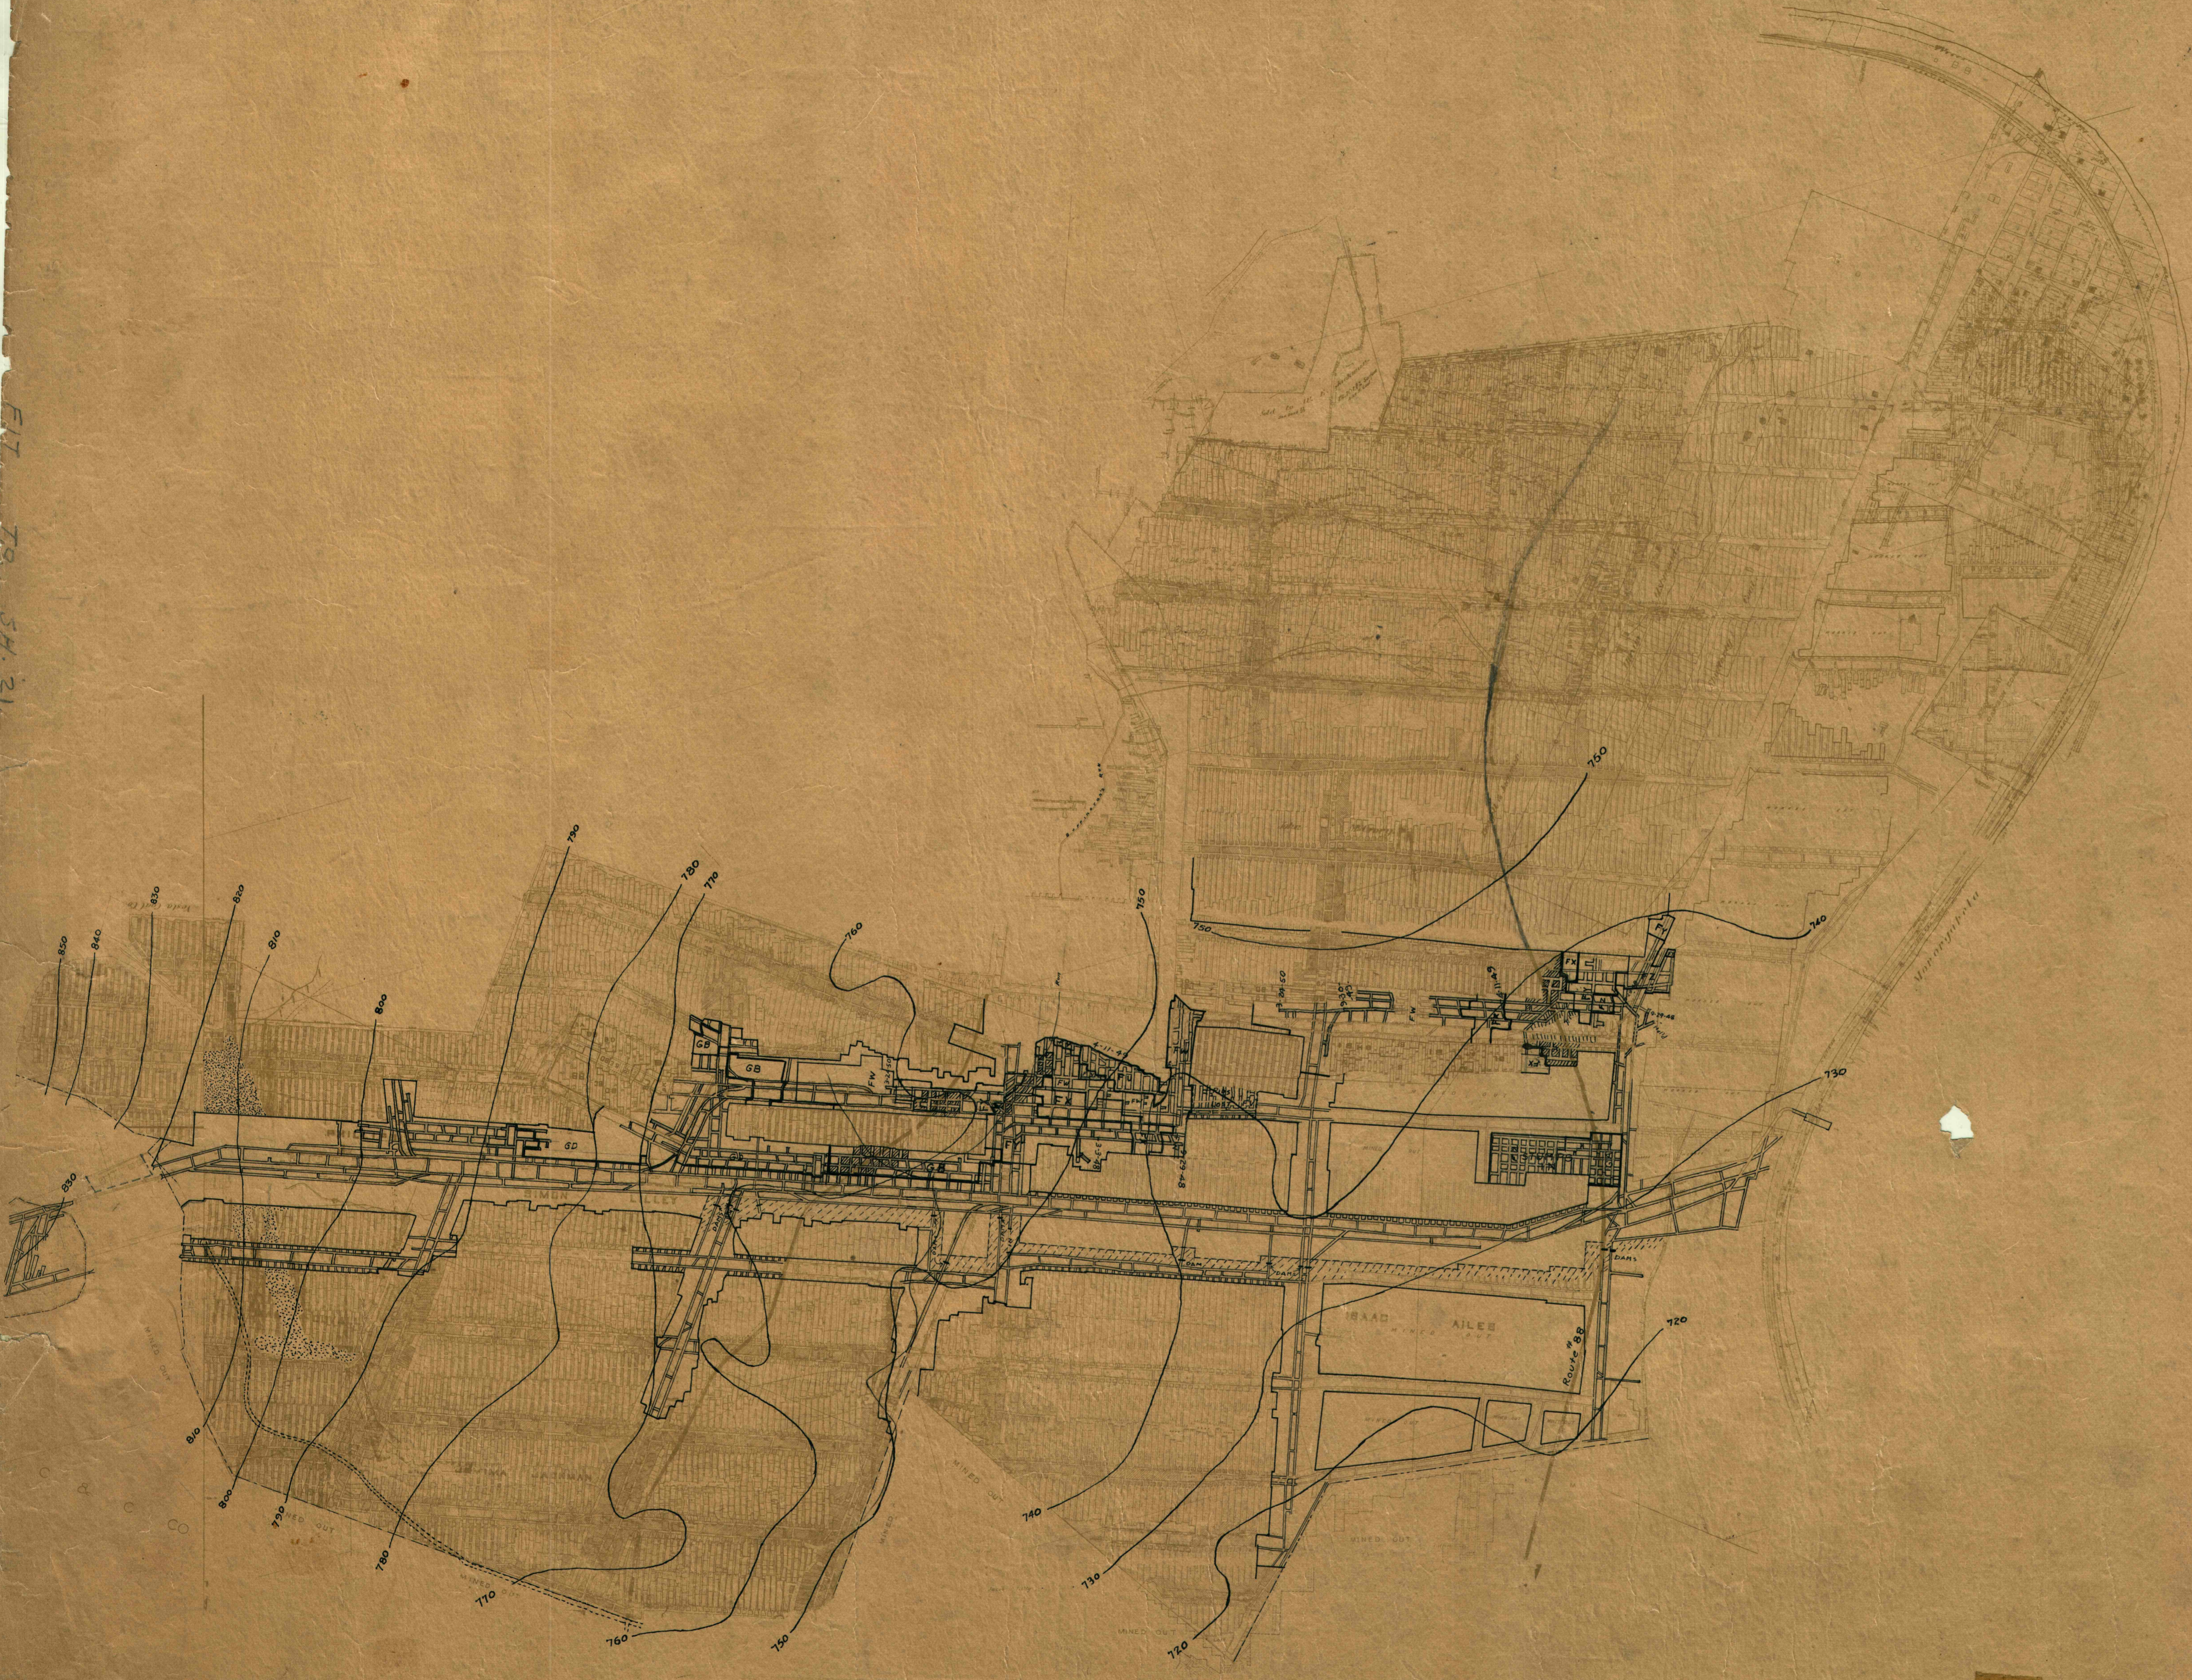

